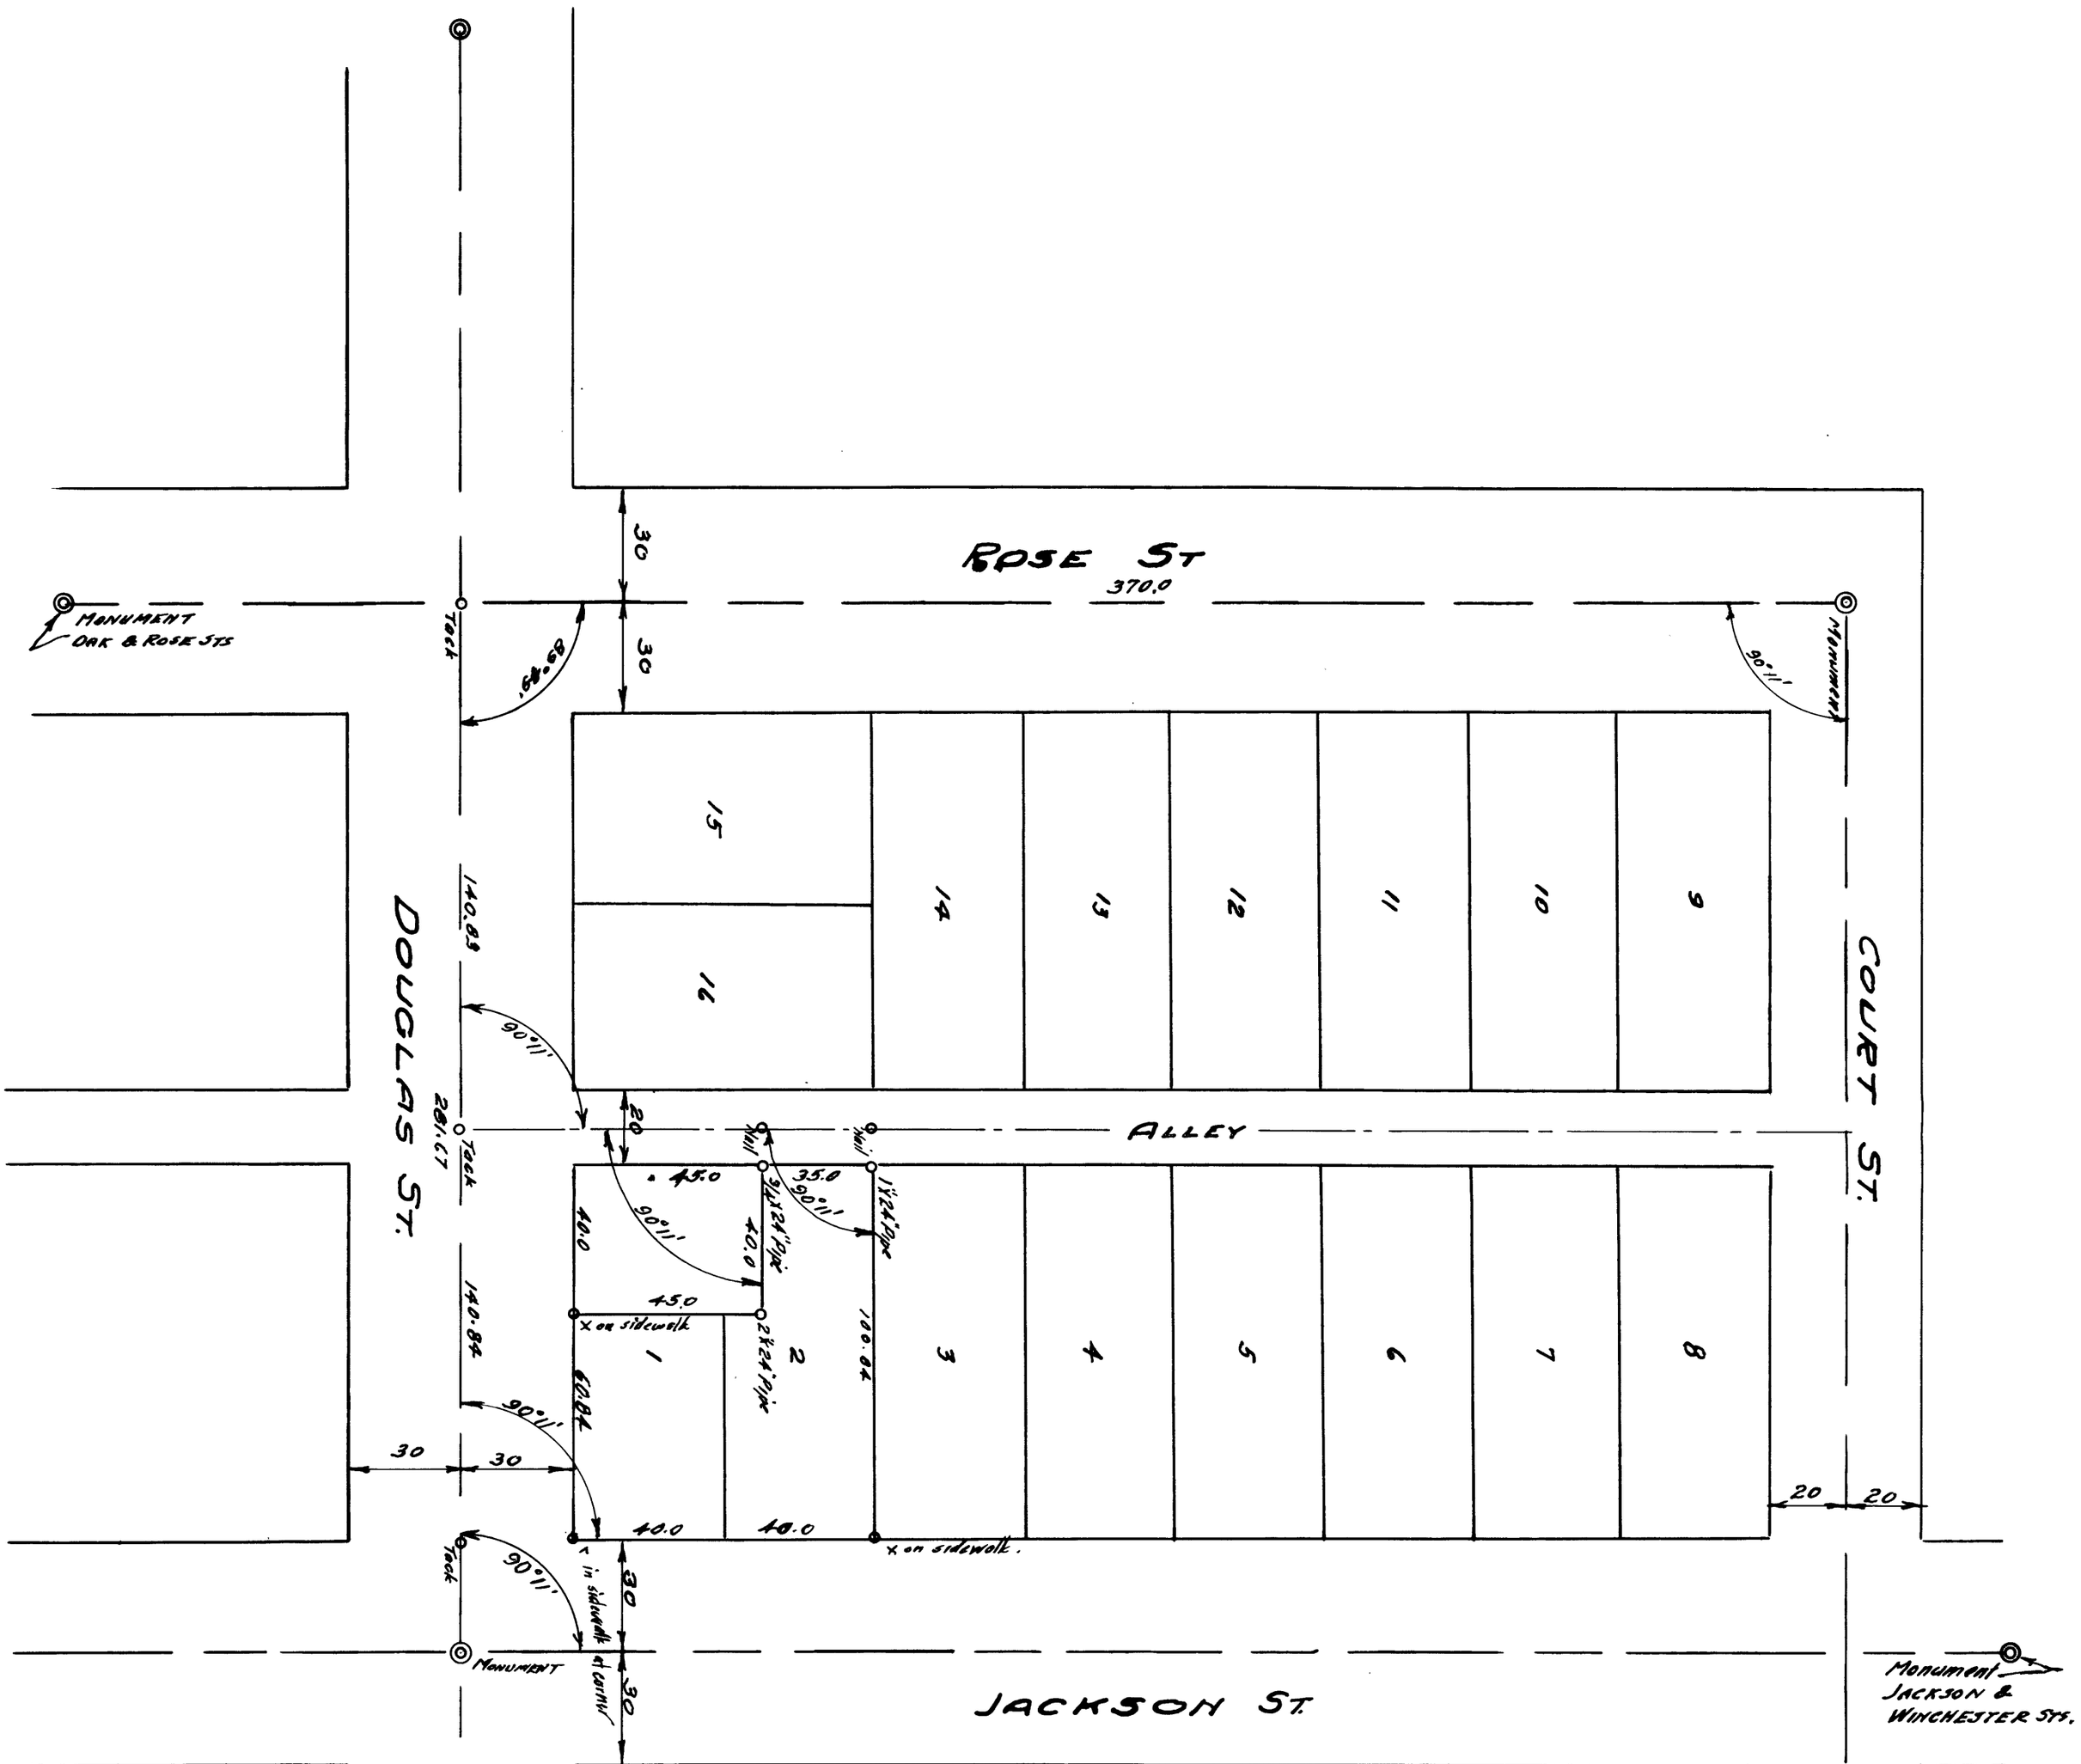

COUNTY SURVEYOR'S OFFICE
DOUGLAS COUNTY OREGON

LOTS 1-2 BLOCK 12
ROSEBURG, OREGON.

N. E. RICHARDSON DEPUTY COUNTY SURVEYOR
NOV. 12, 1945
SCALE 1" = 40'

REGISTERED
OREGON
LAND SURVEYOR

N E Richardson
JULY 7, 1944
N. E. RICHARDSON
35

COUNTY SURVEYORS FILE DATA
DO NOT REMOVE FROM OFFICE

FILE 51 DRAWER 38