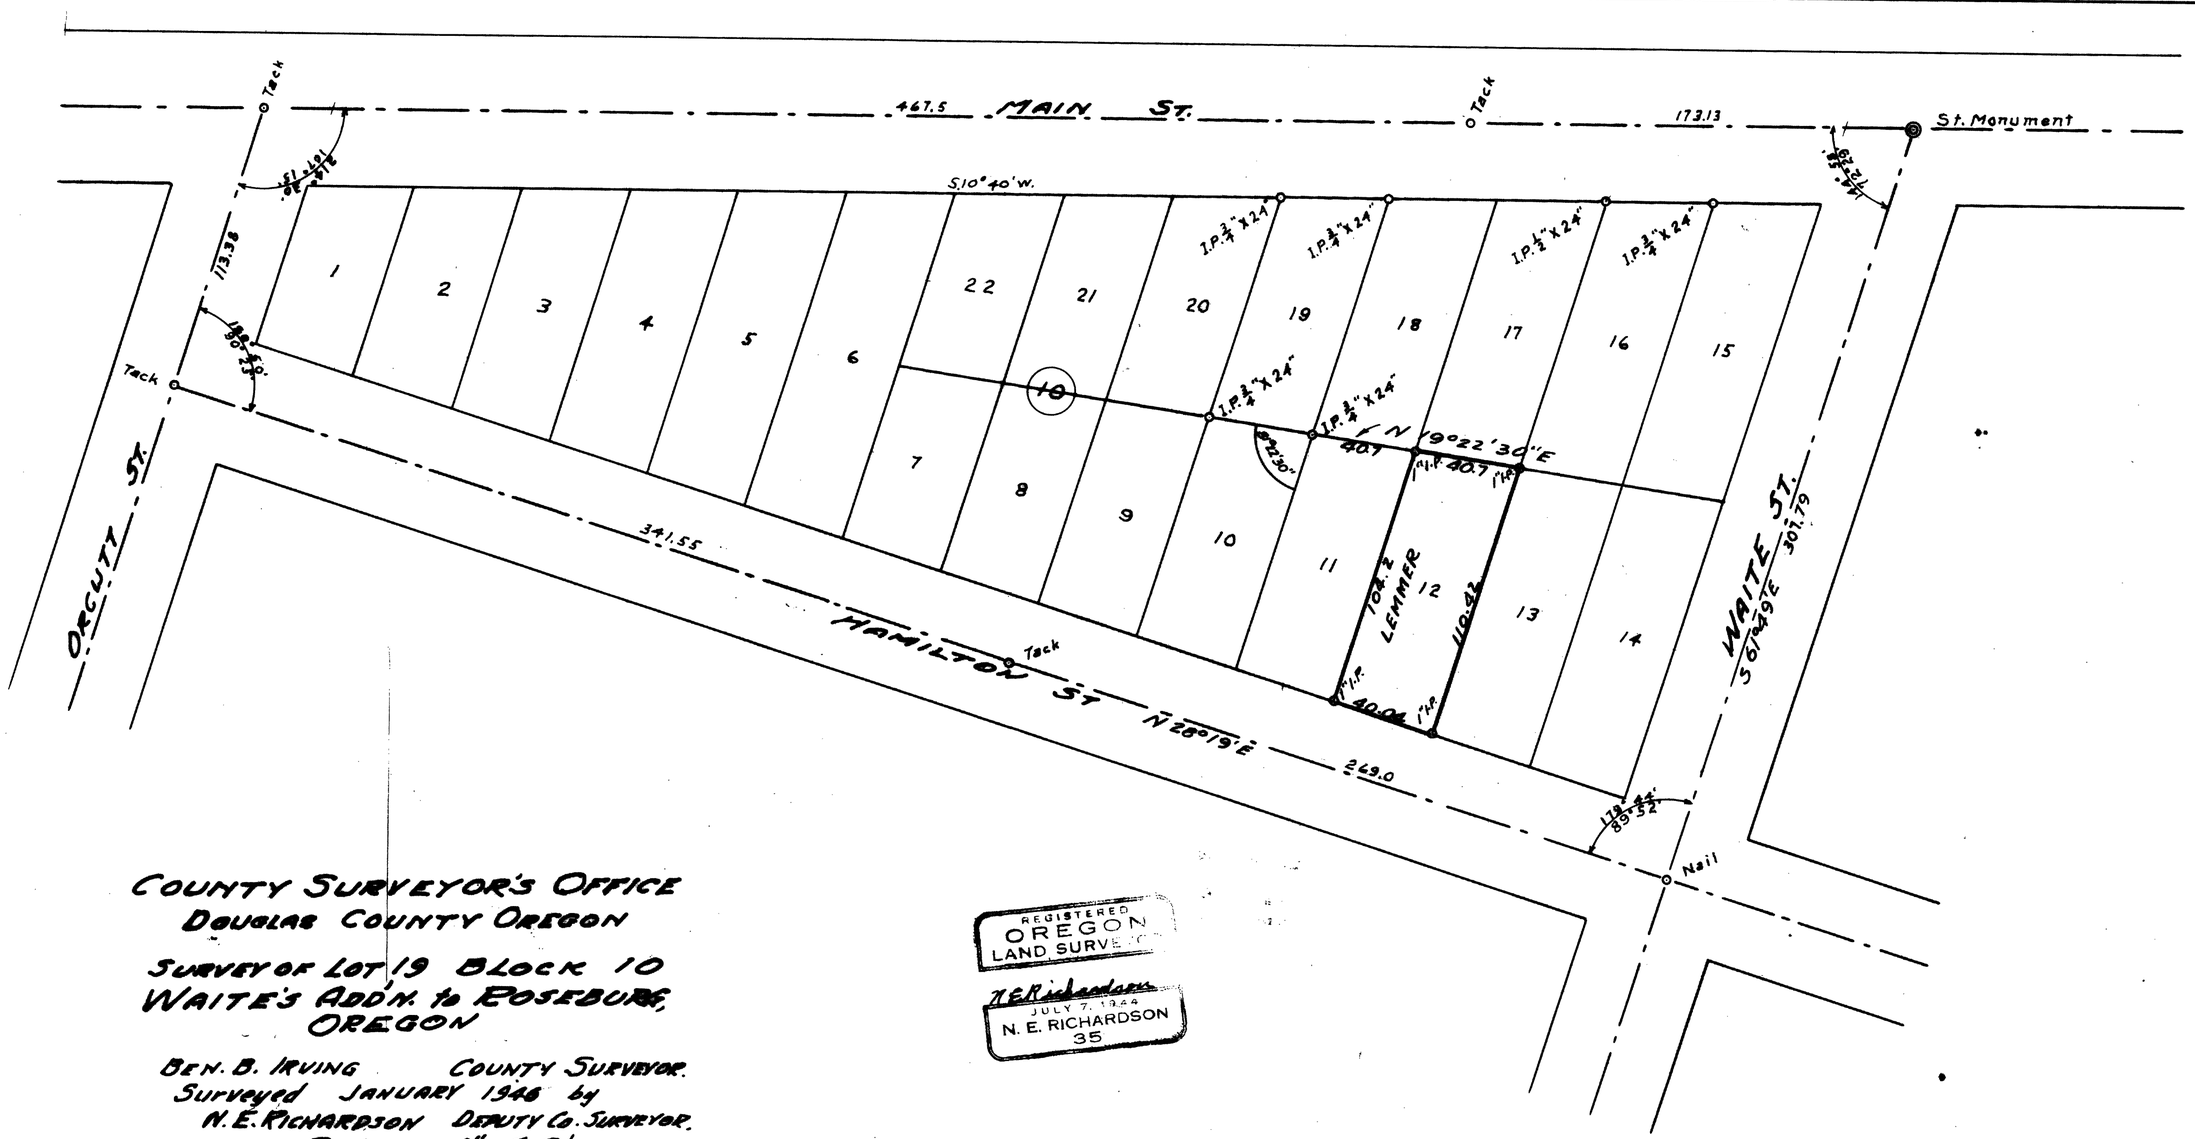

COUNTY SURVEYOR'S OFFICE
DOUGLAS COUNTY OREGON

SURVEY OF LOT 19 BLOCK 10
WAITE'S ADD'N. to ROSEBURG,
OREGON

BEN. B. IRVING COUNTY SURVEYOR.
Surveyed JANUARY 1946 by
N. E. RICHARDSON DEPUTY CO. SURVEYOR.
SCALE 1"=40'

REGISTERED
OREGON
LAND SURVEYOR

N.E. Richardson
JULY 7, 1944
N. E. RICHARDSON
35

COUNTY SURVEYORS FILE DATA
DO NOT REMOVE FROM OFFICE

P FILE 52-DRAWER 38