COUNTY SURVEYORS FILE DATA
DO NOT REMOVE FROM OFFICE

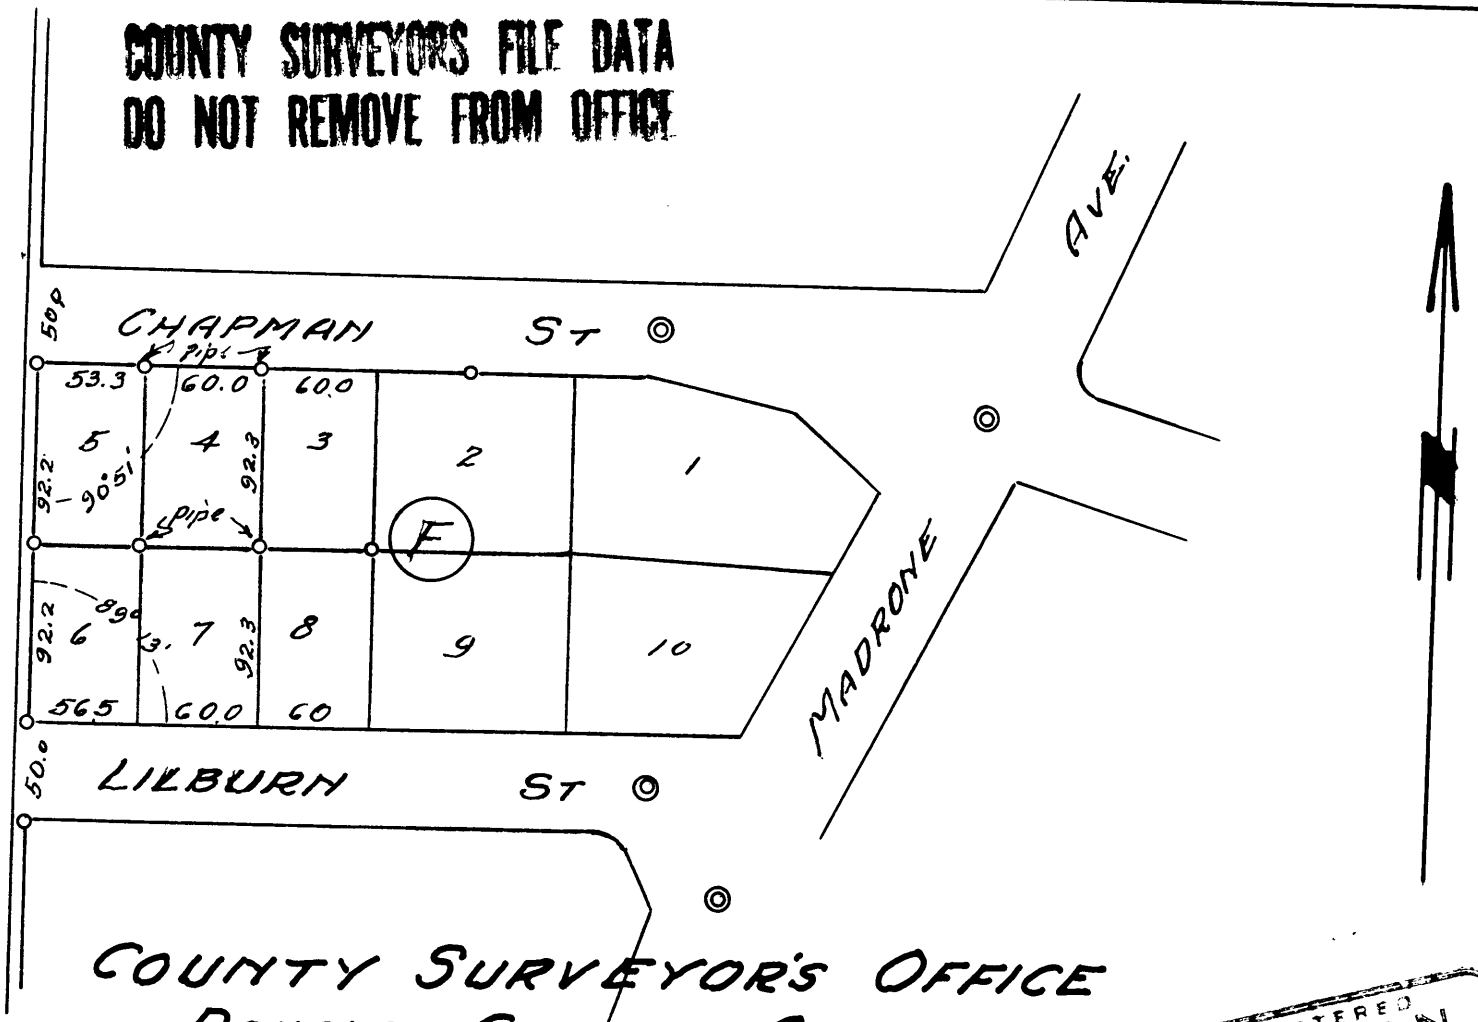

COUNTY SURVEYOR'S OFFICE
DOUGLAS COUNTY OREGON

LOT 4 BLOCK F | LAUREL WOOD
ROSEBURG OREGON

REGISTERED
OREGON
LAND SURVEYOR

N.E. Richardson
JULY 7 1941
N. E. RICHARDSON
35

BEN. B. IRVING. COUNTY SURVEYOR.
Surveyed Feb 26 1946 by
N.E. RICHARDSON Deputy County Surveyor.
SCALE 1" = 100'

38-64