COUNTY SURVEYORS FILE DATA
DO NOT REMOVE FROM OFFICE

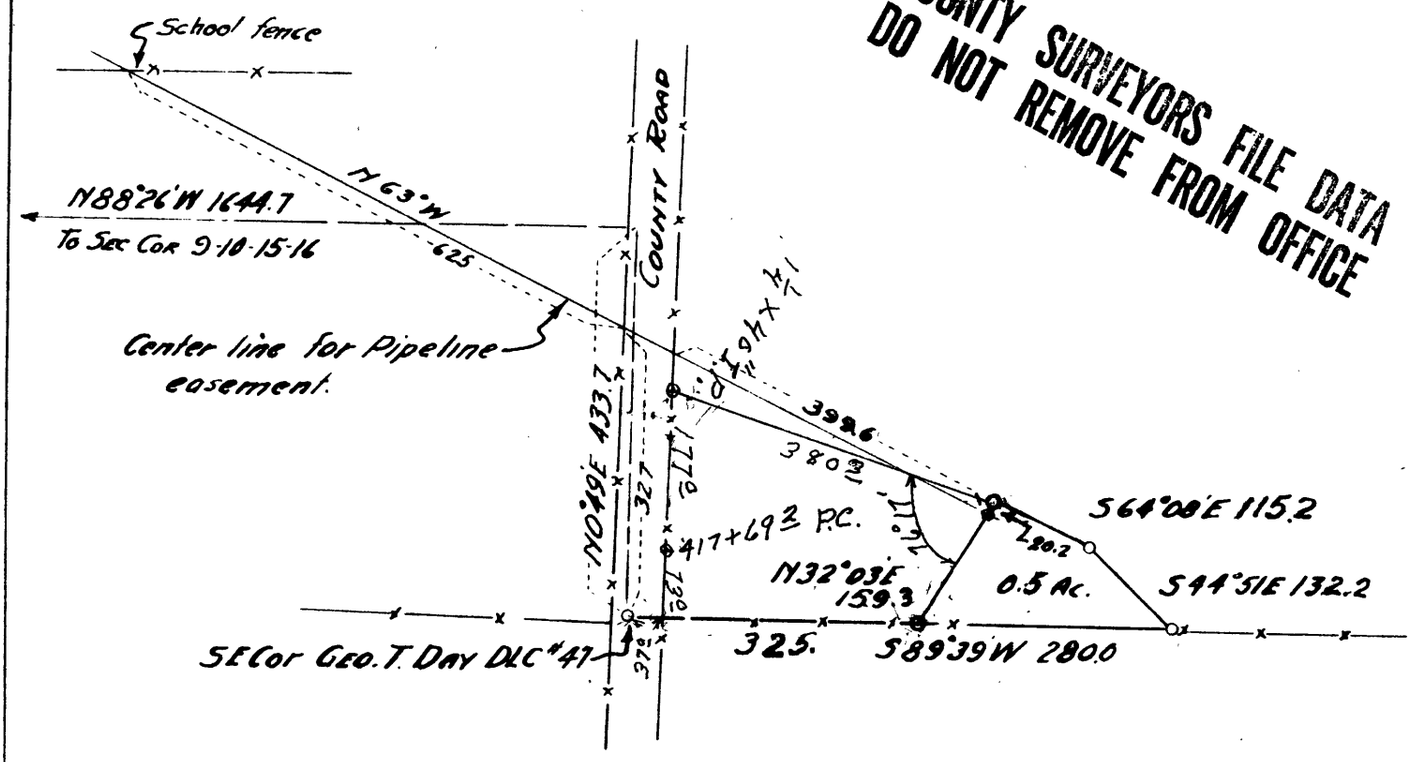

SCALE 1" = 200'

N

Jan. 28-46
N.E.R.
Les

TRACT FOR SPRING
AND
PIPELINE EASEMENT
DAYS CREEK SCHOOL
DIST. NO 15 & UNION HIGH 10
IN
SEC. 10 & 15 T30S R4W
DOUGLAS COUNTY

BEN. B. IRVING. DEPUTY COUNTY SURVEYOR
ROSEBURG, ORE.
NOVEMBER 2, 1934.

C.S. 38/74-1

FILE 74 \ DRAWER 38