COUNTY SURVEYORS FILE DATA
DO NOT REMOVE FROM OFFICE

COUNTY SURVEYOR'S OFFICE
DOUGLAS COUNTY OREGON

LOT 14 BLOCK 51 RAILROAD ADDITION
ROSEBURG, OREGON.

REGISTERED
OREGON
LAND SURVEYOR
N E Richardson

BEN. B. IRVING COUNTY SURVEYOR.
Surveyed FEB. 1946 by
N. E. RICHARDSON Deputy County Surveyor
SCALE 1" = 40'

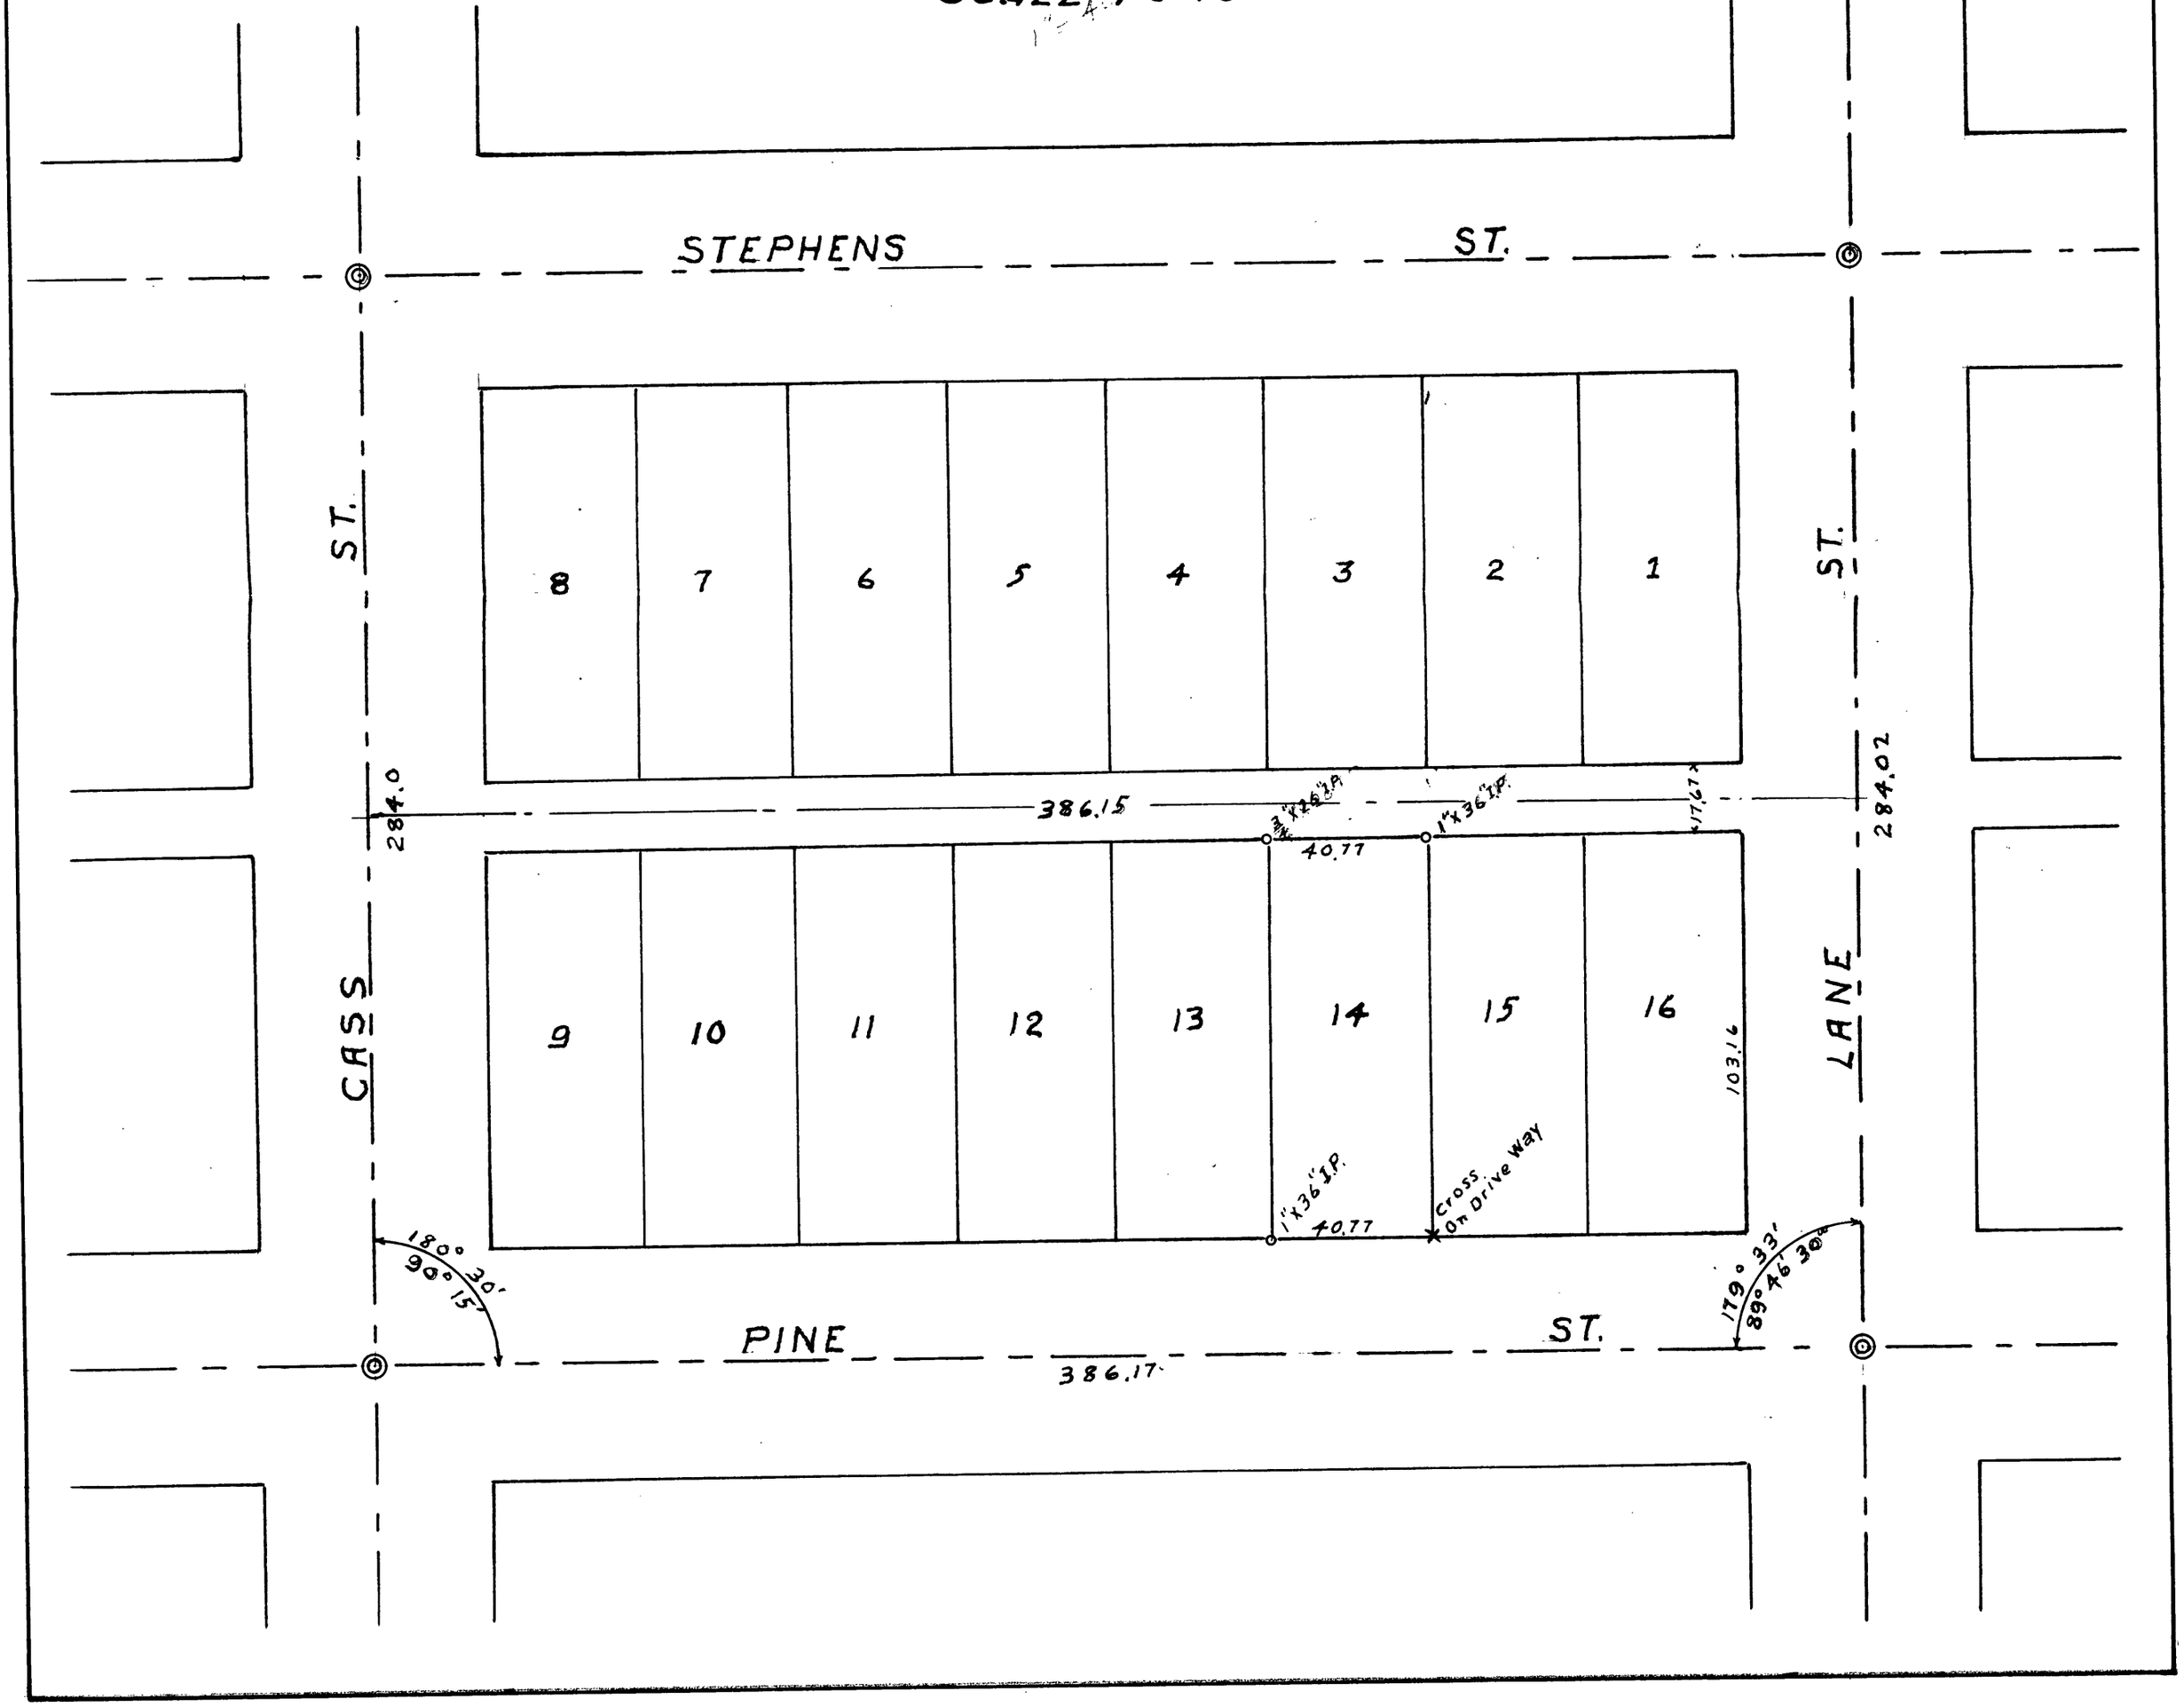

FILE 78 DRAWER 38