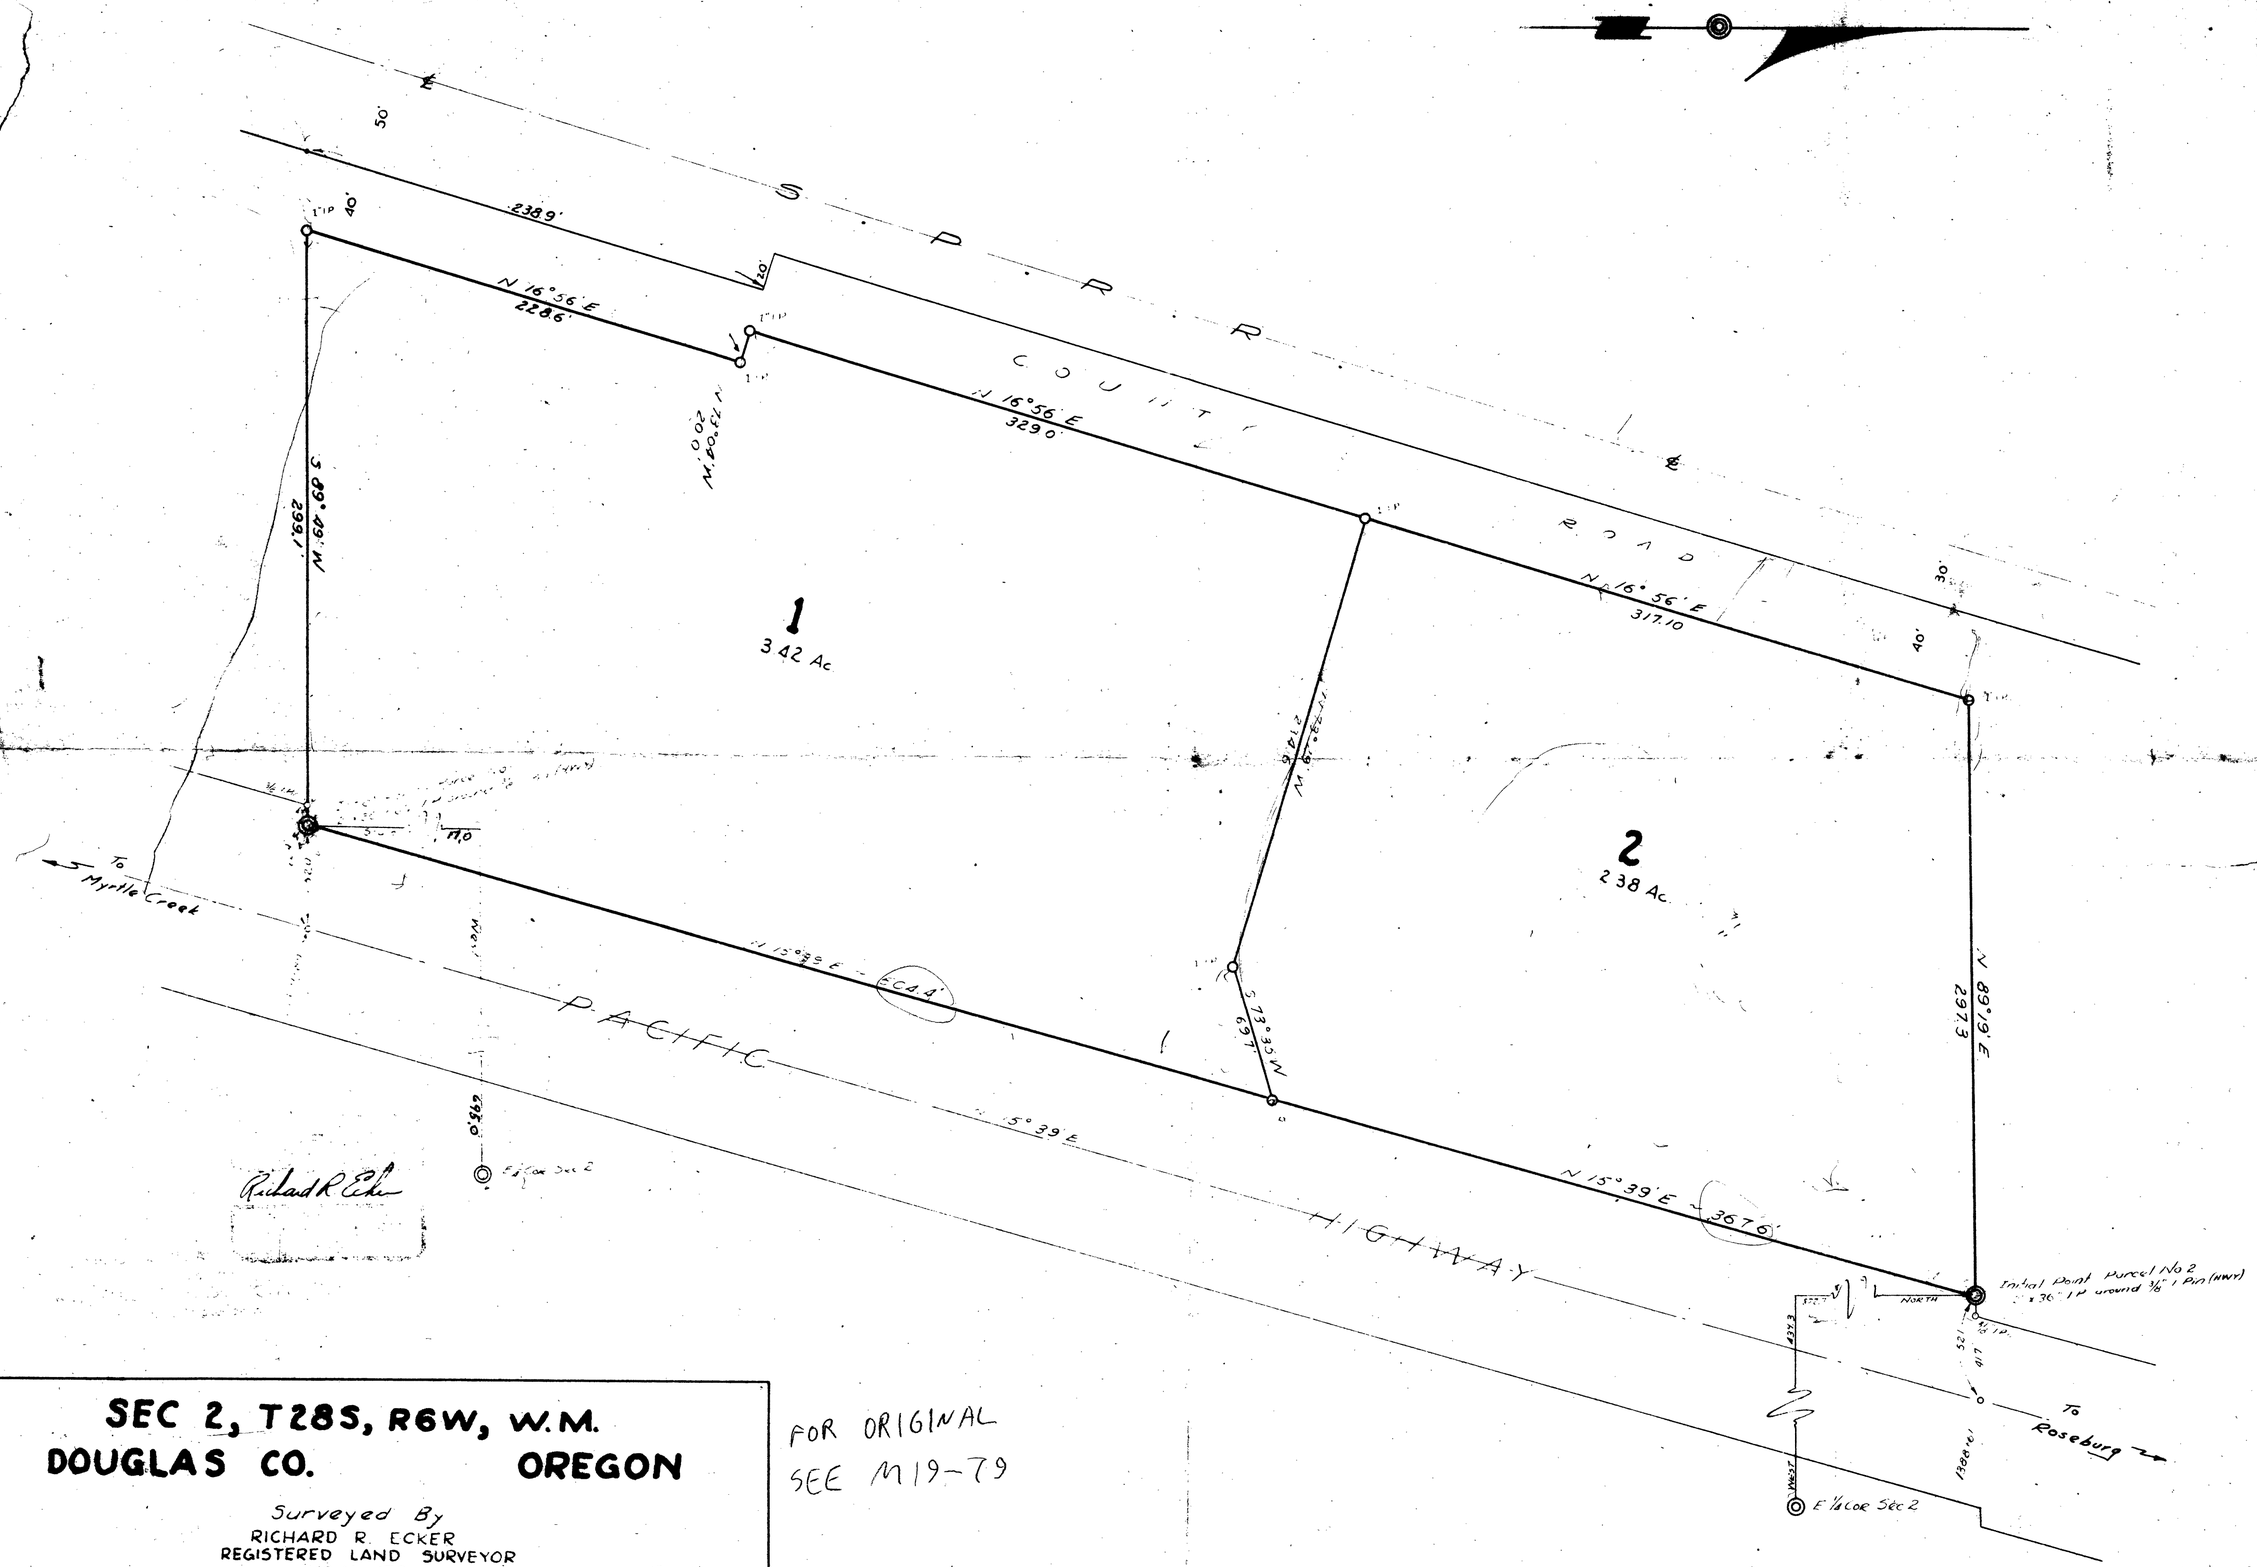

SEC 2, T28S, R6W, W.M.
DOUGLAS CO. OREGON

Surveyed By
RICHARD R. ECKER
REGISTERED LAND SURVEYOR
LIC No. 158

MARCH 1946

SCALE: 1" = 50'

FOR ORIGINAL
SEE M19-79

C.S. File No. 4958