This is an 'OZALID' whiteprint
printed by
EN B IRVING, Registered Civil Engineer
Roseburg, Oregon

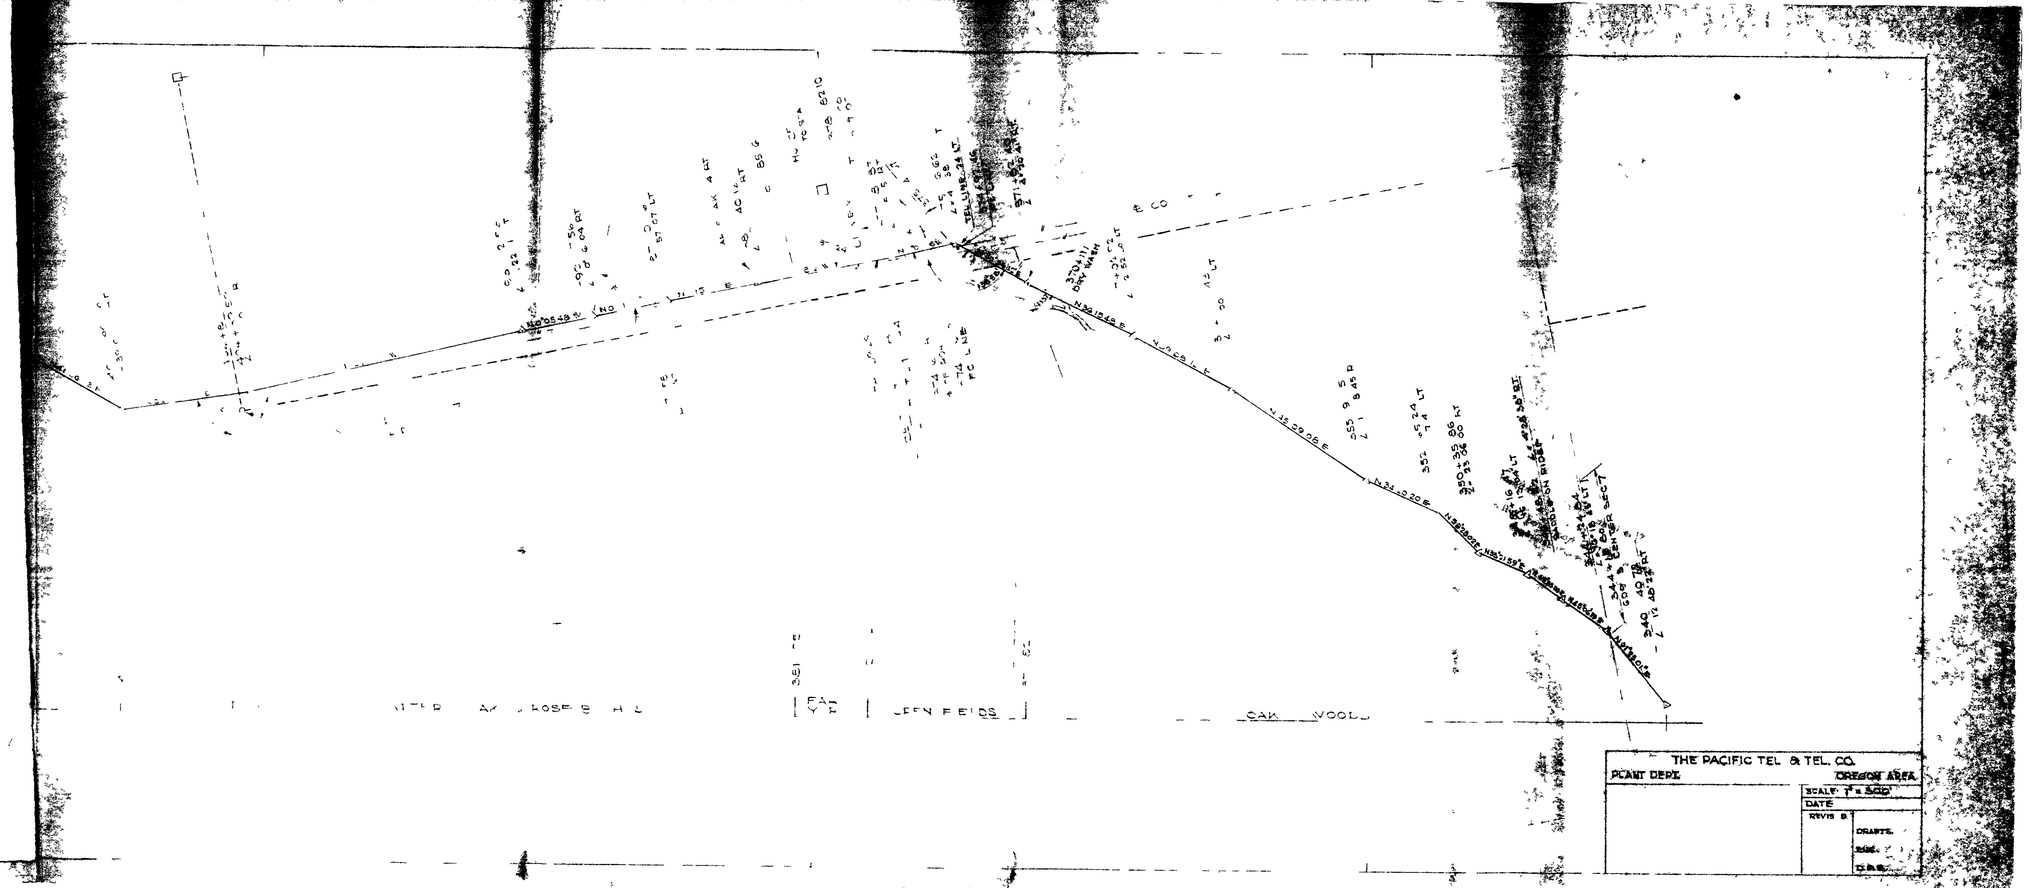
N 35°09'05" E
N 34°09'30" E
N 34°09'30" E
N 34°09'30