COUNTY SURVEYORS FILE DATA
DO NOT REMOVE FROM OFFICE

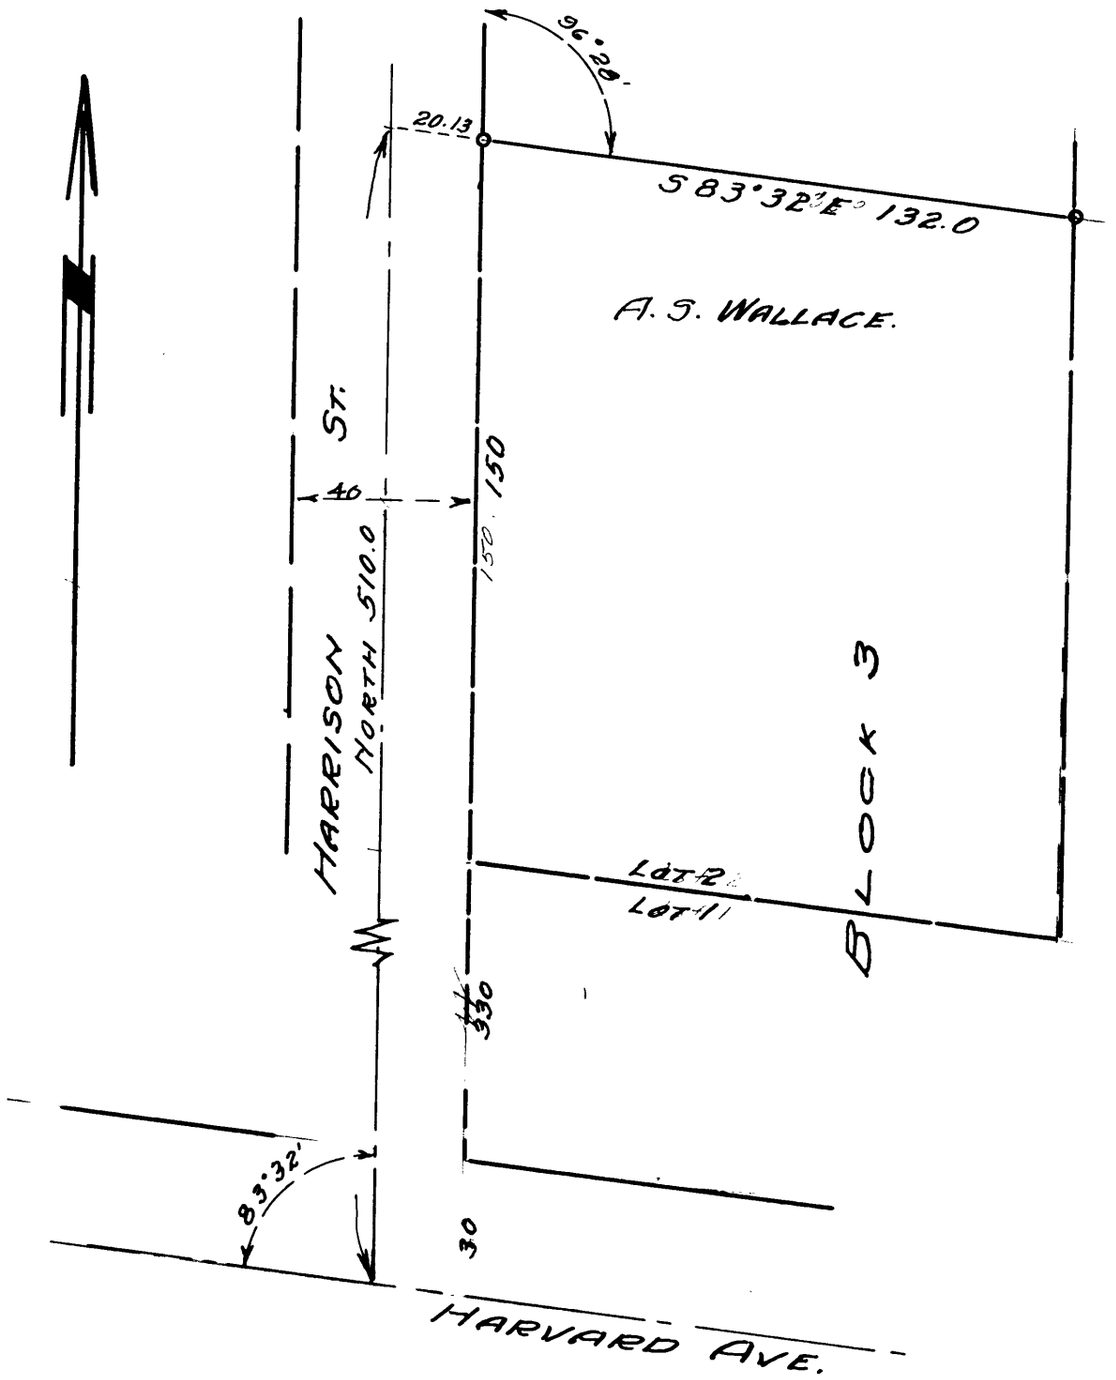

COUNTY SURVEYORS OFFICE
DOUGLAS COUNTY OREGON

NORTH LINE OF SOUTH 150 FT. BLOCK
BLOCK 3 A.J. BELLOWS FIRST ADDITION
TO WEST ROSEBURG.

REGISTERED PROFESSIONAL ENGINEER 240 OREGON NOV 8. 1919 BEN B. IRVING

BEN. B. IRVING County Surveyor
Surveyed August 1946

SCALE 1" = 40'

CS 38/205-3

FILE 205 DRAWER 38 (1)