C.S. FILE 38/208
M 18-20

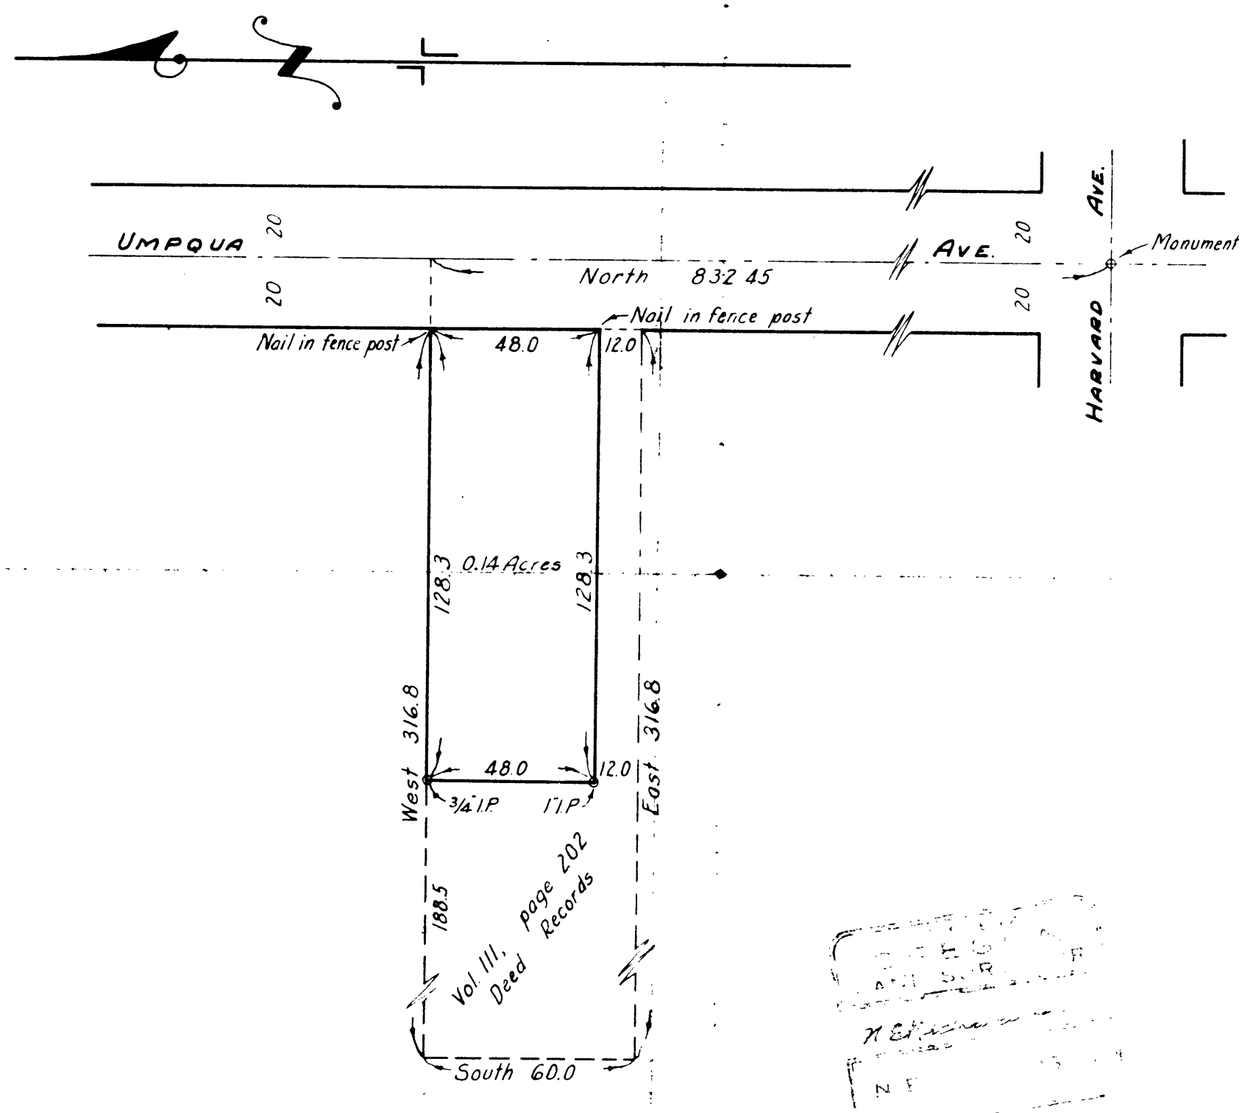

COUNTY SURVEYOR'S OFFICE
DOUGLAS COUNTY, OREGON

DEED DESCRIPTION FOR C.A. FALGOUT
UMPQUA AVE IN WEST ROSEBURG.

BEN. B. IRVING COUNTY SURVEYOR
SURVEYED BY
N.E. RICHARDSON DEPUTY COUNTY SURVEYOR.
SCALE 1" = 40' AUGUST 24, 1946.

C.S. File No. 38/208

F.M.D.