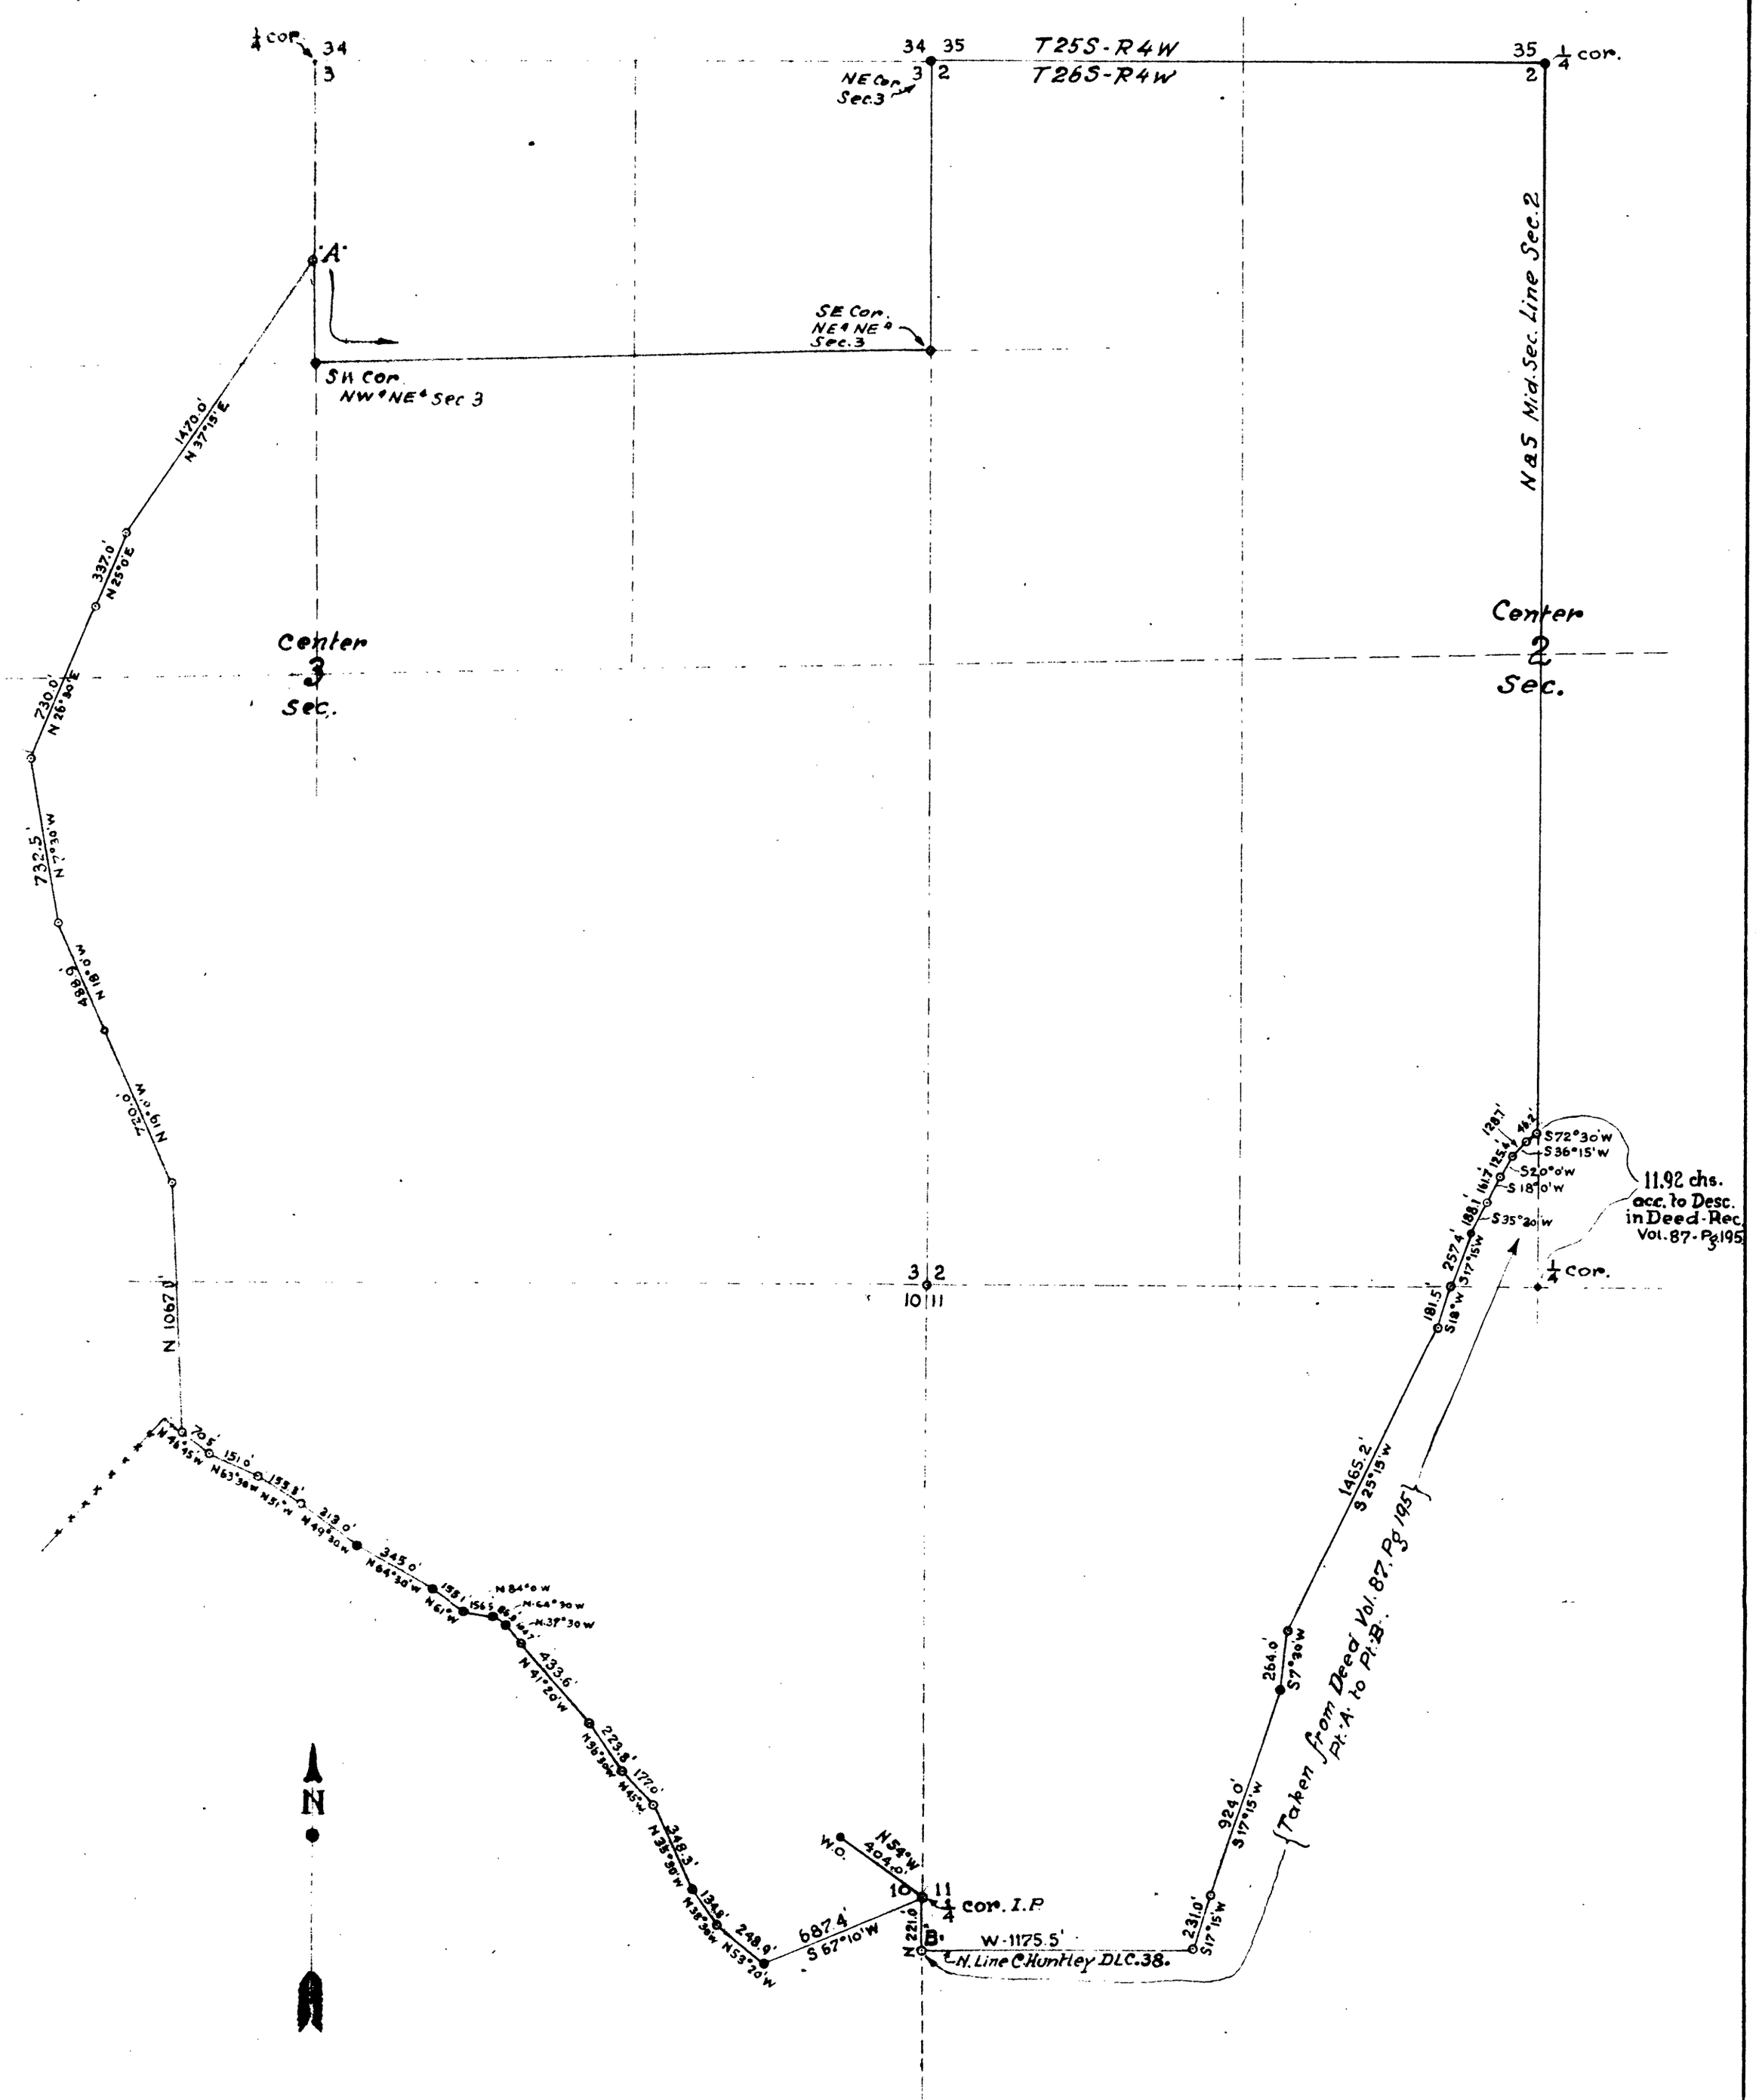

County Surveyor's Office, Roseburg, Ore.

R. B. OLIVER to

870 Ac. in SEC. 2, 3, 10 & 11, T. 26S. R. 4W.

WILLAMETTE MERIDIAN,

Douglas County - Oregon.

Nov. 1944. A. Boyer, Co. Surveyor.

1" = 600 ft.

C. S. File No. 38/212