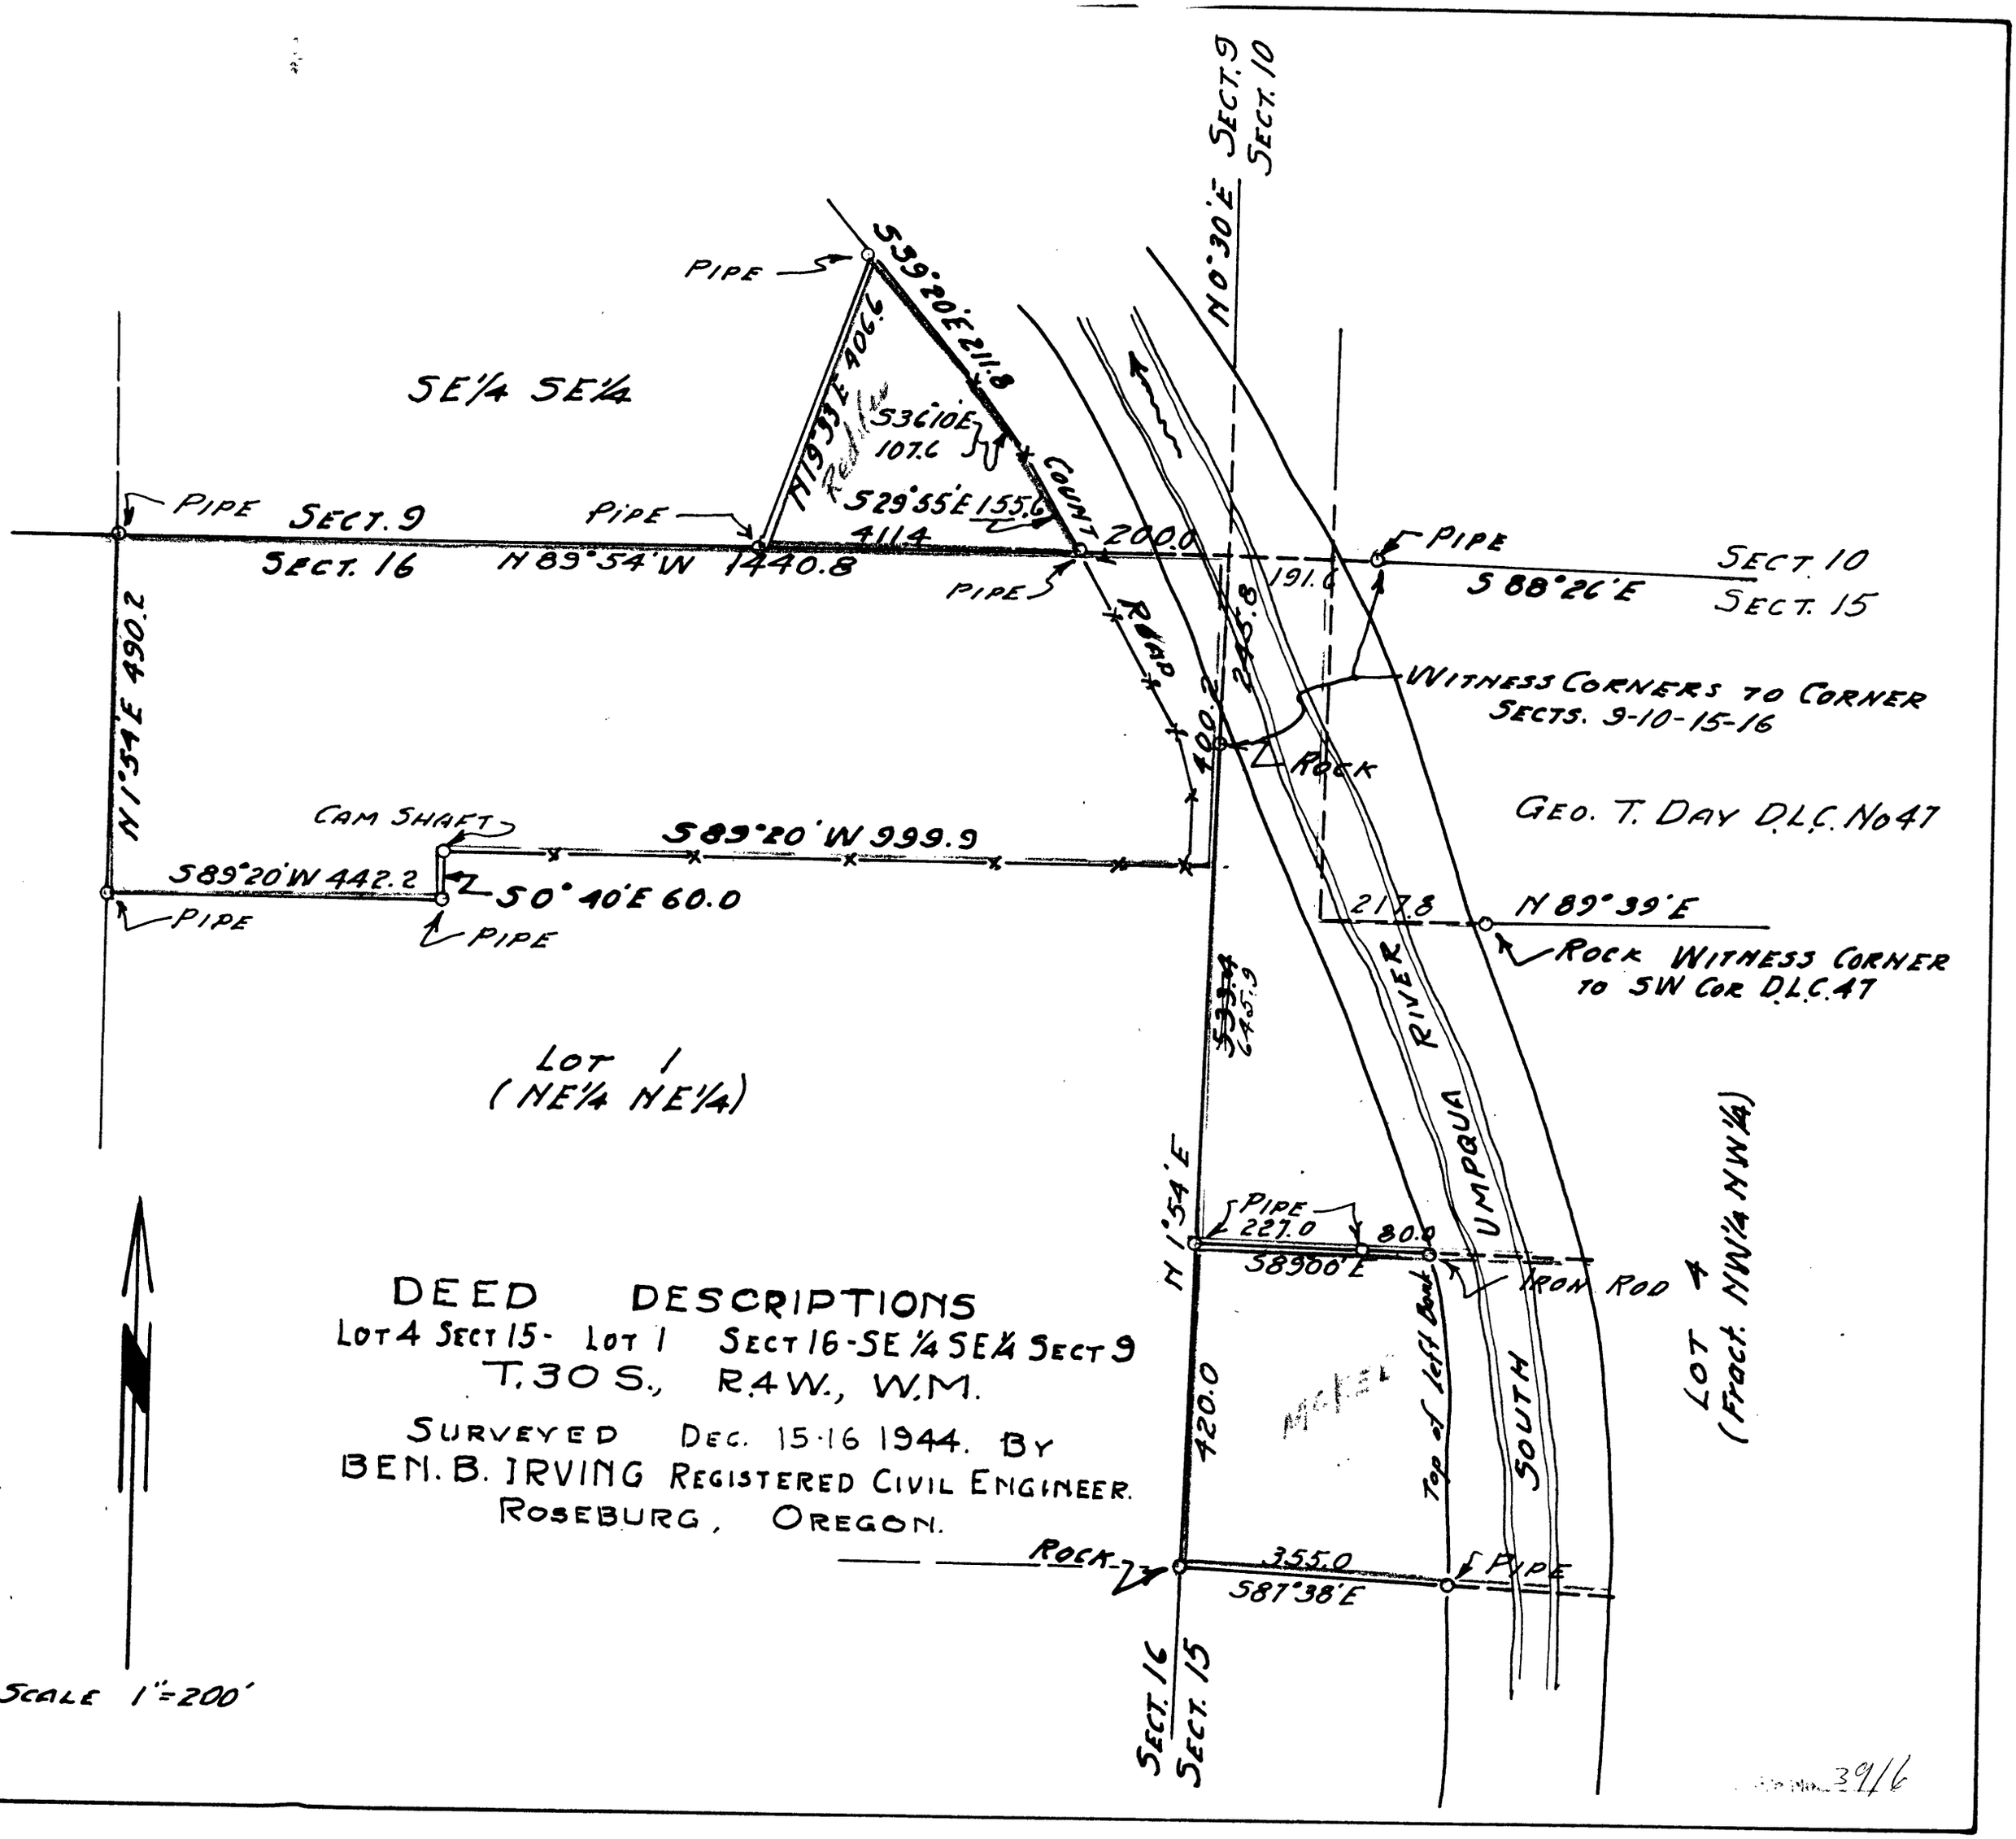

DEED DESCRIPTIONS

LOT 4 SECT 15 - LOT 1 SECT 16 - SE 1/4 SE 1/4 SECT 9
T. 30 S., R. 4 W., W.M.

SURVEYED DEC. 15-16 1944. BY
BEN. B. IRVING REGISTERED CIVIL ENGINEER.
ROSEBURG, OREGON.

3916