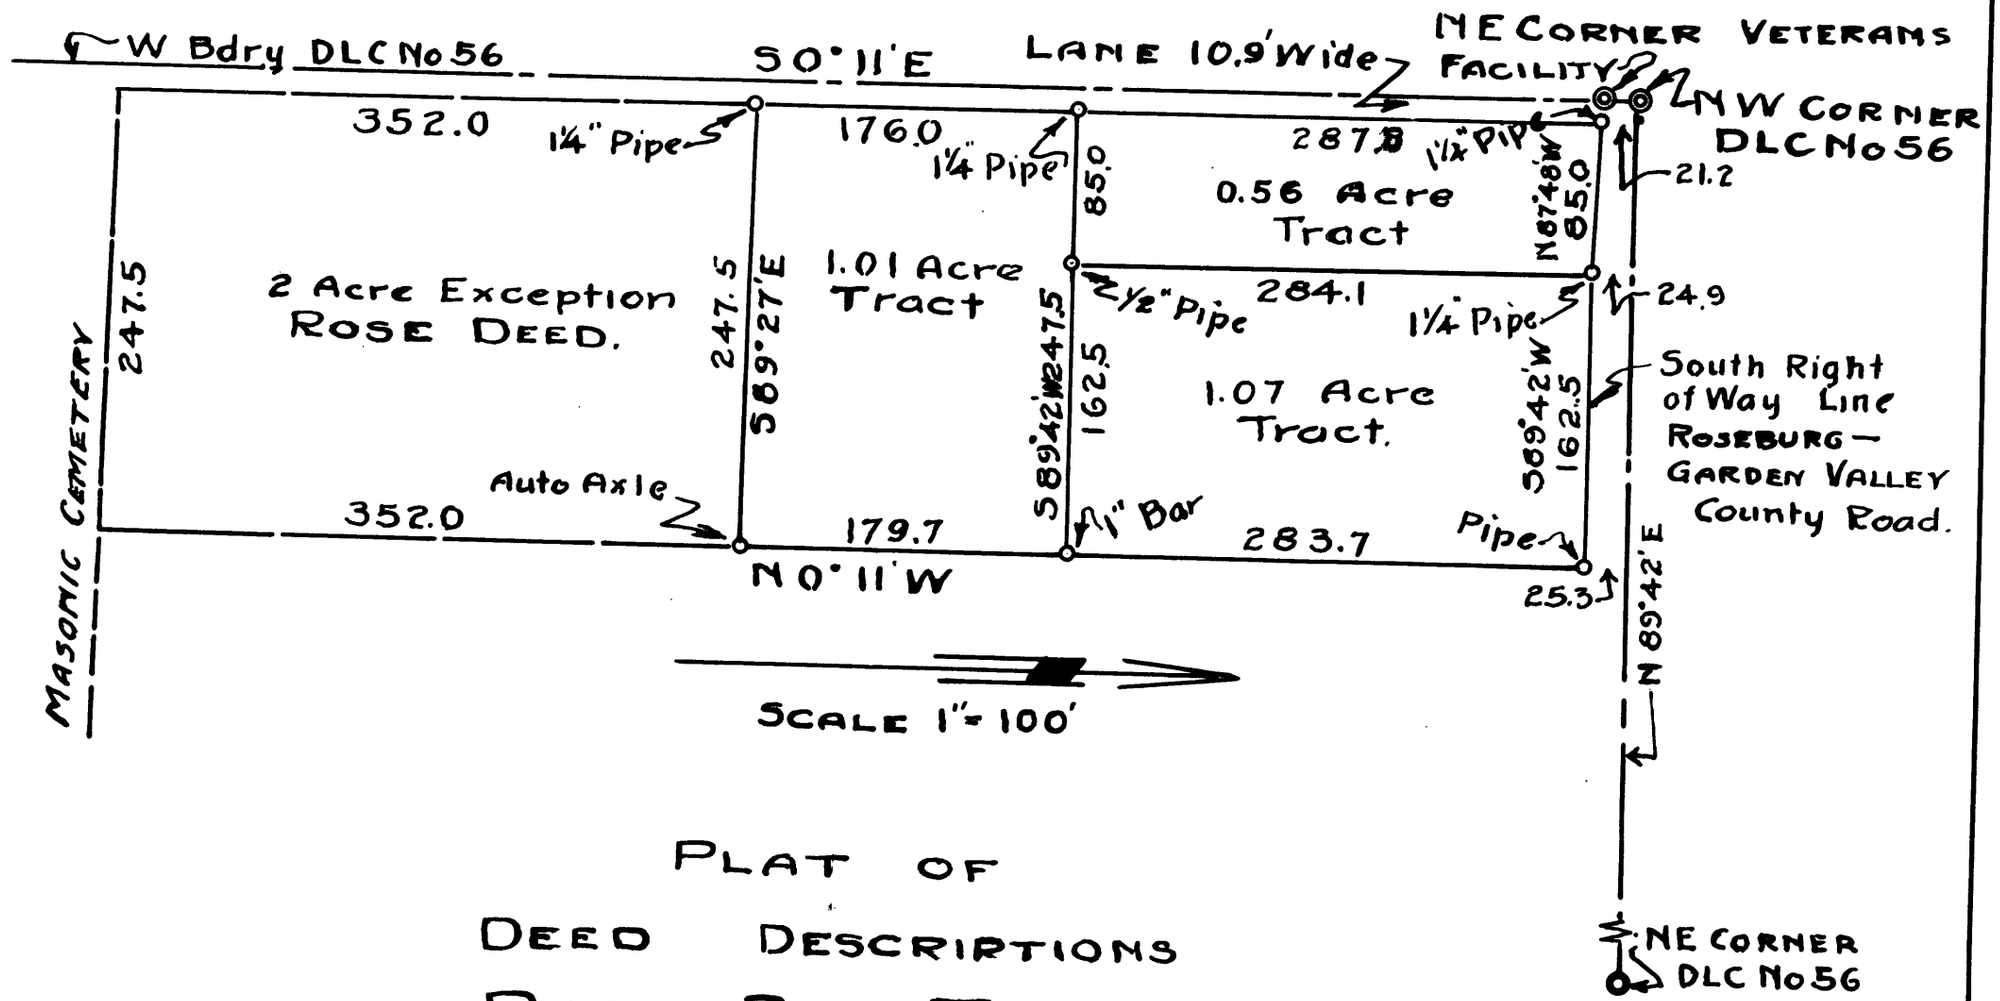

PLAT OF DEED DESCRIPTIONS

ROY ROSE TRACT

N.W COR. JEREMIAH HUNTLEY D.L.C. No 56
T 27 S., R 6 W., W.M.

SURVEYED FEB. 19 1945 BY
BEN. B. IRVING, COUNTY SURVEYOR,
DOUGLAS COUNTY, OREGON.

COUNTY SURVEYORS FILE DATA
DO NOT REMOVE FROM OFFICE