COUNTY SURVEYORS FILE DATA
DO NOT REMOVE FROM OFFICE

# COUNTY SURVEYOR'S OFFICE
# DOUGLAS COUNTY OREGON

## DEED DESCRIPTION
## MAIN & GERMOND STREETS
## ROSEBURG OREGON

N.E. RICHARDSON DEPUTY COUNTY SURVEYOR
JULY 6 1945

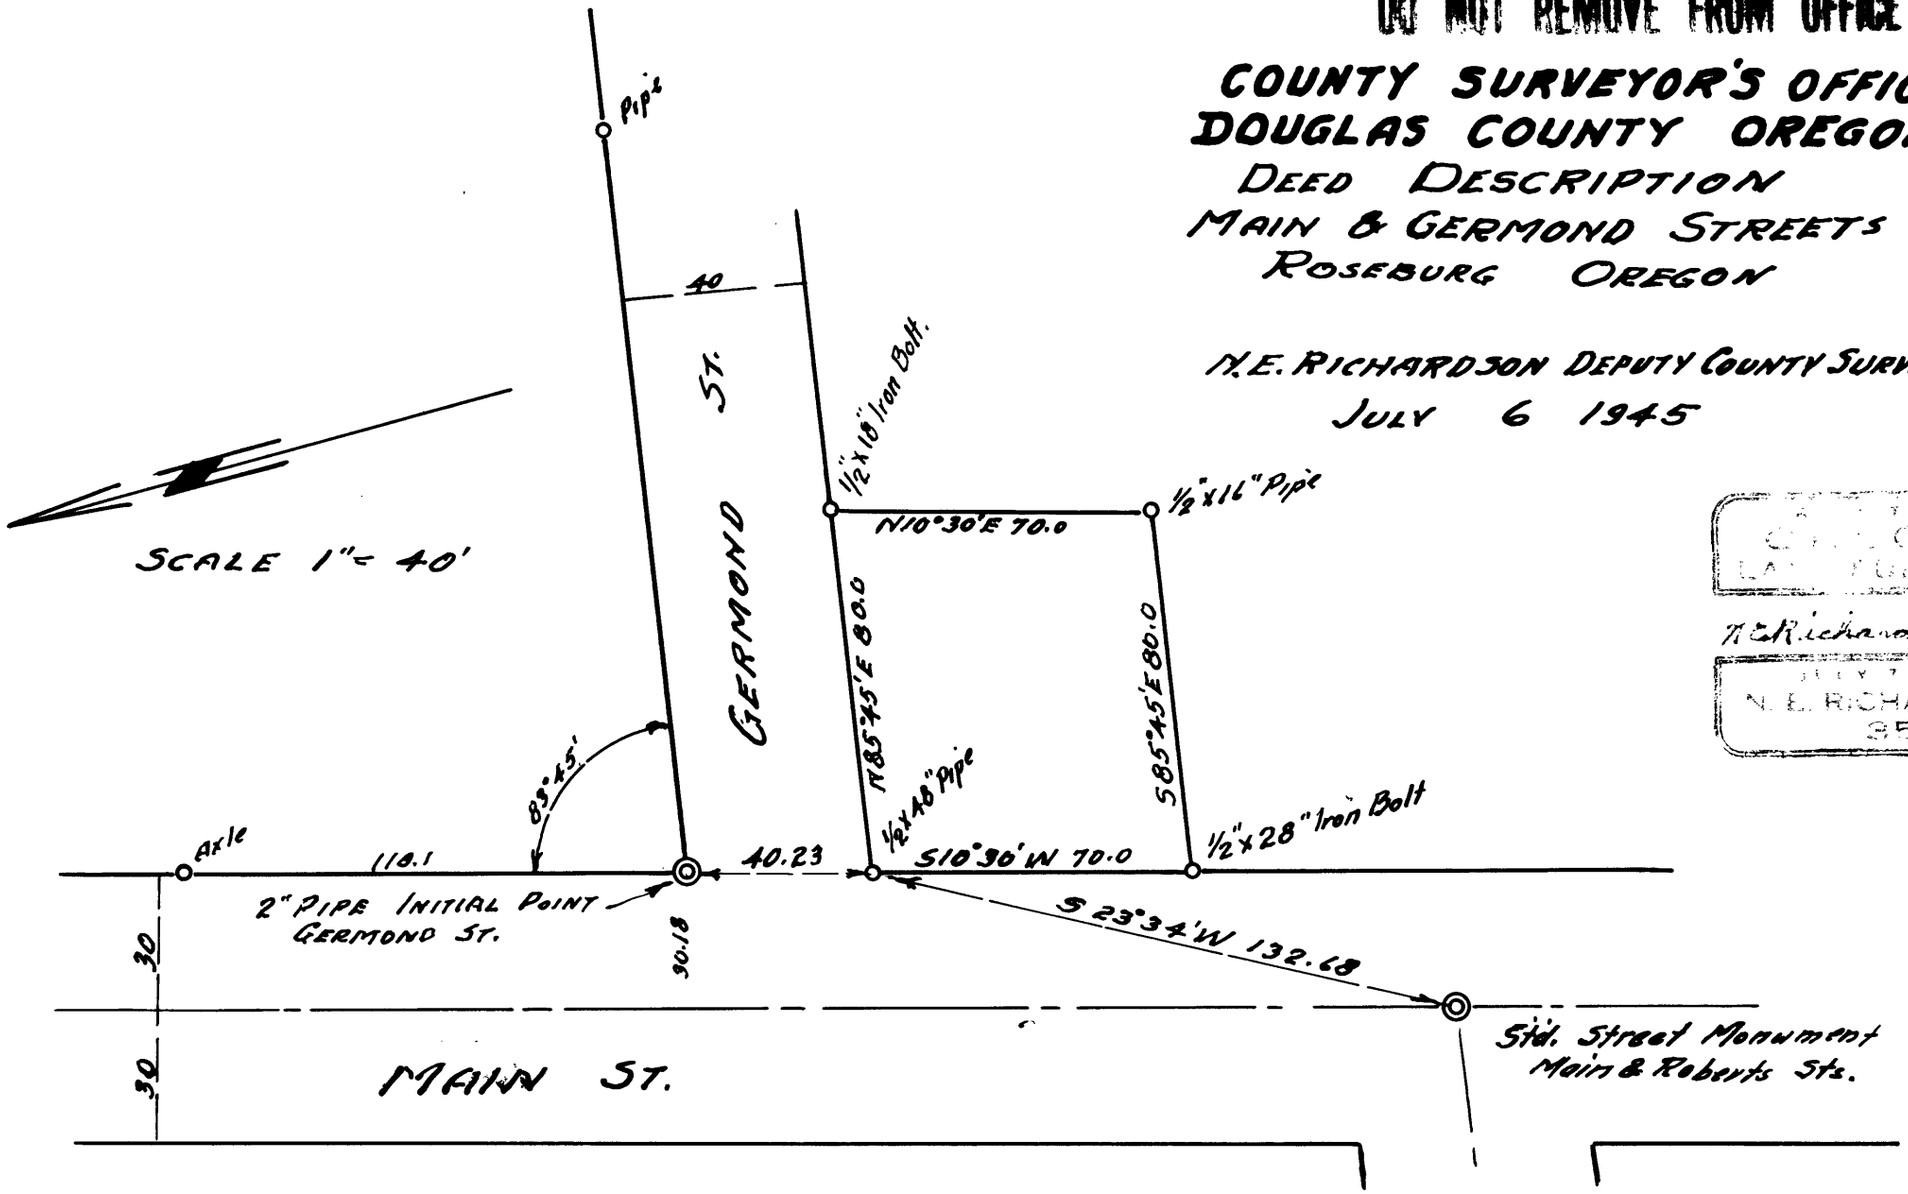


REGISTERED
OREGON
LAND SURVEYOR
N.E. Richardson
JULY 7 1944
N. E. RICHARDSON
95