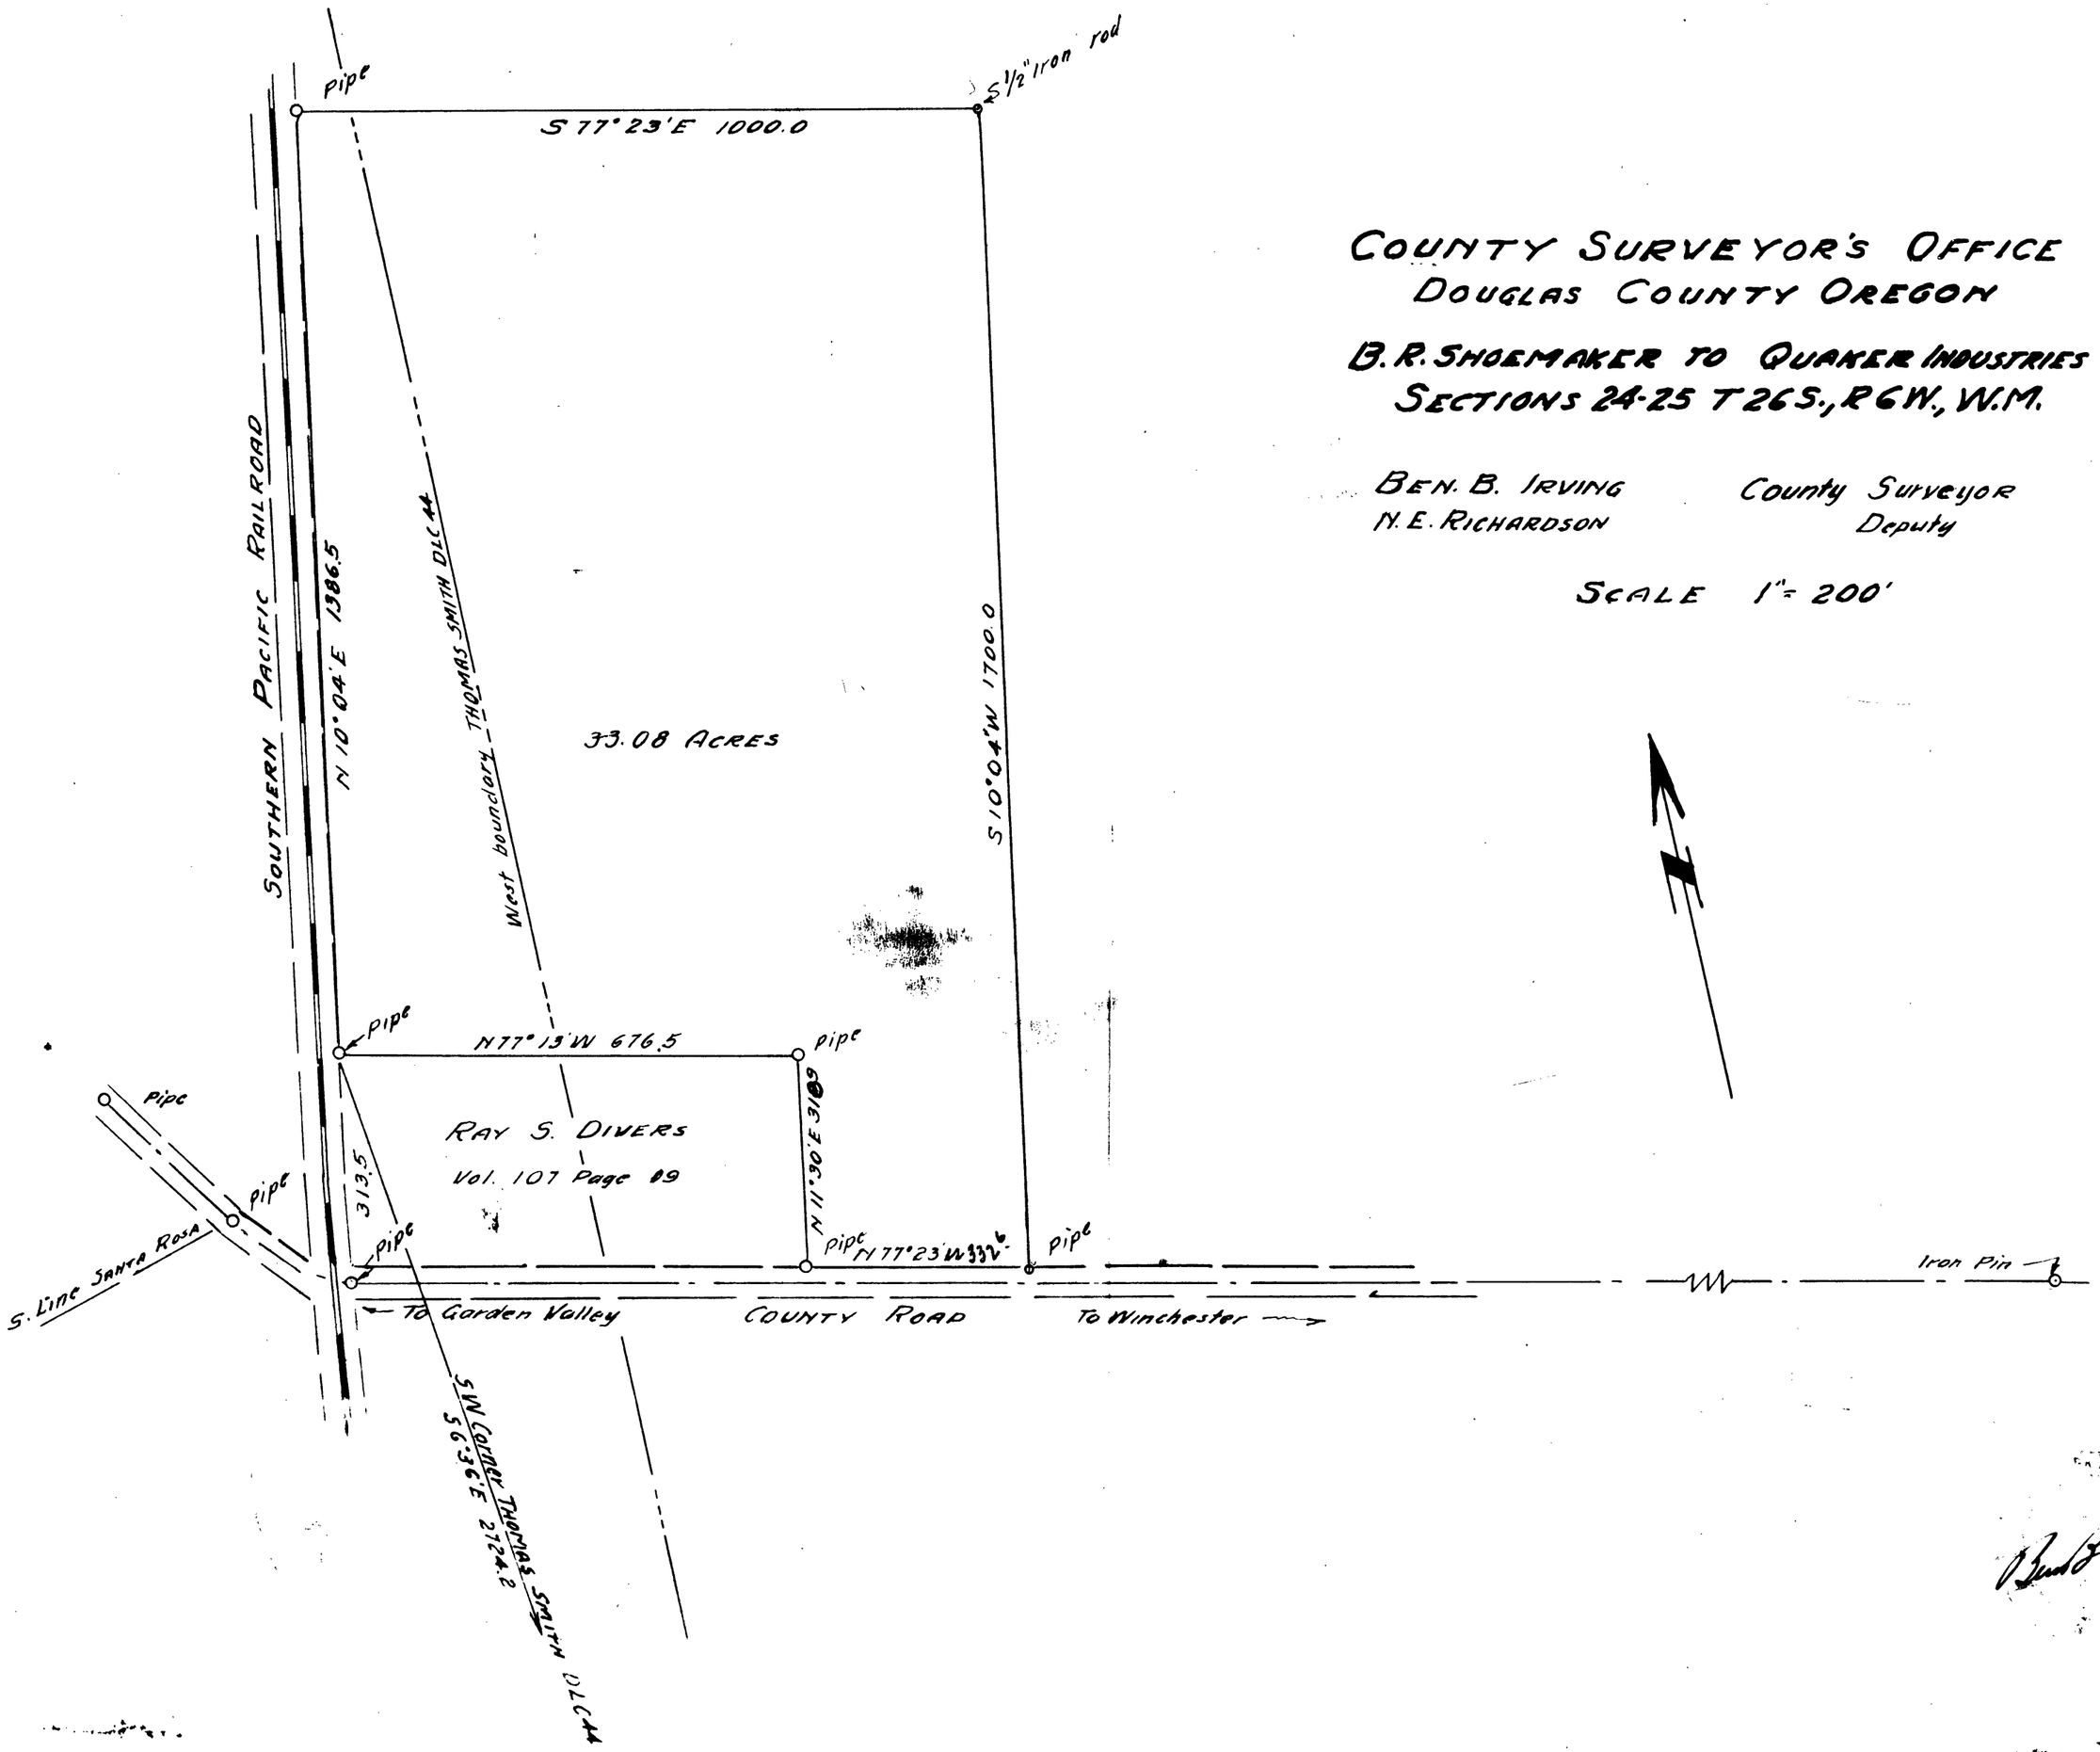

COUNTY SURVEYOR'S OFFICE
DOUGLAS COUNTY OREGON

B. R. SHOEMAKER TO QUAKER INDUSTRIES
SECTIONS 24-25 T26S., R6W., W.M.

BEN. B. IRVING — County Surveyor
N. E. RICHARDSON — Deputy

SCALE 1" = 200'

Ben B. Irving

39116

FOR ORIGINAL
SEE M16-60