COUNTY SURVEYOR'S OFFICE
DOUGLAS COUNTY OREGON

CERTAIN DEED DESCRIPTIONS
SECTIONS 15-16 T26S R4W.W.M.

BEN. B. IRVING — COUNTY SURVEYOR
Surveyed SEPT. 1946
N.E. RICHARDSON — Deputy County Surveyor.

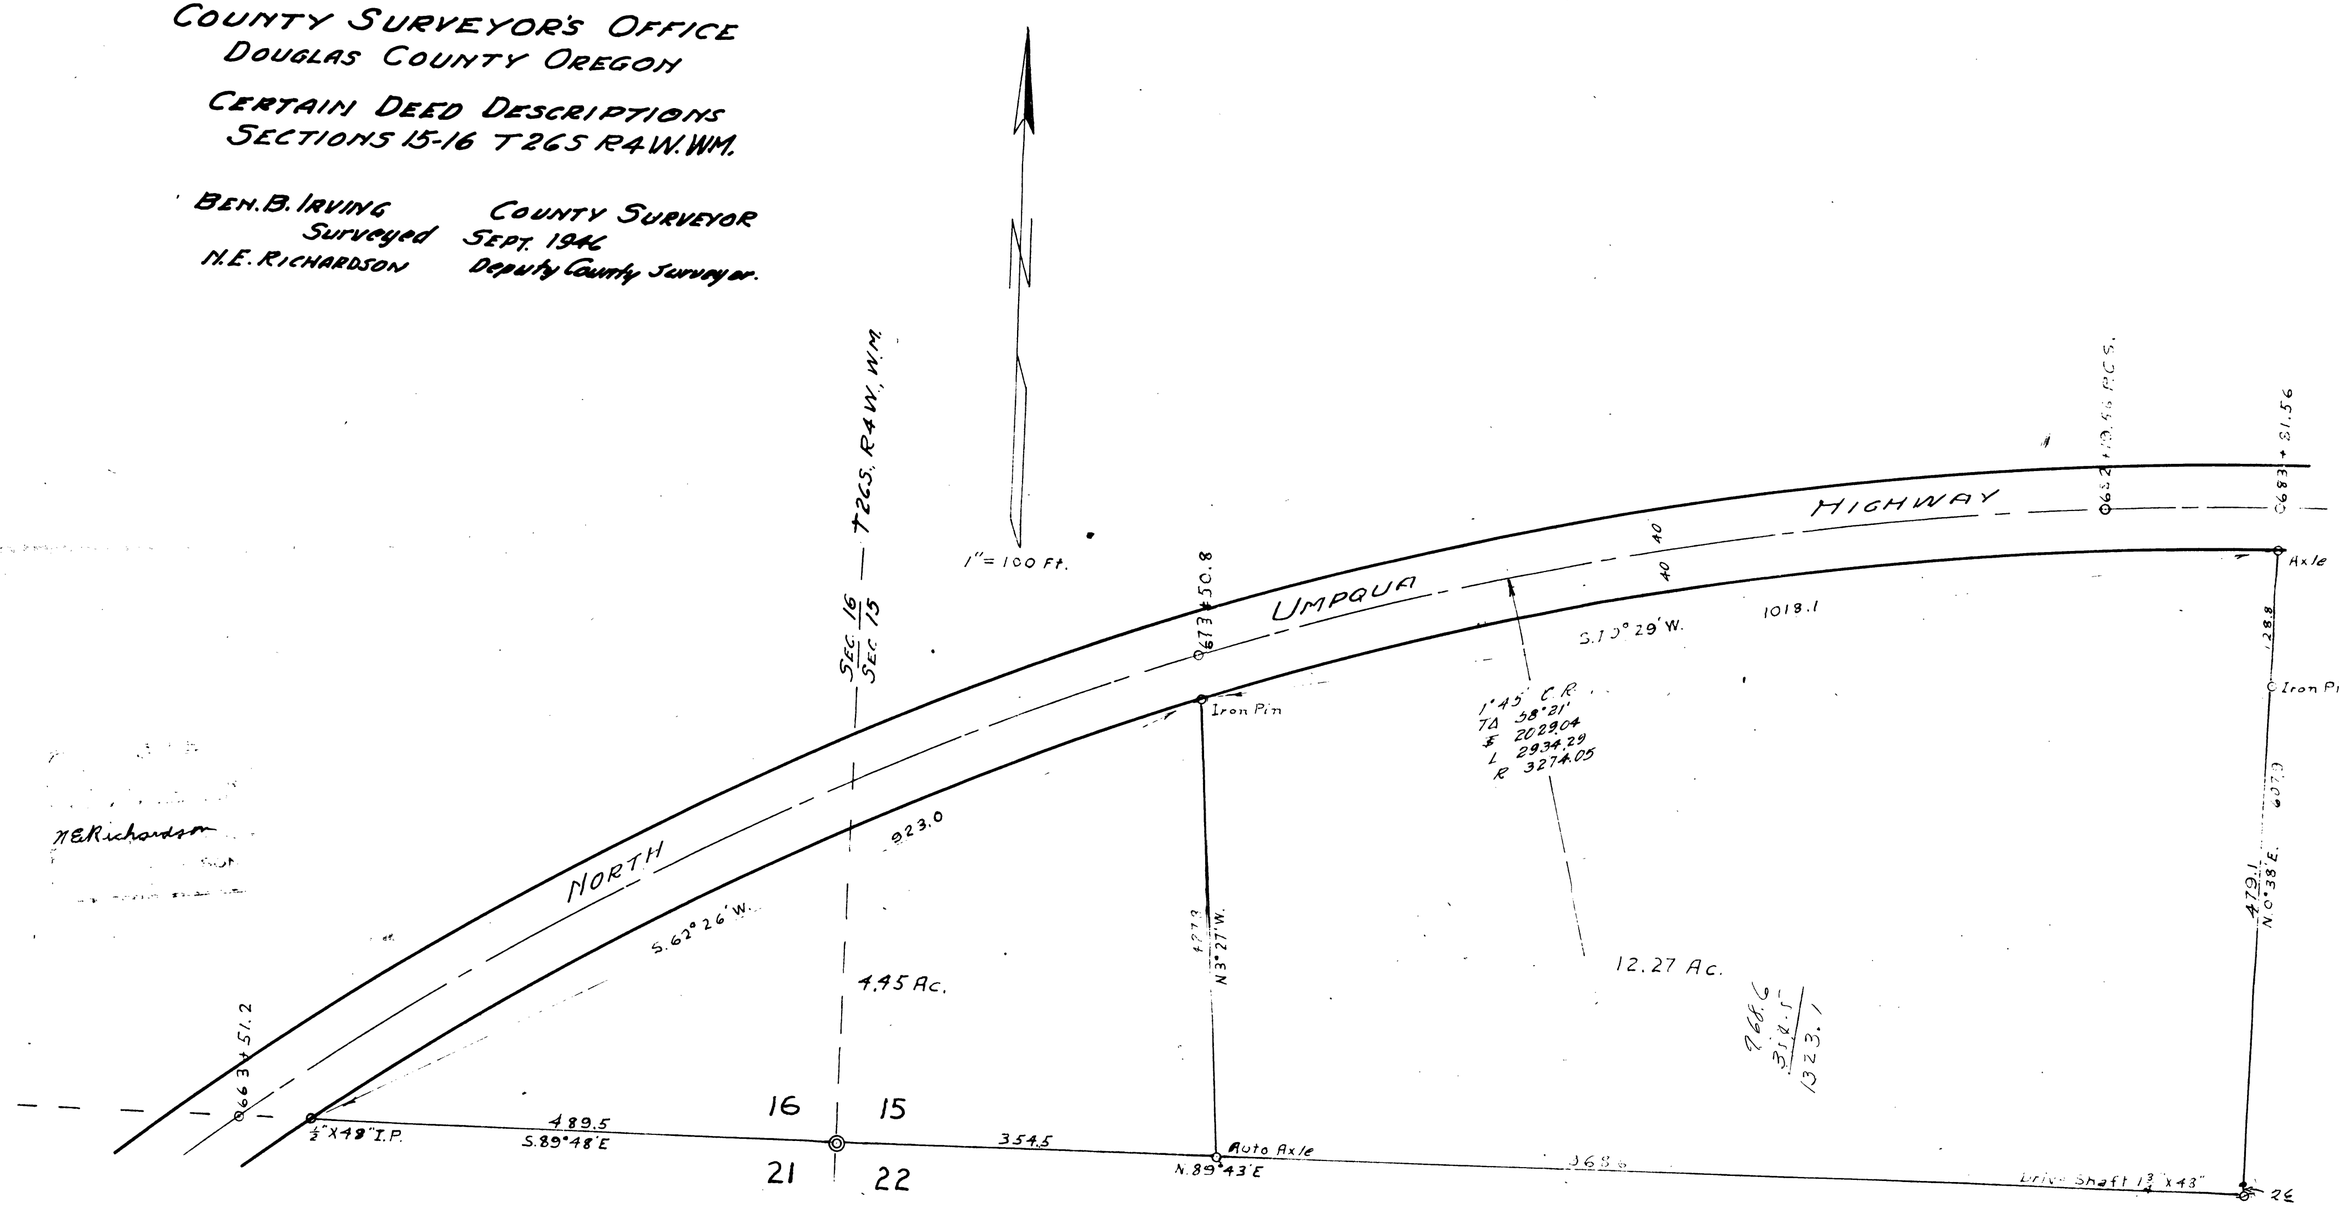

FOR ORIGINAL SEE M13-42

C.S. No. 39/34