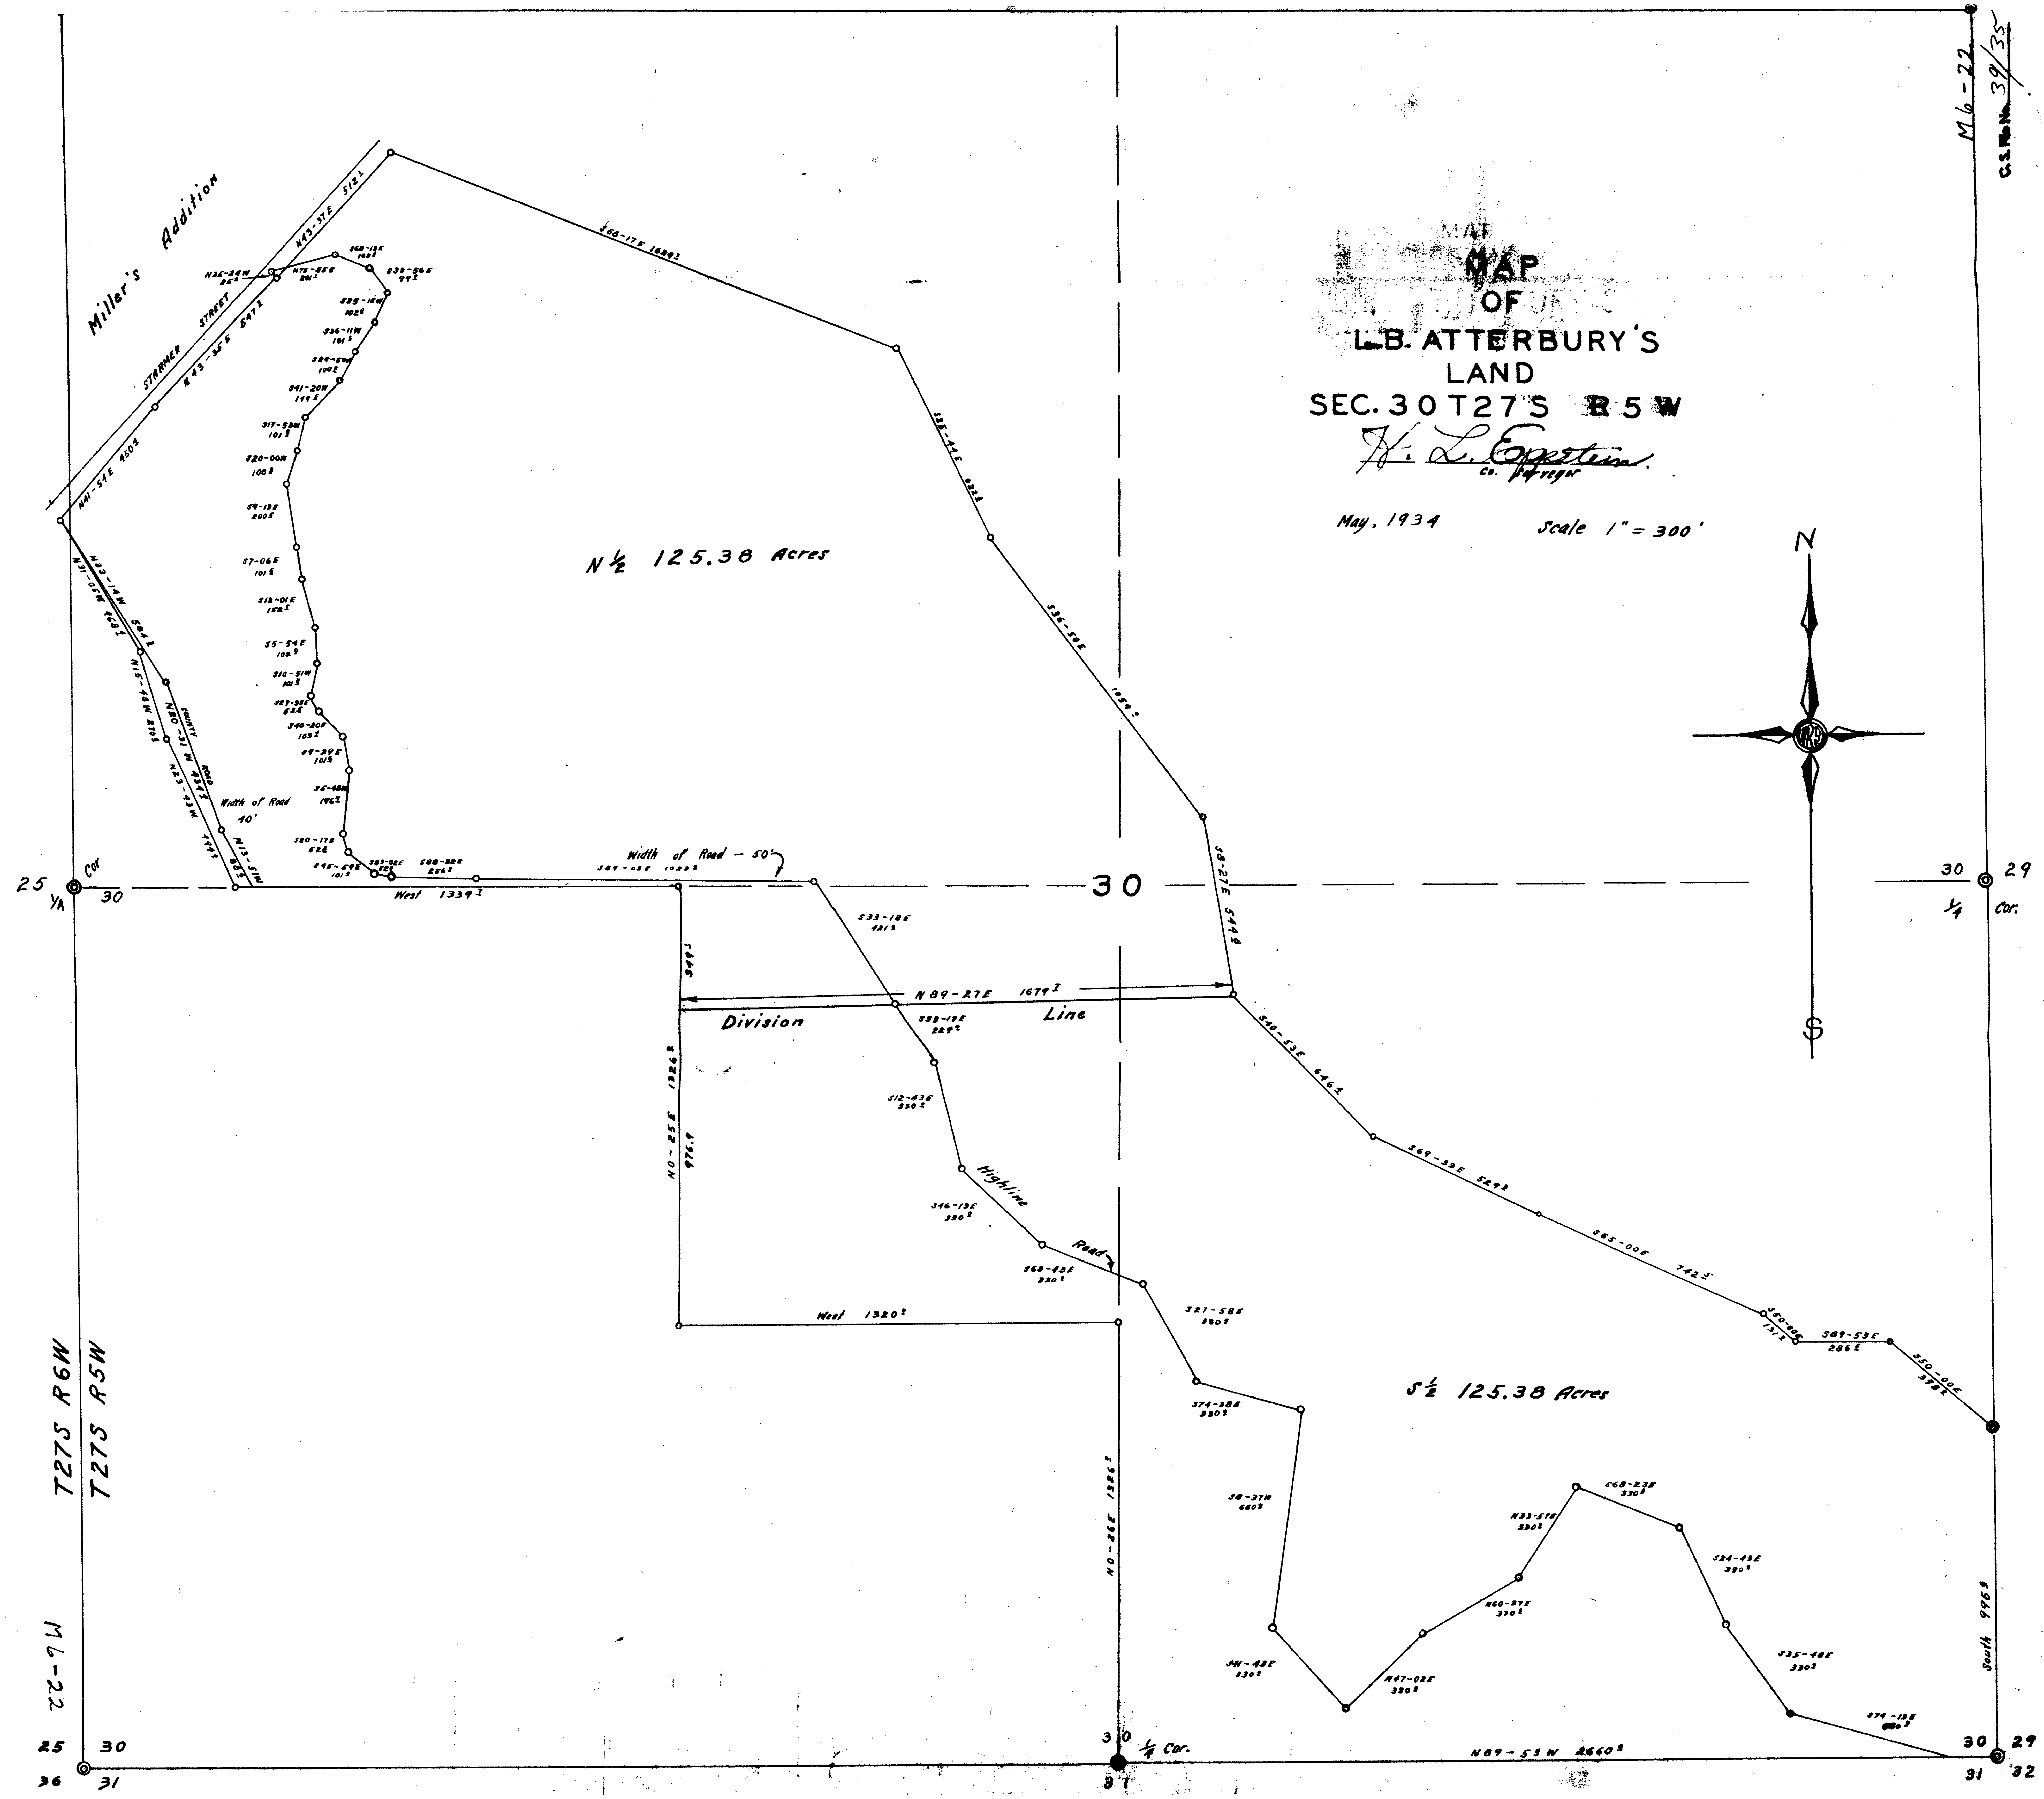
MAP
OF
L.B. ATTERBURY'S
LAND
SEC. 30 T27S R5W
W. L. Epstein
Co. Surveyor
May, 1934
Scale 1" = 300'
N
S
N½ 125.38 Acres
S½ 125.38 Acres
Miller's Addition
STRAWN STREET
Width of Road 40'
Width of Road - 50'
Division Line
N89-27E 1674±
Highline Road
West 1339±
West 1320±
N89-53W 2660±
South 996±
T27S R6W
T27S R5W
M6-22
C.S. File No. 39/35
30
¼ Cor.
25 30
36 31
30 29
31 32