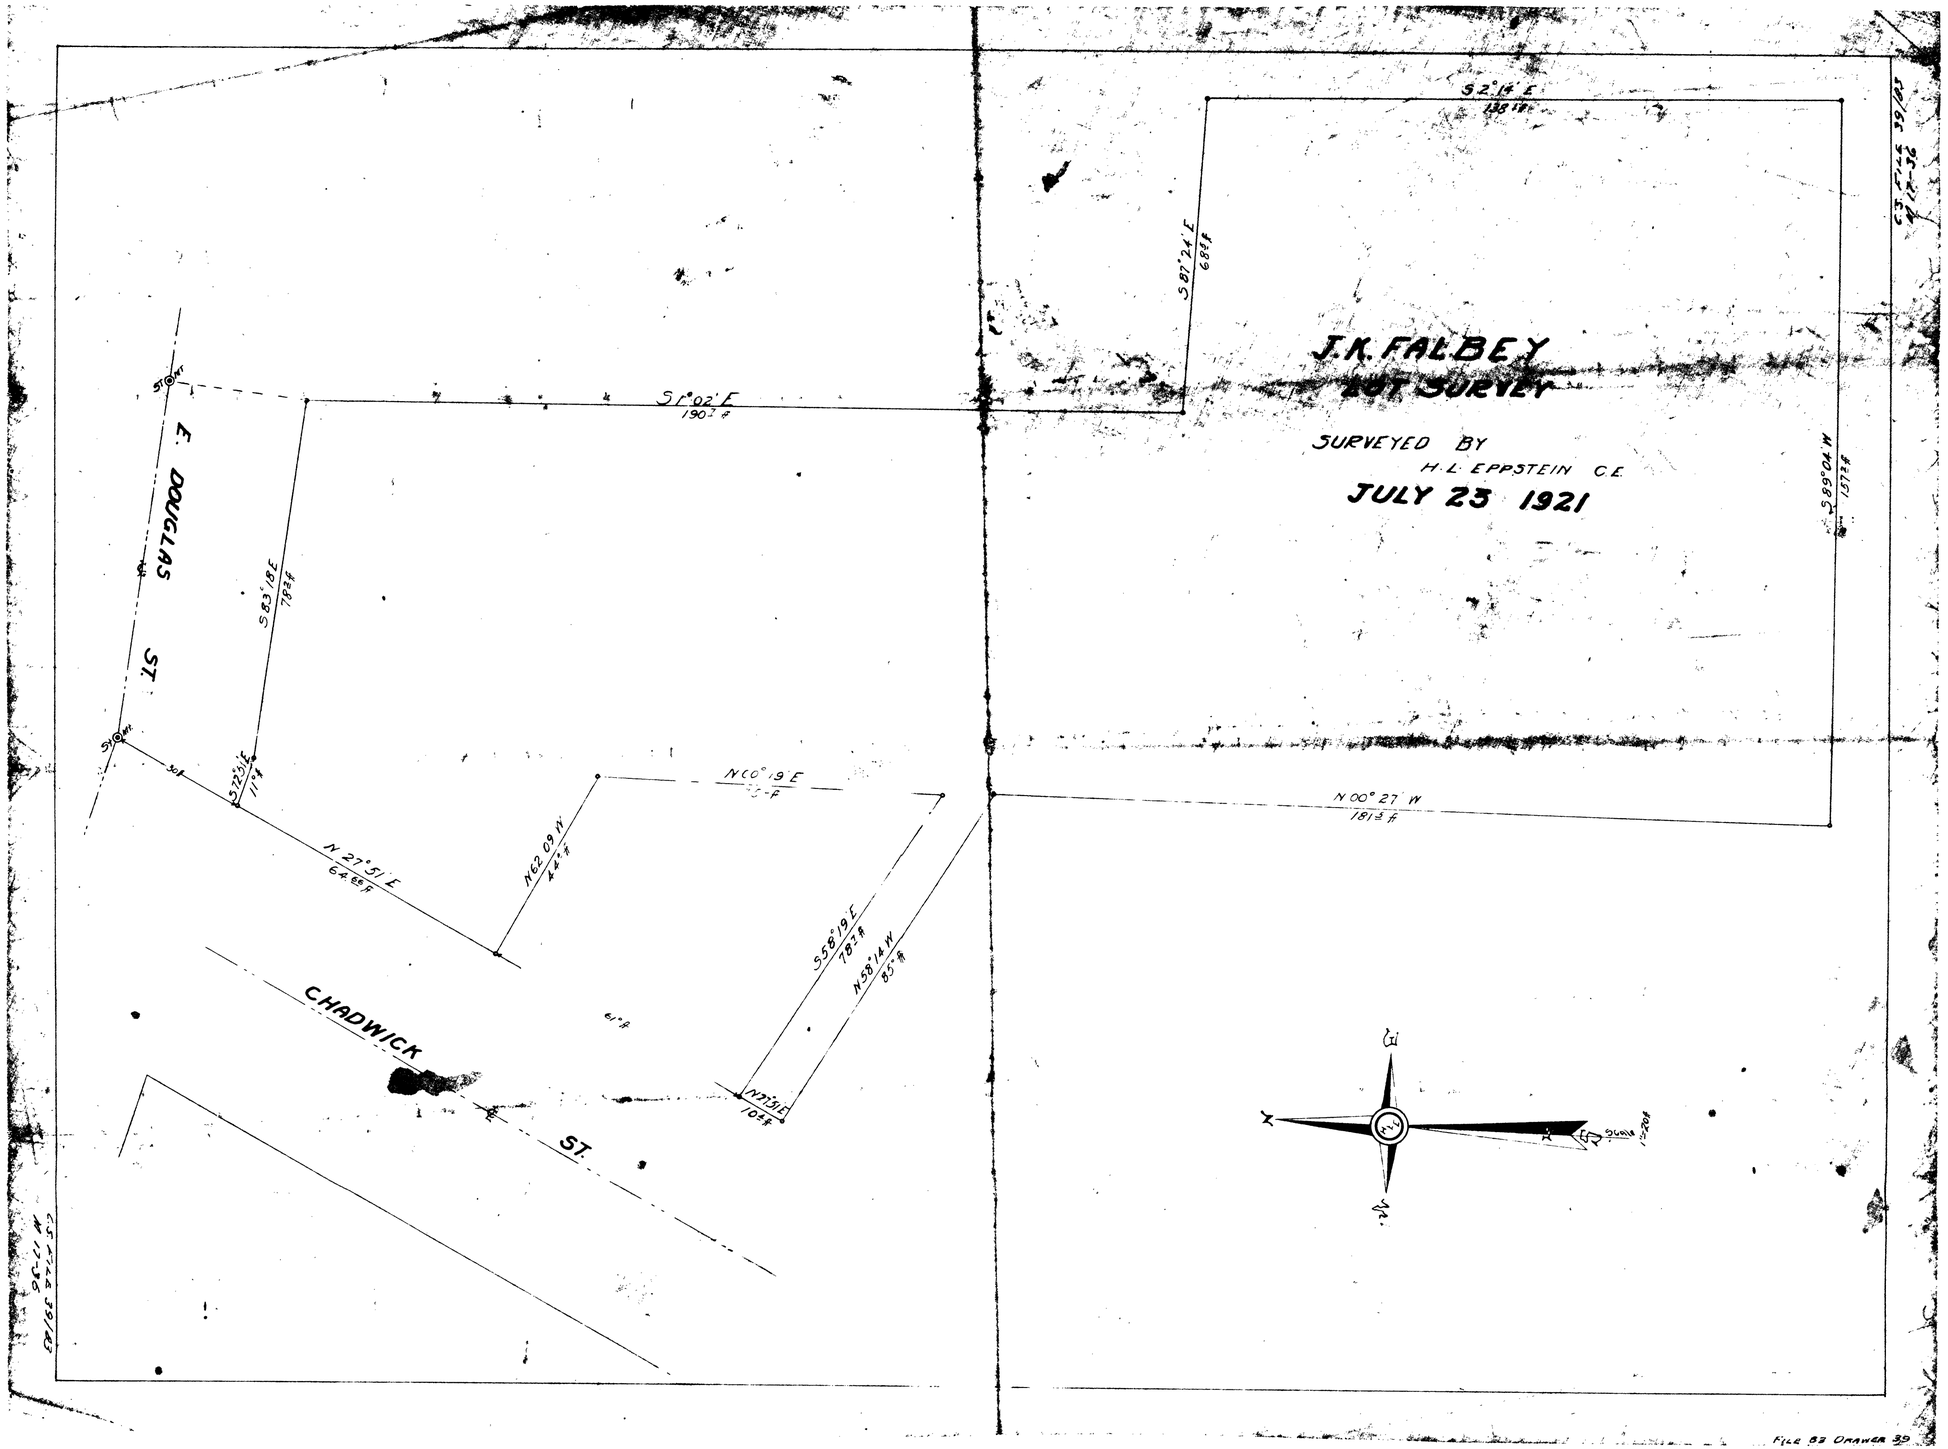
J.K. FALBEY
LOT SURVEY
SURVEYED BY
H.L. EPPSTEIN C.E.
JULY 23 1921
S 2°14' E
138.4 ft
S 87°24' E
68 ft
S 89°04' W
137.3 ft
N 00°27' W
181.3 ft
S 1°02' E
190.7 ft
S 63°18' E
78.3 ft
S 72°53' E
11.4 ft
N 27°51' E
64.65 ft
N 62°09' W
44.4 ft
N 00°19' E
S 58°19' E
78.7 ft
N 58°14' W
85.3 ft
N 73°51' E
10.4 ft
E. DOUGLAS ST.
CHADWICK ST.
N
E
S
W
SCALE 1" = 20 ft
FILE 82 DRAWER 39