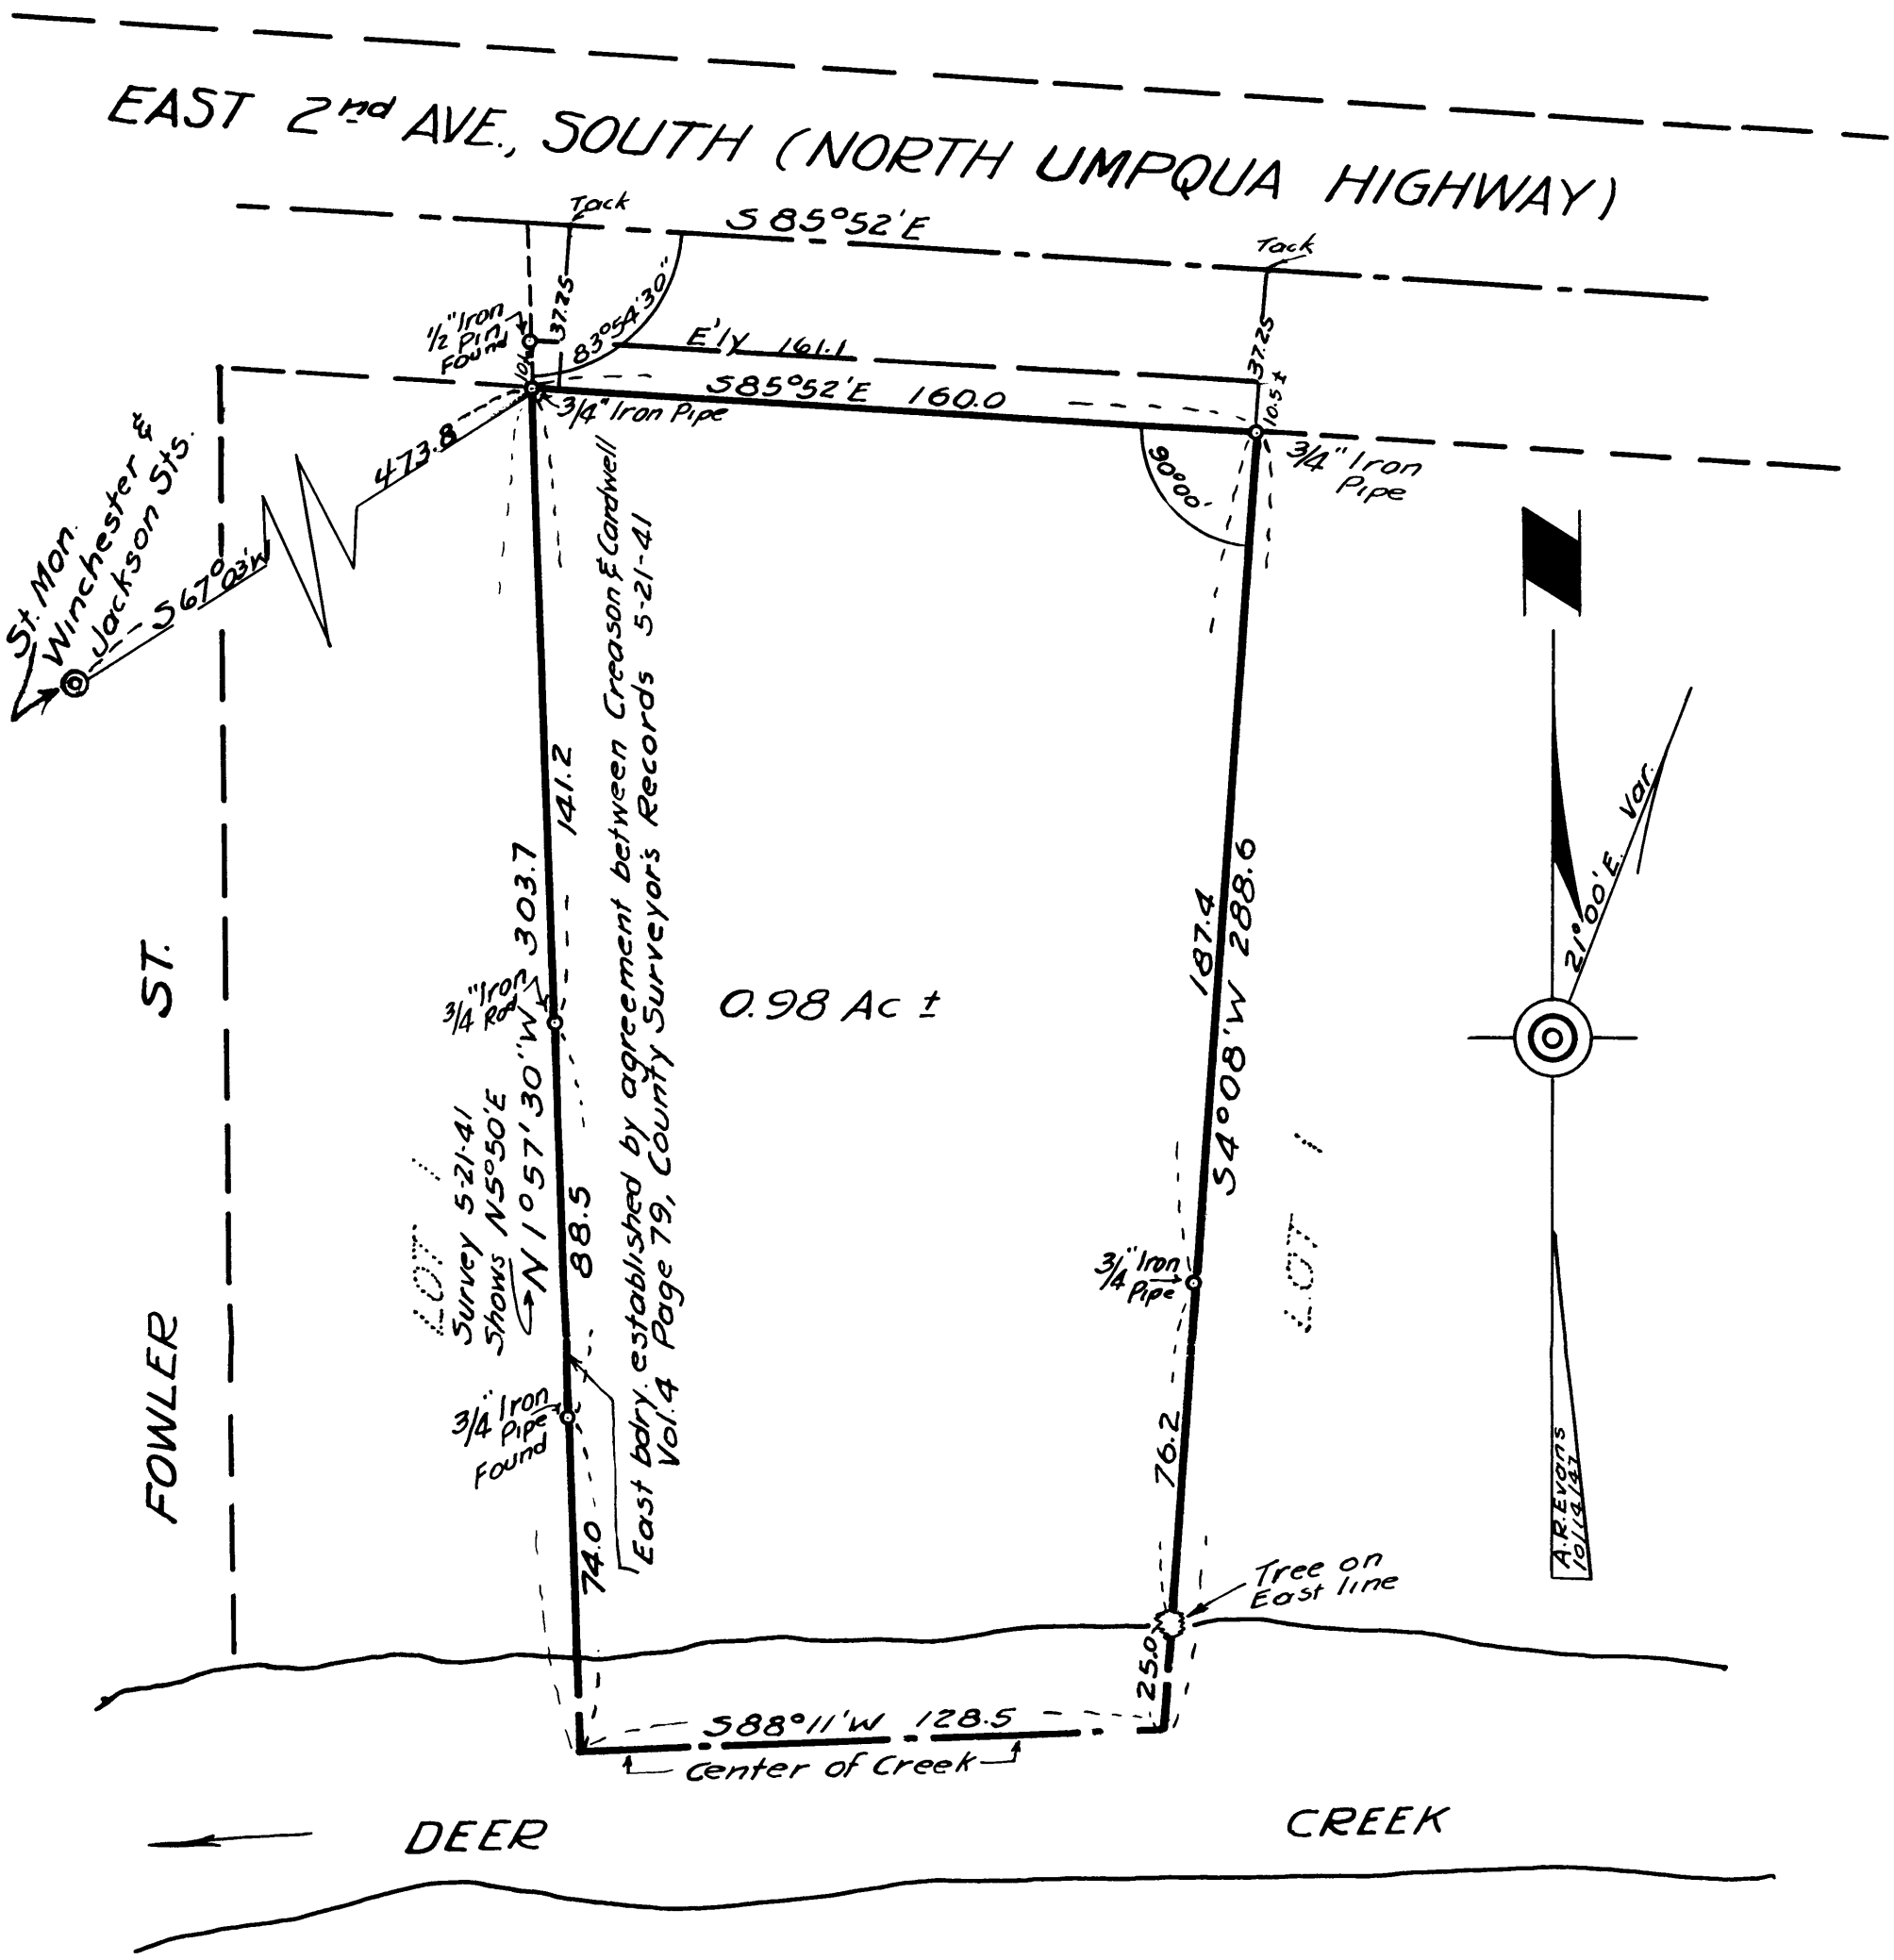

COUNTY SURVEYOR'S OFFICE
DOUGLAS COUNTY OREGON
SURVEY OF PART OF LOT 1,
BLOCK 1, BUSHEY'S ADDITION,
TO ROSEBURG OREGON

BEN. B. IRVING COUNTY SURVEYOR
SURVEYED, OCTOBER 7-8 1947, BY
N.E. RICHARDSON DEPUTY
SCALE 1" = 40'

N.E. Richardson

COUNTY SURVEYORS FILE DATA
DO NOT REMOVE FROM OFFICE