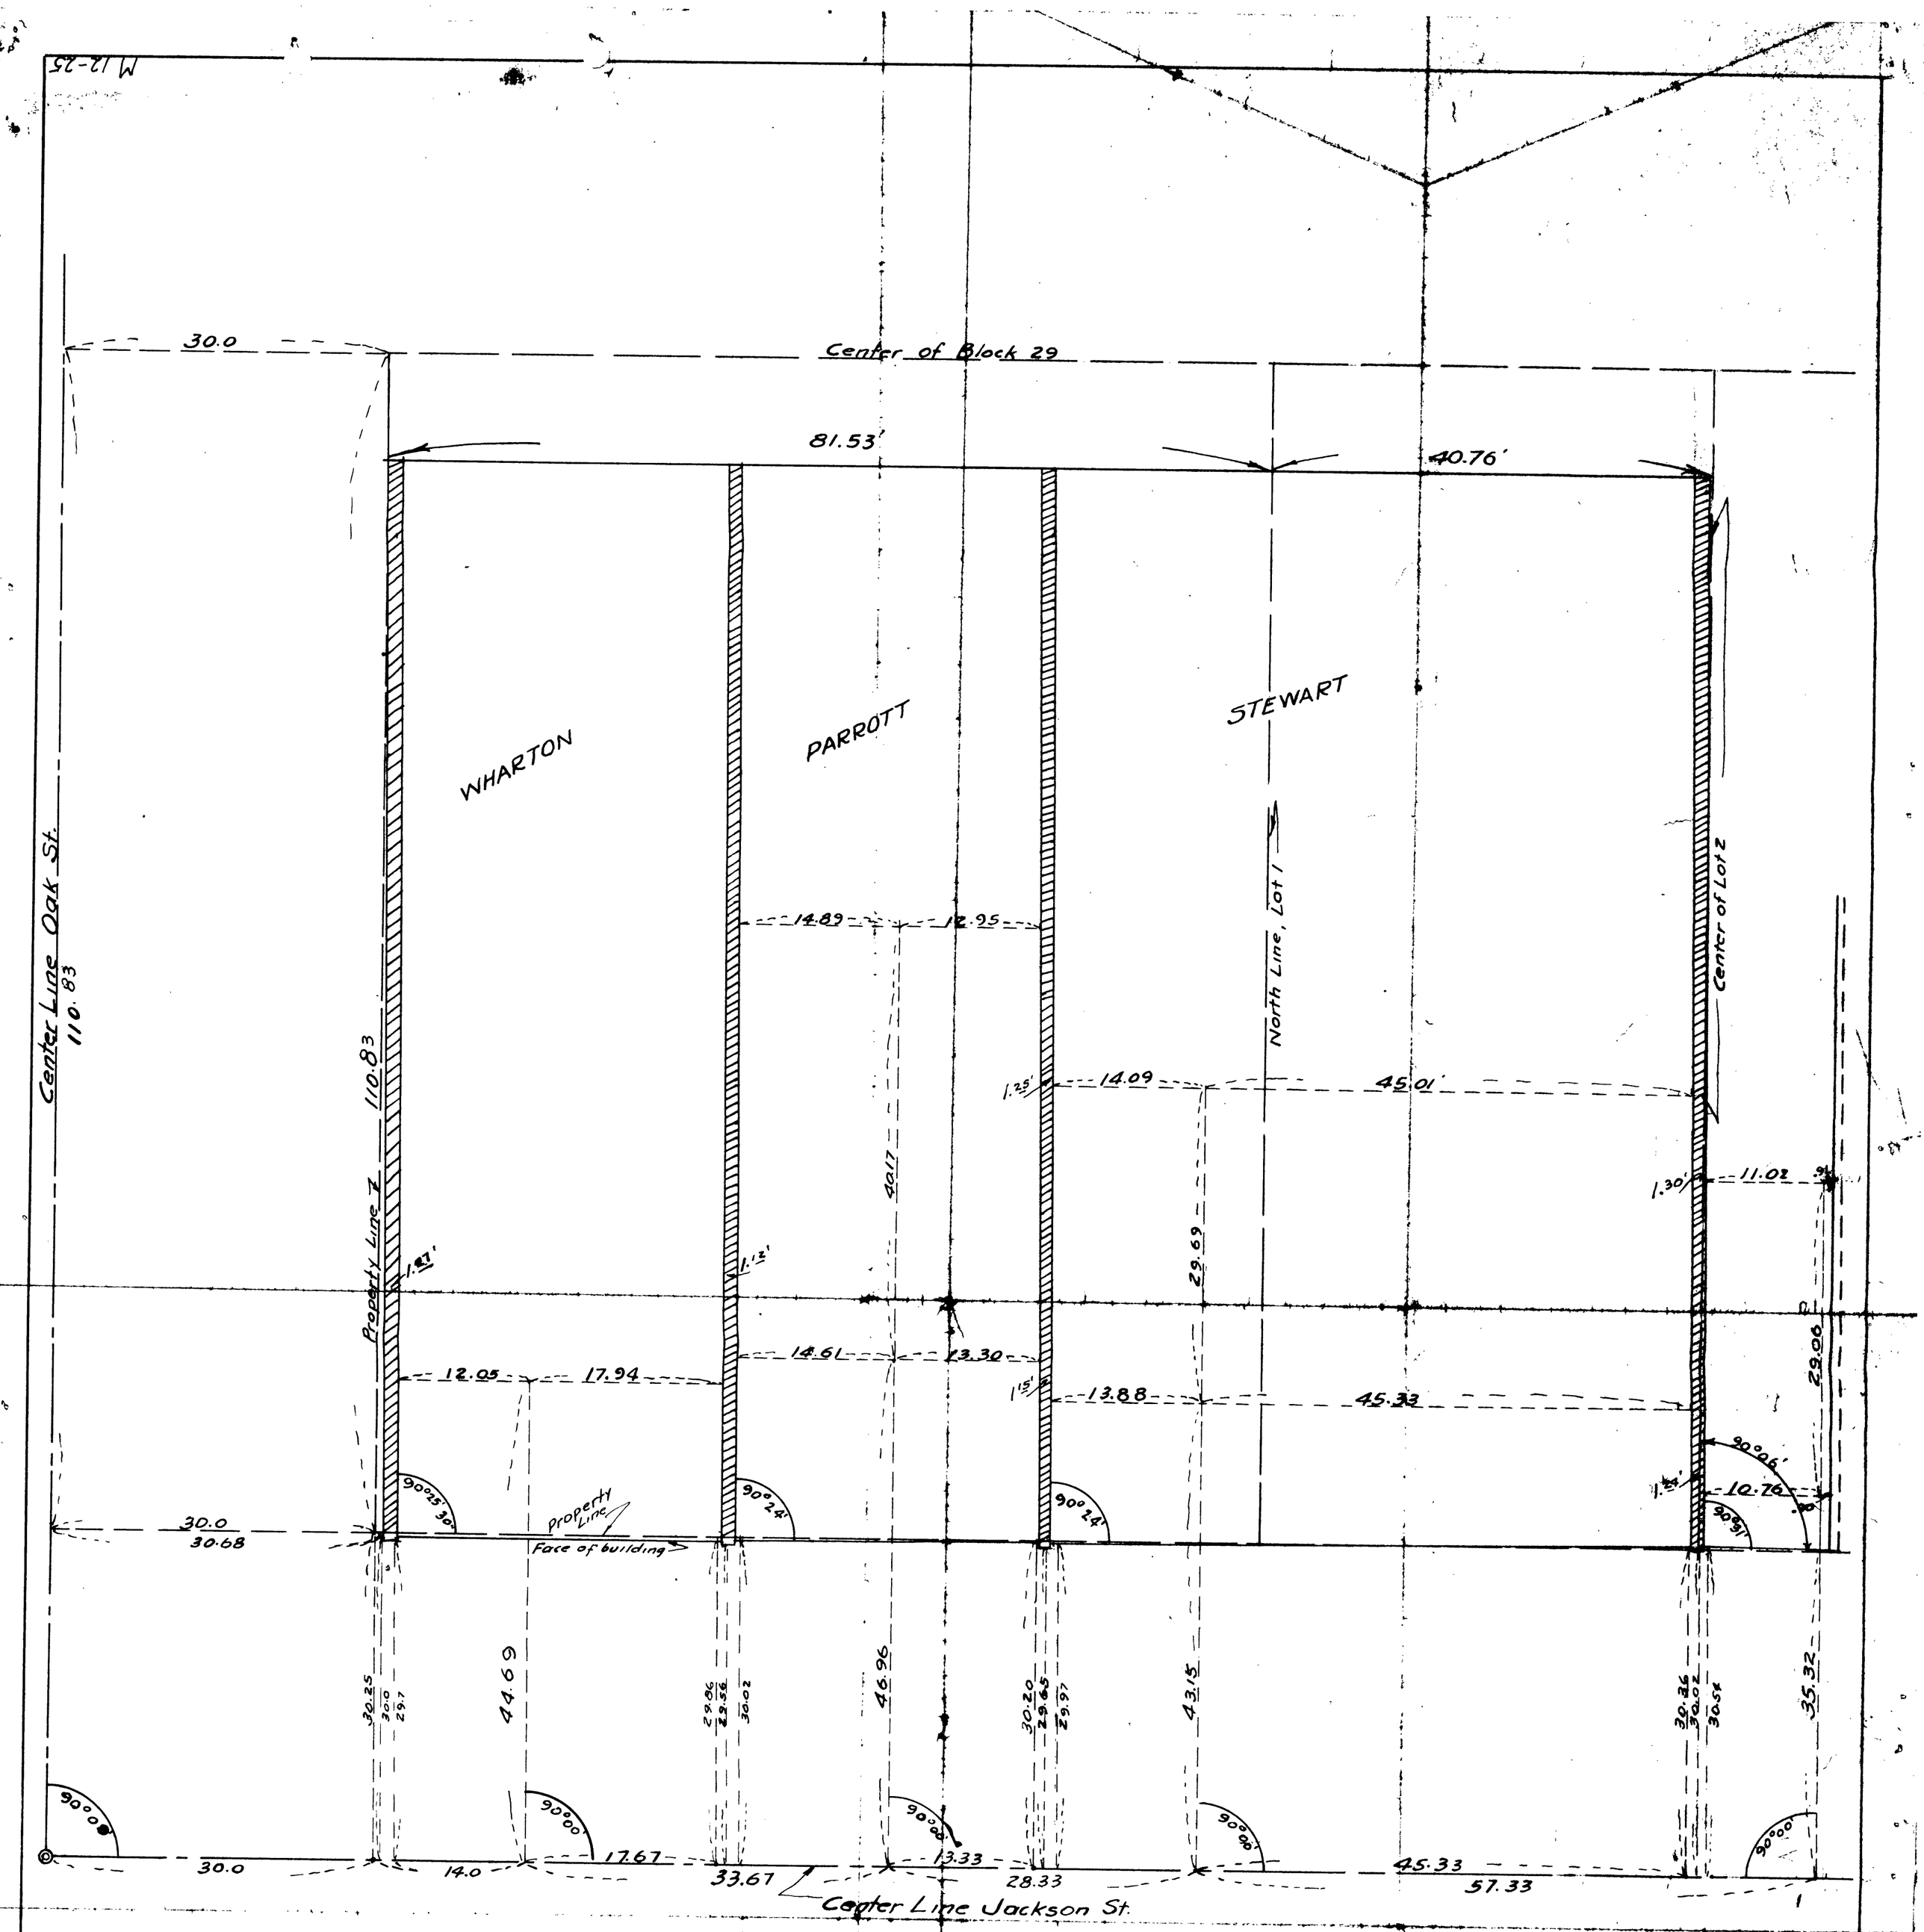


I, FRED M. DARBY, COUNTY SURVEYOR OF DOUGLAS COUNTY, OREGON, DO HEREBY CERTIFY THAT I HAVE INVESTIGATED THE SURVEY SHOWN HEREON; THAT THERE ARE NO DISCREPANCIES APPARENT, AND THAT THE IMPROVEMENTS ARE AT PRESENT AS SHOWN, AND THAT THERE IS NO CONFLICT.

Fred M. Darby

FRED M. DARBY

LAND SURVEYOR

Fred M. Darby

REGISTERED

# OFFICE OF THE COUNTY SURVEYOR
# DOUGLAS COUNTY OREGON
## SURVEY OF LOT 1 AND PART OF LOT 2
## BLOCK 29 ROSEBURG ORE.
## SECTION SHOWING DETAIL OF BUILDINGS
## SCALE 1" = 10'
## SHEET 2 OF 2.

BEN B IRVING COUNTY SURVEYOR

SURVEYED DECEMBER 15-16, 1947, BY

N.E. RICHARDSON DEPUTY

REGISTERED OREGON LAND SURVEYOR

N.E. Richardson

JULY 7, 1944

N. E. RICHARDSON

35

MAP FILE M 12-25