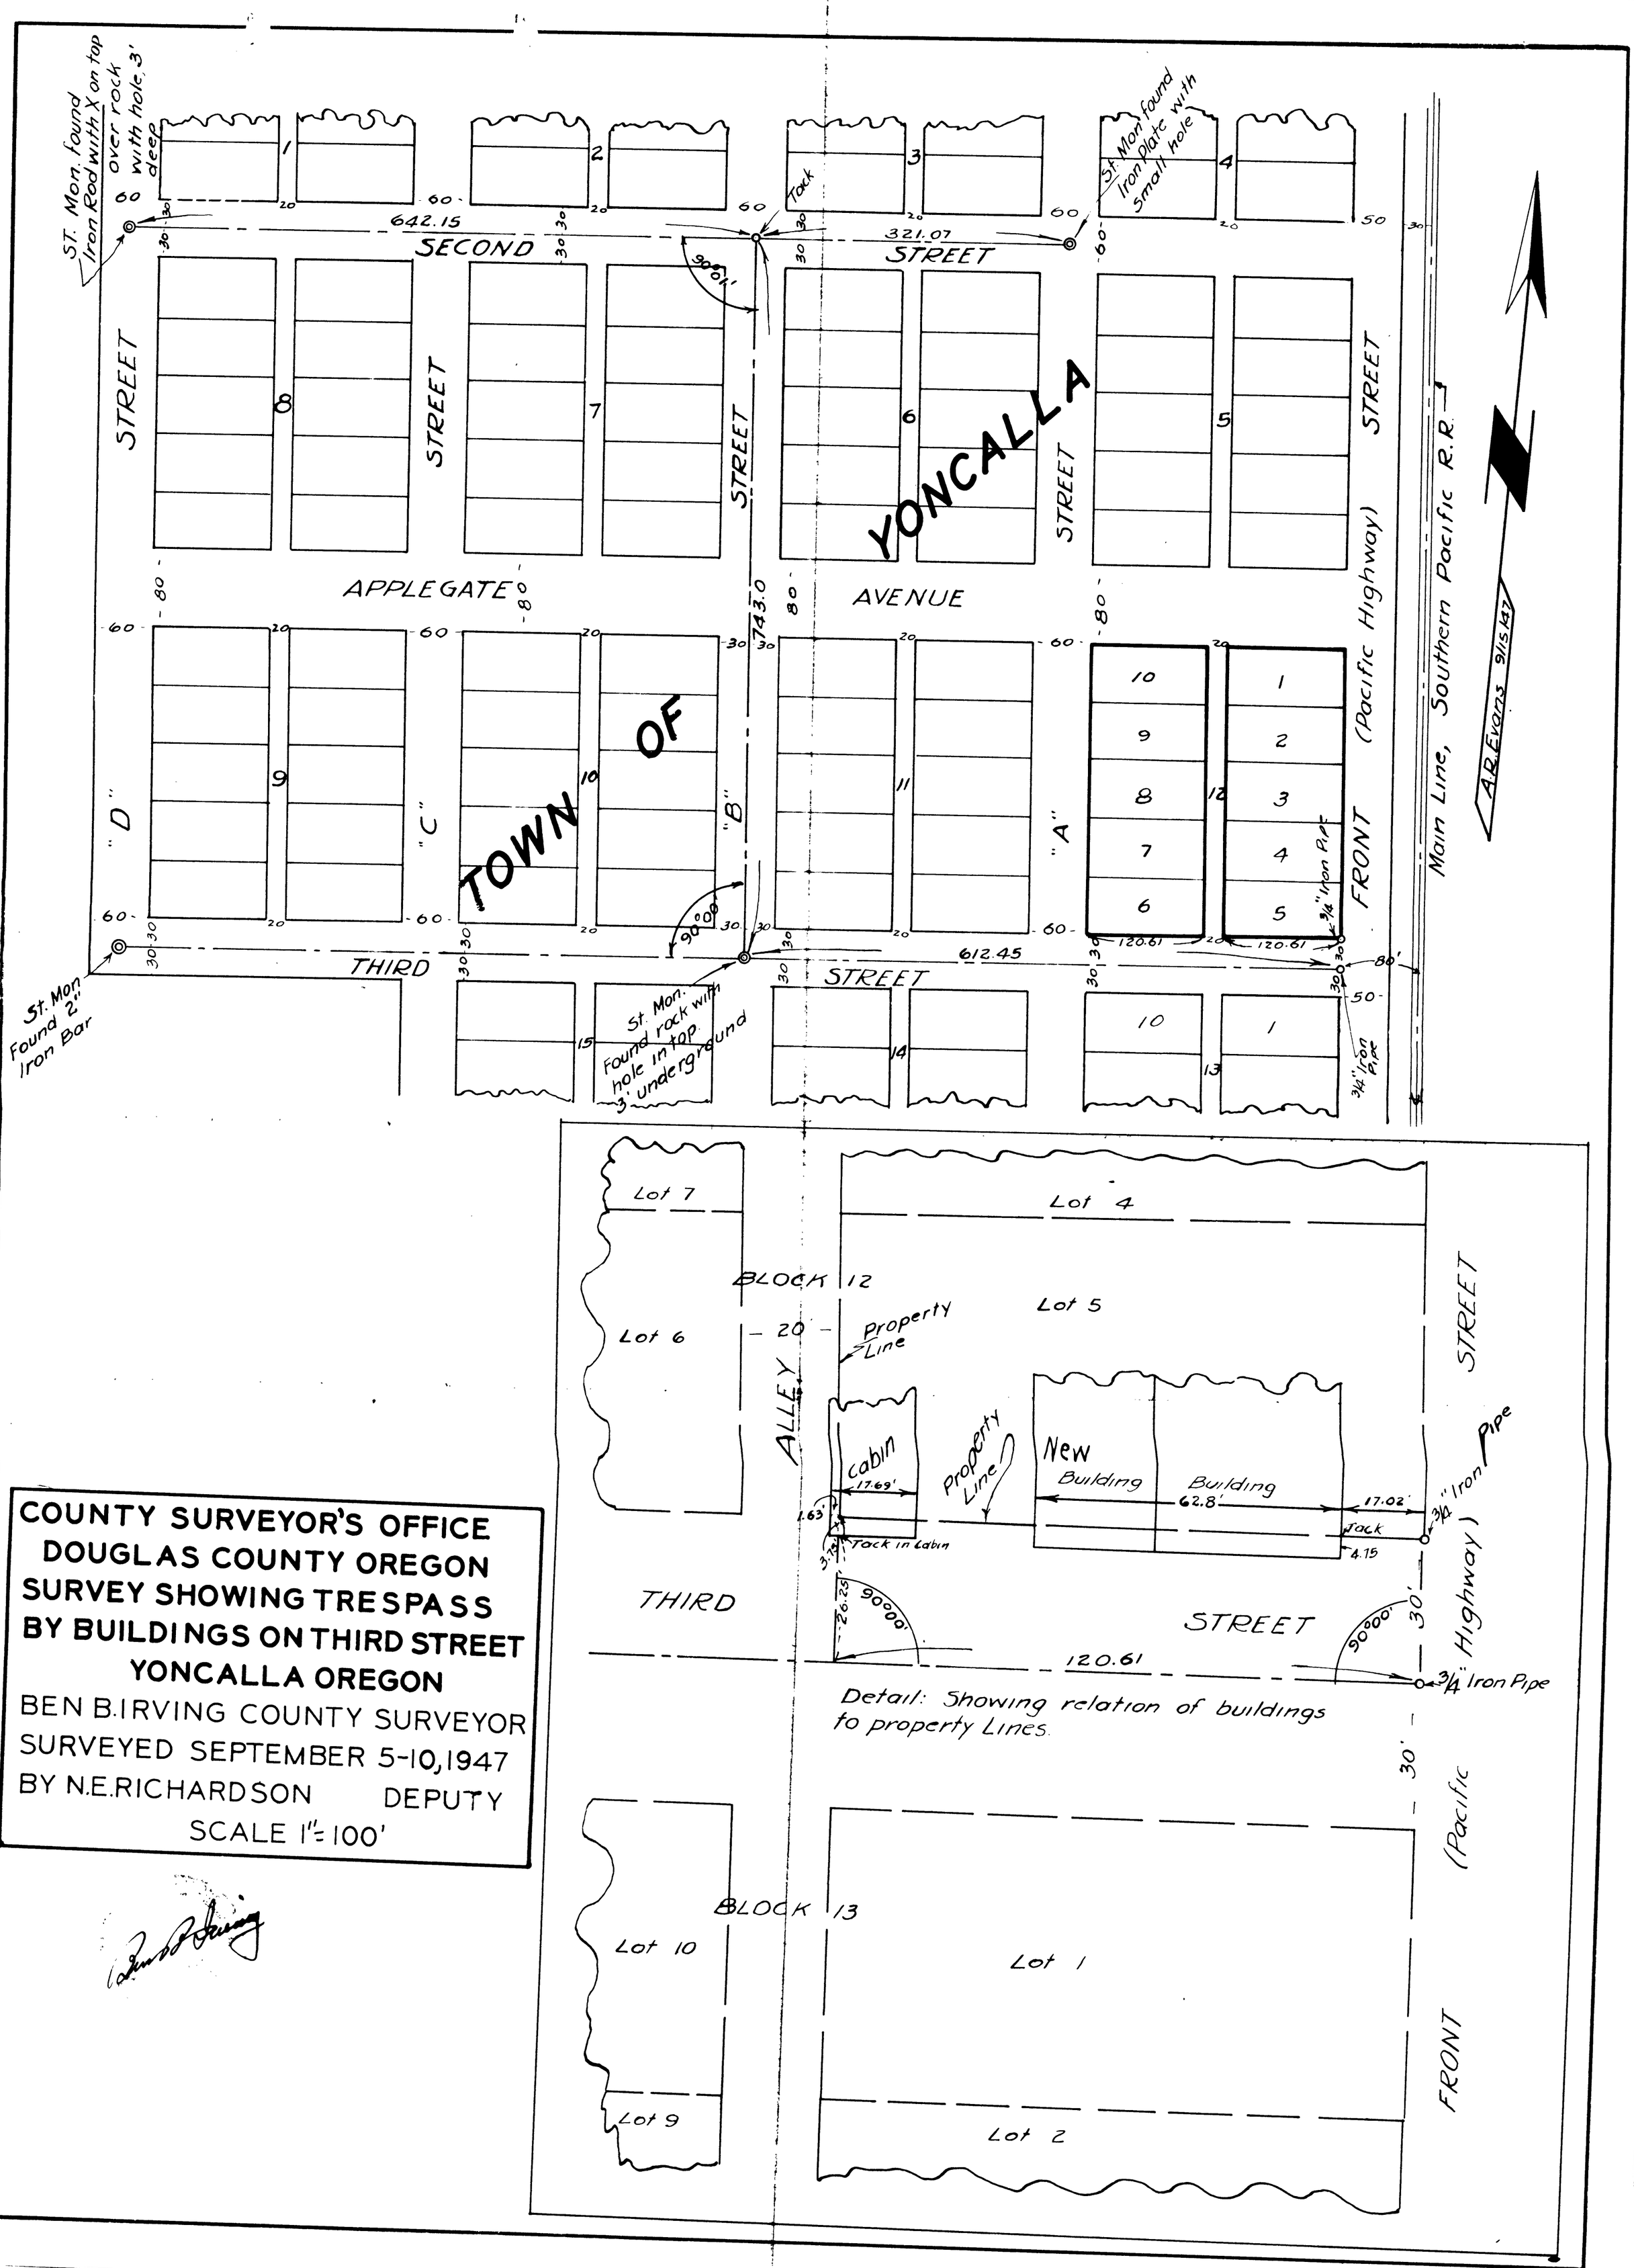

COUNTY SURVEYOR'S OFFICE
DOUGLAS COUNTY OREGON
SURVEY SHOWING TRESPASS
BY BUILDINGS ON THIRD STREET
YONCALLA OREGON

BEN B. IRVING COUNTY SURVEYOR
SURVEYED SEPTEMBER 5-10, 1947
BY N.E. RICHARDSON DEPUTY
SCALE 1" = 100'

FILE 127 DRAWER 39