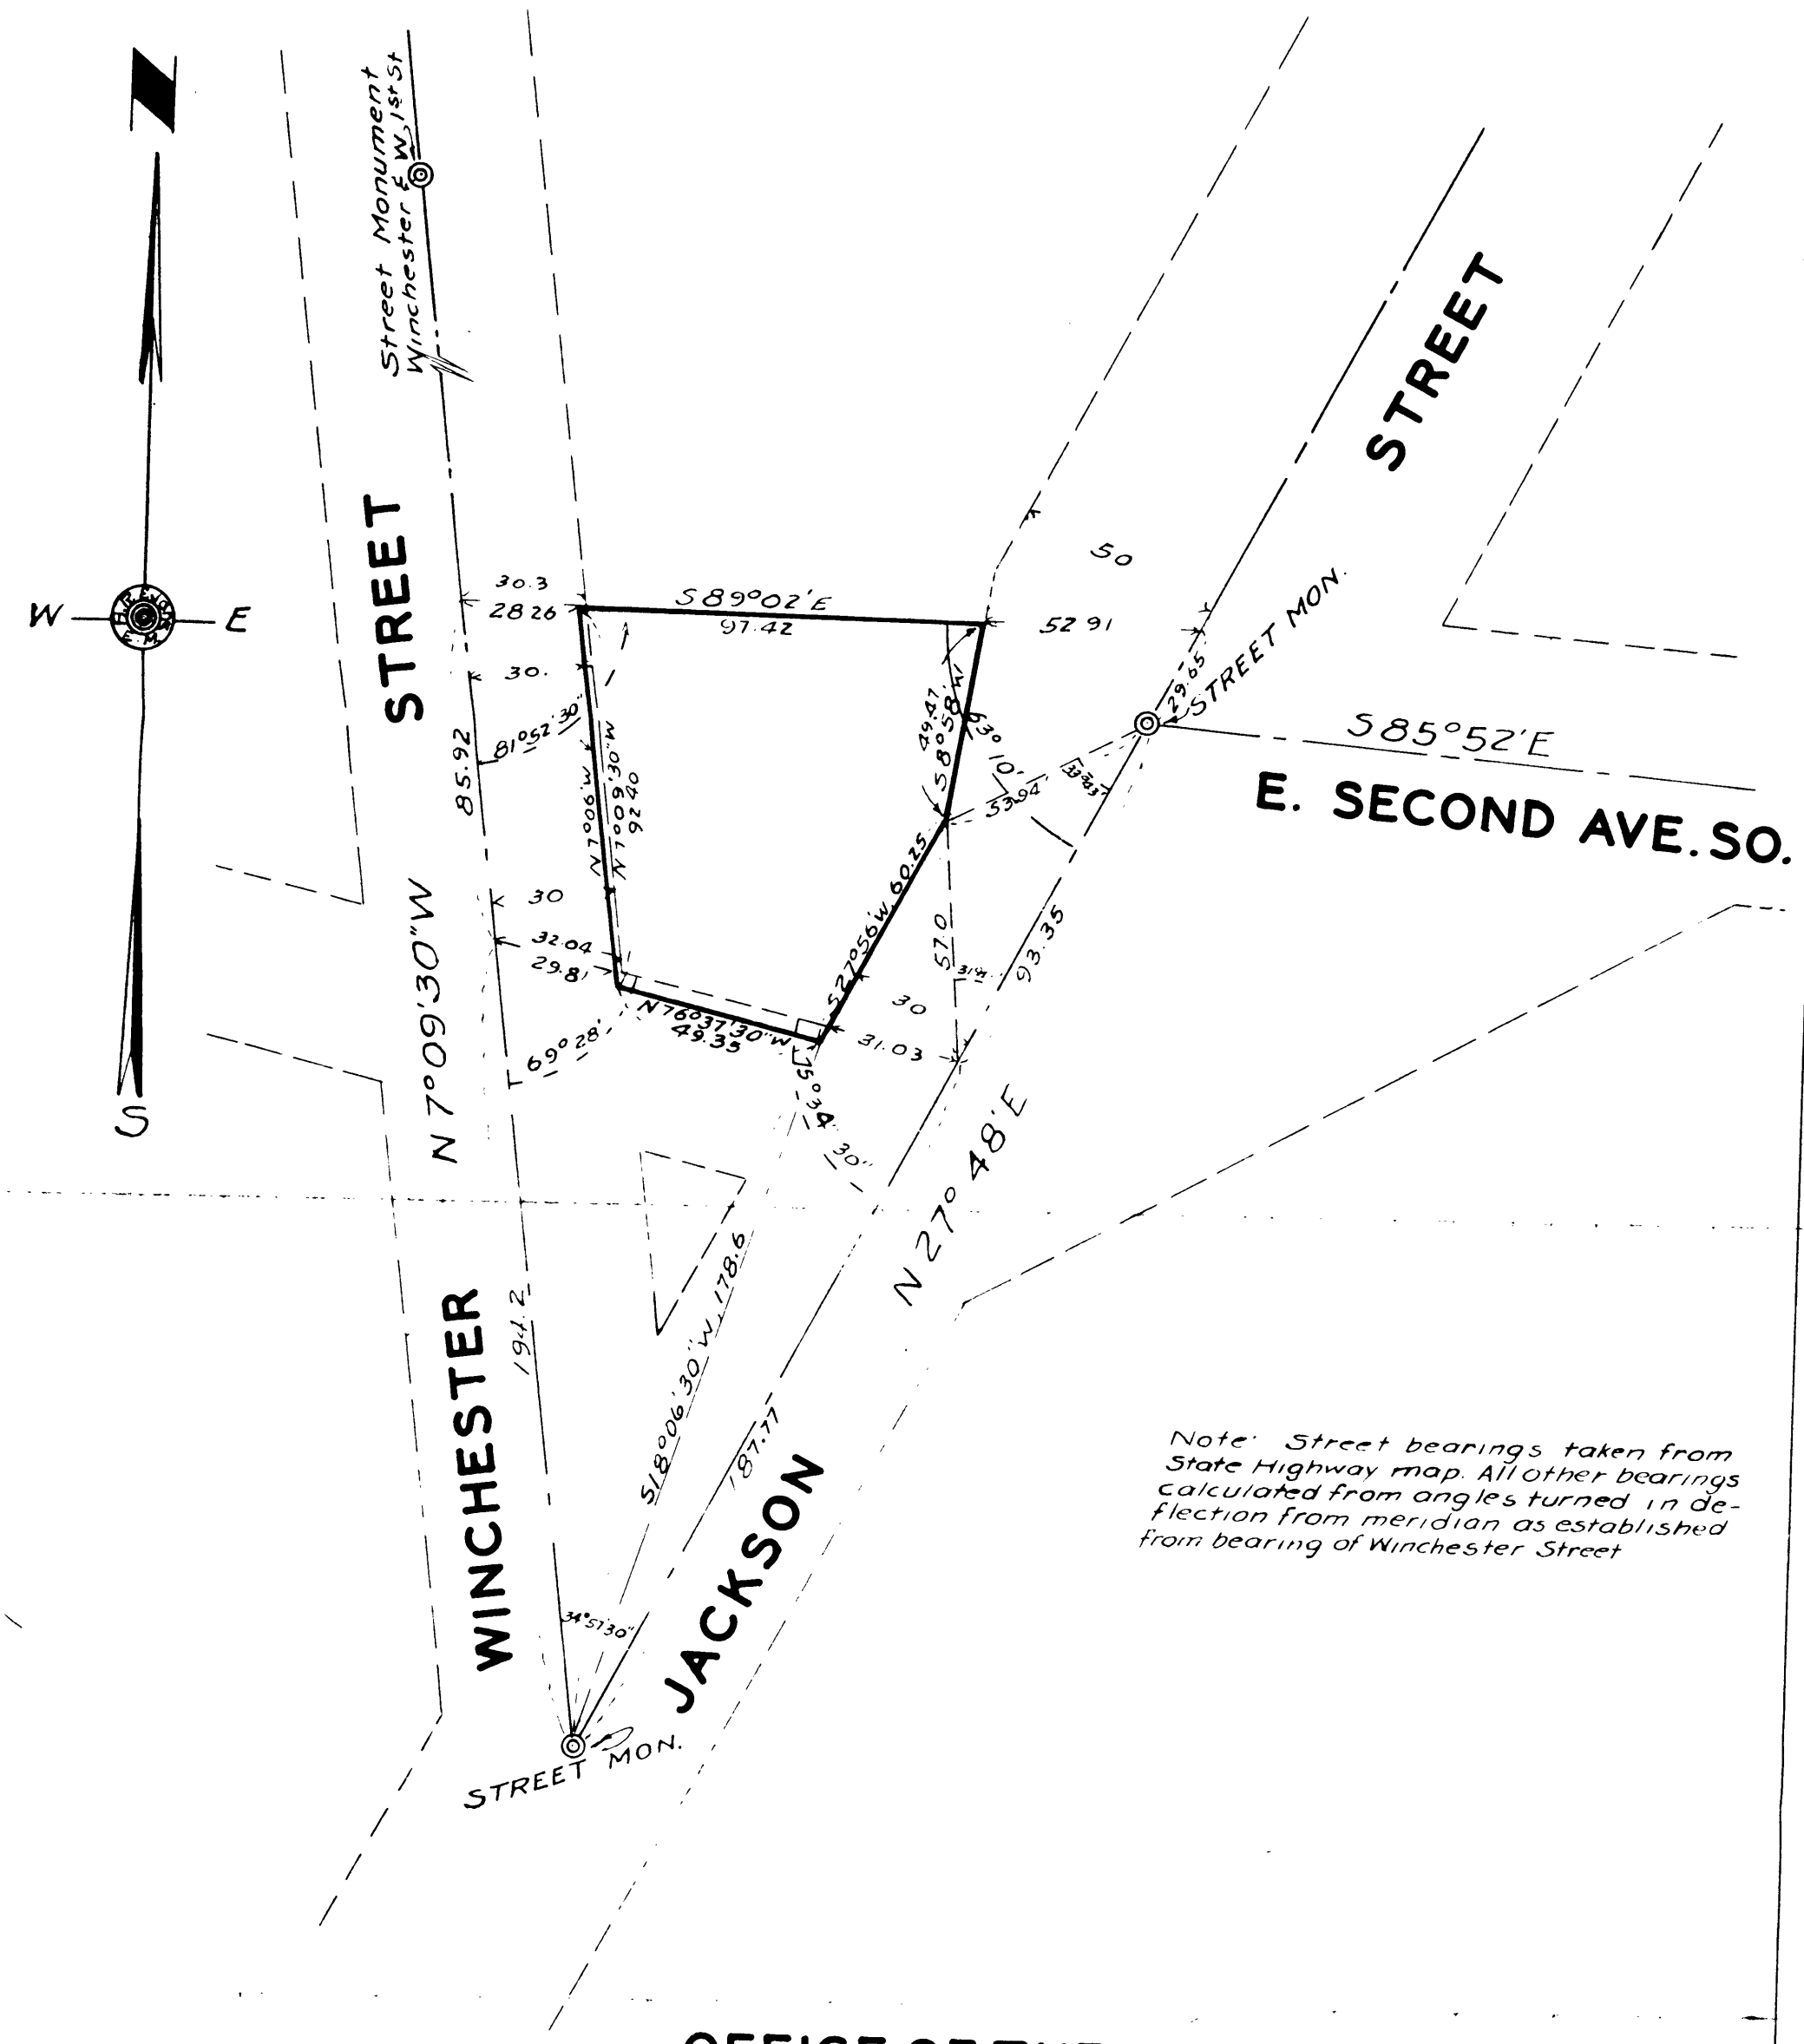

Note: Street bearings taken from State Highway map. All other bearings calculated from angles turned in deflection from meridian as established from bearing of Winchester Street

OFFICE OF THE COUNTY SURVEYOR
DOUGLAS COUNTY OREGON
SURVEY FOR DEED DESCRIPTION
NORTH SIDE APARTMENT BUILDING
NO. JACKSON AND WINCHESTER STS.
ROSEBURG OREGON

BEN B. IRVING COUNTY SURVEYOR
SURVEYED JANUARY 15 1947 BY
N.E. RICHARDSON DEPUTY
SCALE 1" = 40'

C. S. File No. 39|144-1

MAP FILE 14 34