COUNTY SURVEYORS FILE DATA
DO NOT REMOVE FROM OFFICE

SECTION 18
T.32 S., R.4 W. W.M.

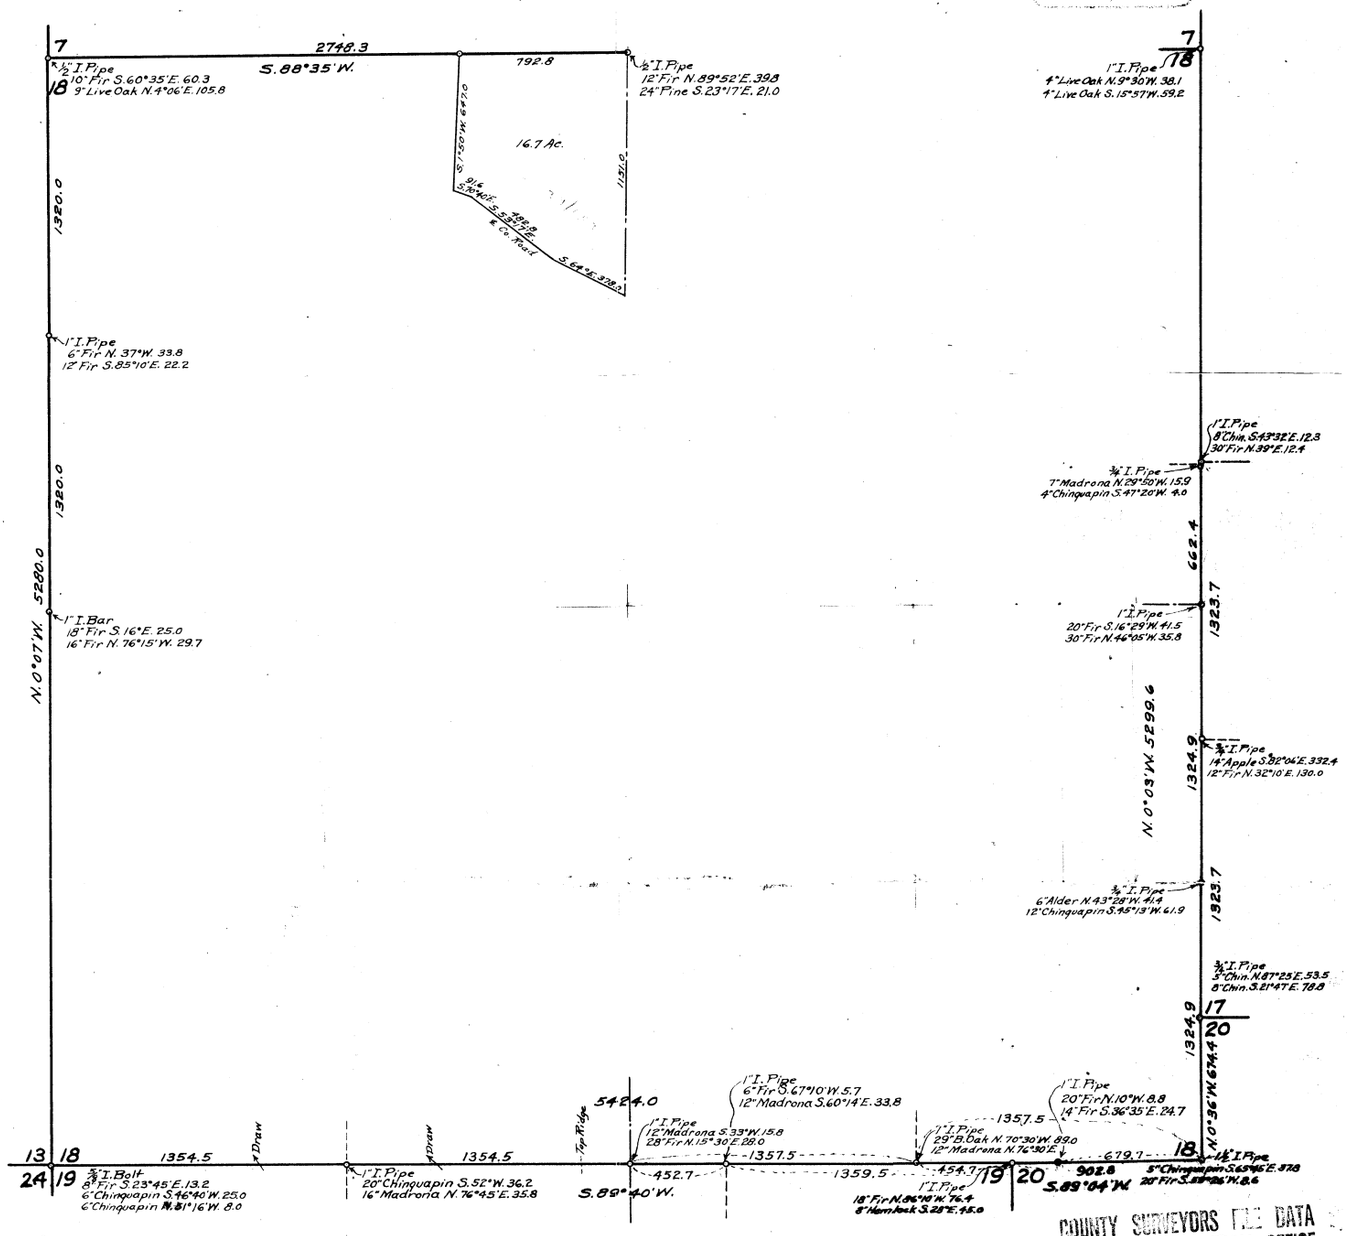

COUNTY SURVEYORS FILE DATA
DO NOT REMOVE FROM OFFICE

FILE 158 DRAWER 39 P

CS FILE FOLDER

CONTAINS

MORE

INFORMATION