


← 1955.5 ft. to Sec. Cor. to Sec. 7 & 18, T. 32 S., R. 4 W.      1/2" I. Pipe      S. 88° 35' W. 792.8      3/4" Section Corner bet. Sec. 7 & 18      3/4" I. Pipe

S. 1° 50' W. 647.0

16.7 Acres

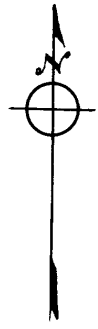

County Road      1/2" I. Pipe      91.6      S. 70° 40' E.

S. 53° 17' E. 482.8

S. 64° 00' E. 378.0

North 1151.0  
N. & S. Center line Section 18

**COUNTY SURVEYORS OFFICE  
DOUGLAS CO. OREGON  
F. J. YOUNG SURVEY  
SECTION 18, T. 32 S., R. 4 W.**

Scale 1" = 200 ft.

*Geo. J. Wenderoth*

**COUNTY SURVEYORS FILE DATA  
DO NOT REMOVE FROM OFFICE**

CS FILE FOLDER

CONTAINS

MORE

INFORMATION