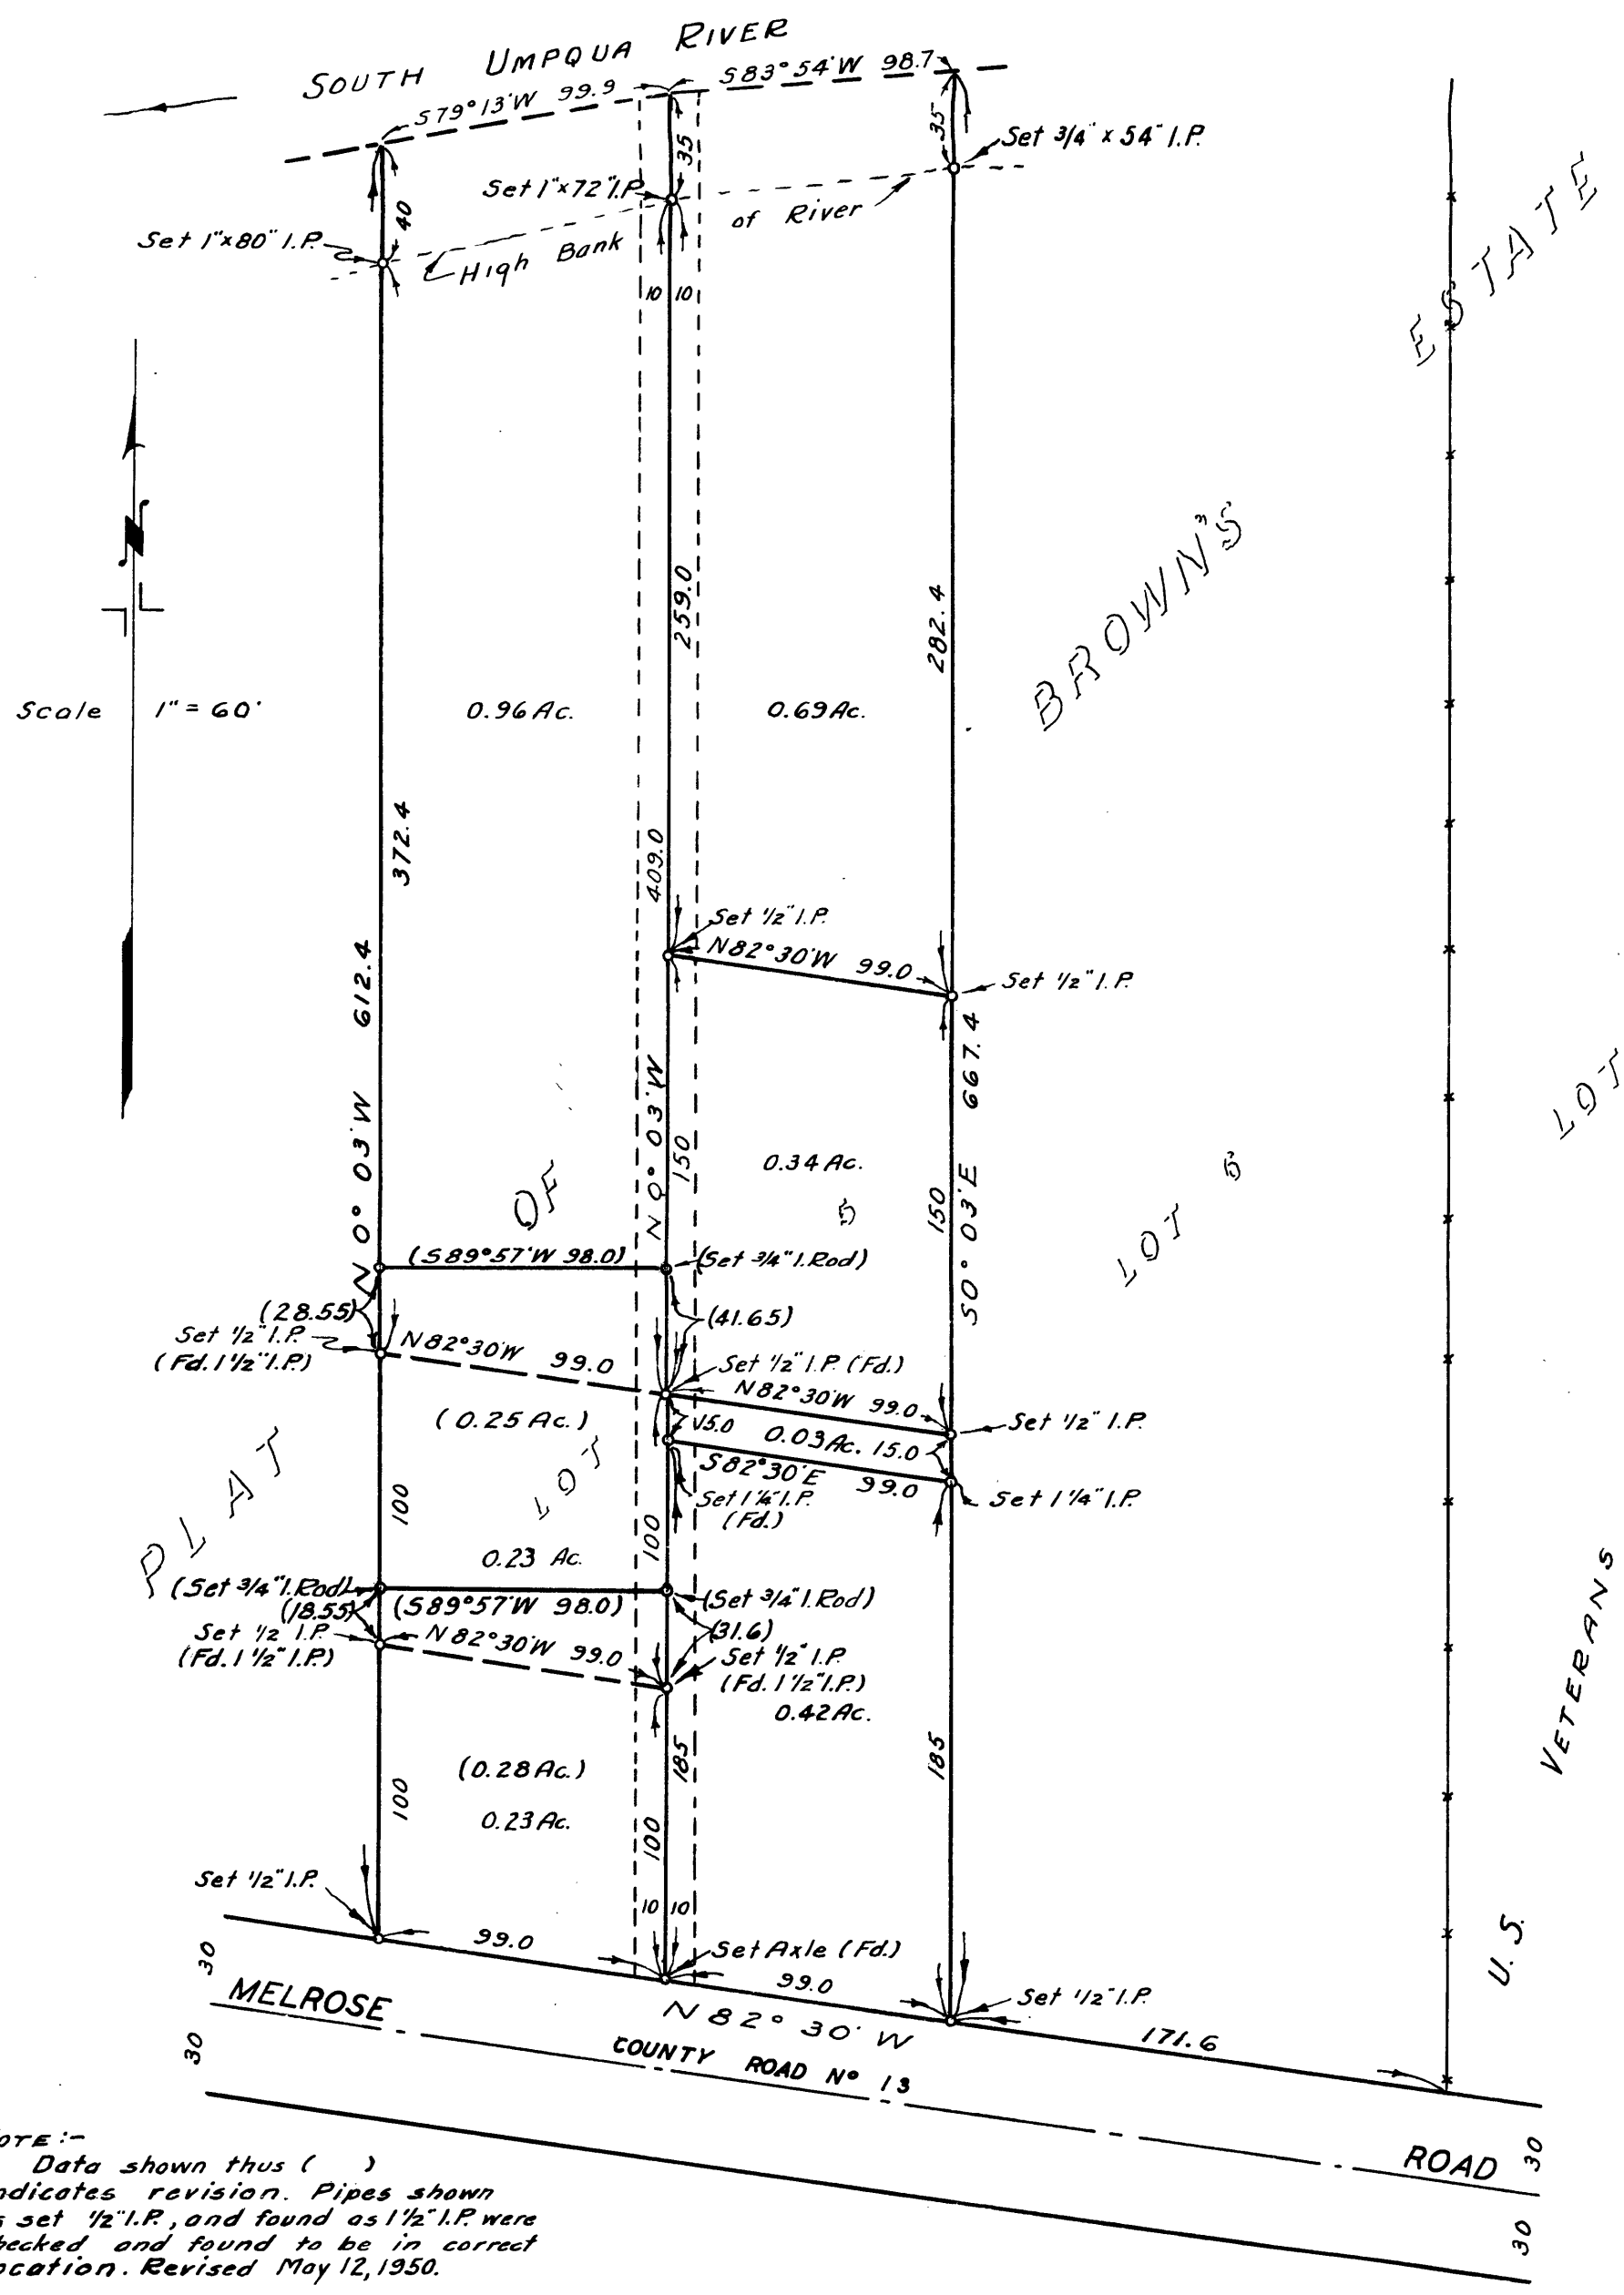

NOTE:-
Data shown thus ( ) indicates revision. Pipes shown as set 1/2" I.P., and found as 1 1/2" I.P. were checked and found to be in correct location. Revised May 12, 1950.

OFFICE OF THE COUNTY SURVEYOR
DOUGLAS COUNTY, OREGON
REVISED
SURVEY OF A PART OF LOT FIVE, PLAT OF BROWN'S ESTATE.

REGISTERED
OREGON
LAND SURVEYOR

N.E. Richardson
JULY 7, 1944
N. E. RICHARDSON
35

BEN. B. IRVING COUNTY SURVEYOR
SURVEYED APRIL 23, 1948 BY N.E. RICHARDSON. DEP.

COUNTY SURVEYORS FILE DATA
DO NOT REMOVE FROM OFFICE

T27S R6W

5

FILE 168 DRAWER 39