FILE TO DRAWER 40
P

COUNTY SURVEYORS FILE DATA
DO NOT REMOVE FROM OFFICE

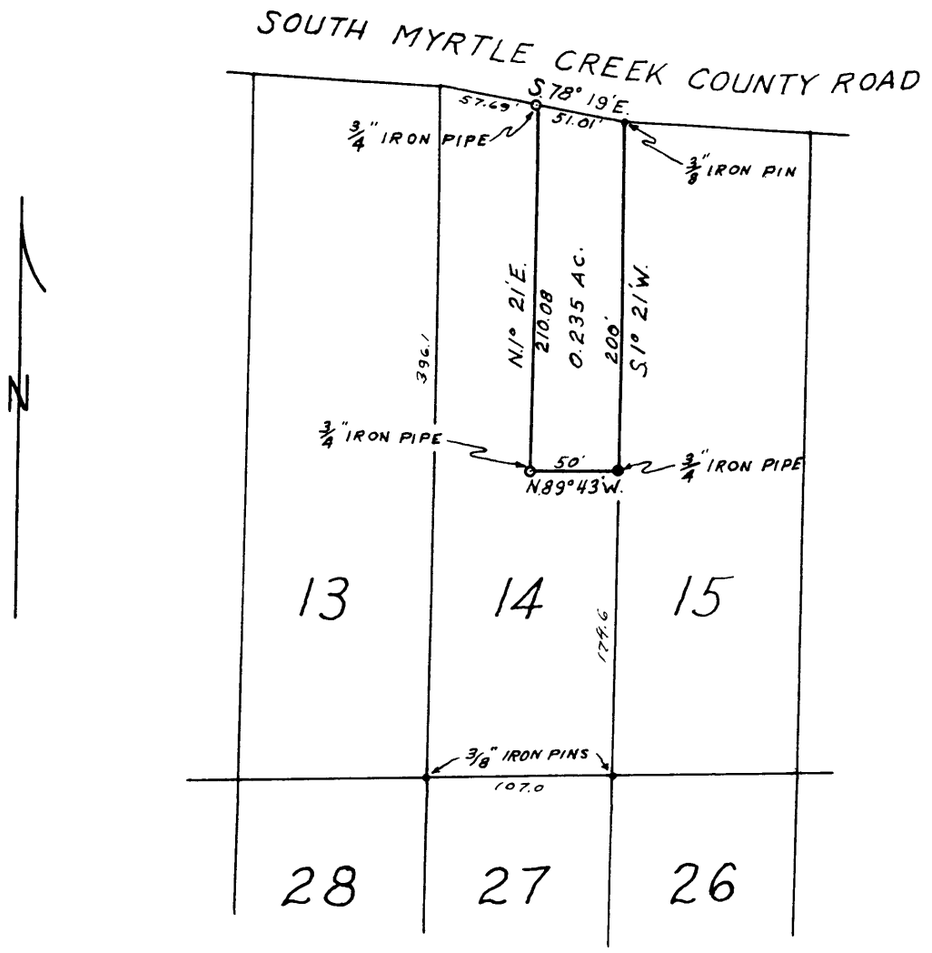

SUBDIVISION OF
LOT 14, HERMANN'S SECOND SUBDIVISION
SECTION 27, T. 29 S - R 5 W. W. M.
DOUGLAS CO., ORE.

FOR DURWOOD D. SHORT - MYRTLE CREEK, ORE.
SURVEY BY: C.S. COLLINS - O.R.L.S. Nº 176
JAN. 12, 1948 SCALE: 1 IN. = 100 FT.

FIELD NOTES

January 12, 1948

Subdivision of Lot 14,
Hermann's Second Subdivision

Section 27, T29S, R5W, W. M.
Douglas County, Oregon

For: Durwood D. Short:

I find a 3/8 inch iron rod as described on the official plot at the northeast corner of Lot 14. Beginning at that point I run S. 1° 21' W 200.00 feet toward the southeast corner of said Lot 14 which is also a 3/8" iron rod clearly marked with a stake. At the 200.00 foot mark I set a 3/4 inch iron pipe. Thence I run as follows:

N 89° 43' W 50.00 feet and set a 3/4 inch iron pipe thence; N 1° 21' E 210.08 feet and set a 3/4 inch iron pipe thence; S 78° 19' E 51.01 feet to the point of beginning.

All of the original corners of Lot 14, were found except for the northeast corner, and all were marked with 3/8" iron rods.

All monuments set by me were 3/4 inch diameter iron pipes marked near the top with the figure "176" stamped into the pipe.

Charles S. Collins

C. S. File No. 40/70