GLEN D HART TRACT

DOUGLAS CO OREGON

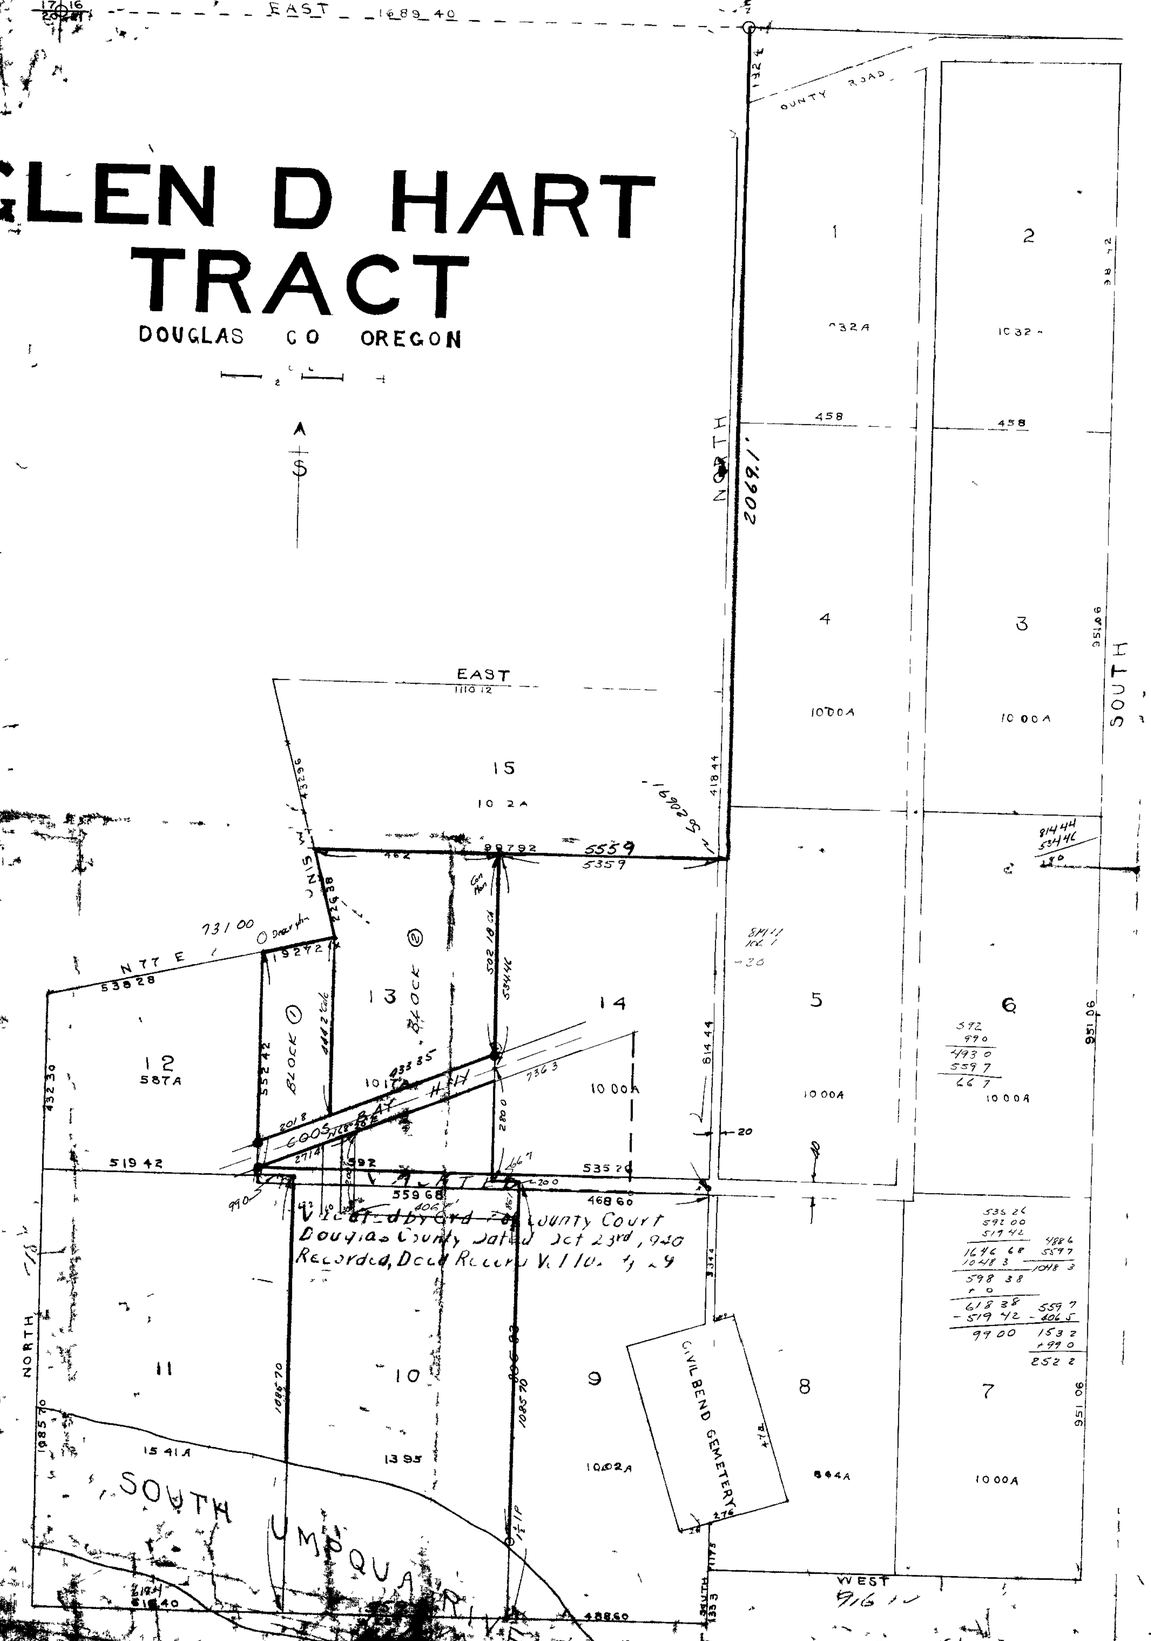

STATE OF OREGON]
COUNTY OF DOUGLAS] ss

[illegible]

APPROVED [illegible]

COUNTY [illegible]

APPROVED 3/4/1

COUNTY [illegible]

APPROVED [illegible]

COUNTY [illegible]

DEDICATION

KNOW ALL MEN BY THESE PRESENTS that the W C Harding Land Company a corporation, duly incorporated and existing under and by virtue of the laws of the State of Oregon owner of the real property represented and described in the within map and located in Section 21, Township 28 South Range 6 West, W M, Douglas County, State of Oregon, does by these presents plat and establish the said plat of real property as and by the name of the GLEN D HART TRACT and it does hereby declare the annexed map and plat is a true and correct plat that the lots and parcels shown and designated upon the within plat are correct and conform with our wish and we hereby dedicate to the public use forever the roads shown on said plat

In witness whereof the said W C Harding Land Company has caused this instrument to be signed by its President and Secretary and has caused its corporate seal to be affixed hereto

W C Harding Land Company

(Seal)

By W C Harding President

By L B Wallace Secretary

State of Oregon }
County of Douglas } ss

On the 3rd day of March 1911 before me appeared W C Harding, to me personally known who being duly sworn did say that he is President of the W C Harding Land Company, and L B Wallace, to me personally known who being duly sworn did say that he is Secretary of the W C Harding Land Company, a corporation and that the seal affixed to the within instrument is the corporate seal of said corporation and the said W C Harding and L B Wallace do hereby affirm that they signed the above certificate of dedication as their voluntary act and deed as officers of said corporation and further acknowledged that said instrument was the free act and deed of the W C Harding Land Company

In testimony where of I have hereunto set my hand and seal the day and year above written.

[illegible]

Co 40/73-1