DESCRIPTION OF SURVEY FOR LESTER JOHNSON AND GEORGE BOWMAN
Sec. 4, T. 22 S., R. 12 W.

Beginning at a 3/4" pipe, said pipe being the 1/4 cor. of Sec. 4 and 3, T. 22 S., R. 12 W. of the Willamette Meridian; thence S. 0°45'E. along the line between sections 4 and 3, 208.7 ft. to a ½" pipe; thence S. 87°22'50" W., along the north boundary of a private road, 1940.93 ft. to a 3/4" pipe; thence N. 45°22' E., along the east boundary of The Roosevelt Highway, 313.30 ft. to a 3/4" pipe, said pipe being on the north line of the south ½ of section 4; thence N. 87°25' E., along said north line, 1715.00 ft to the point of beginning, containing 8.78 acres, all being situated in the north ½ of the southeast ¼ of Section 4, T. 22 S., R. 12 W. of the Willamette Meridian in Douglas County, State Of Oregon.

I certify that I, Francis L. Hicok, surveyed the above described piece of property and set pipes as shown on the the included plat.

REGISTERED
OREGON
LAND SURVEYOR

SEPT. 6, 1946
FRANCIS L. HICOK
185

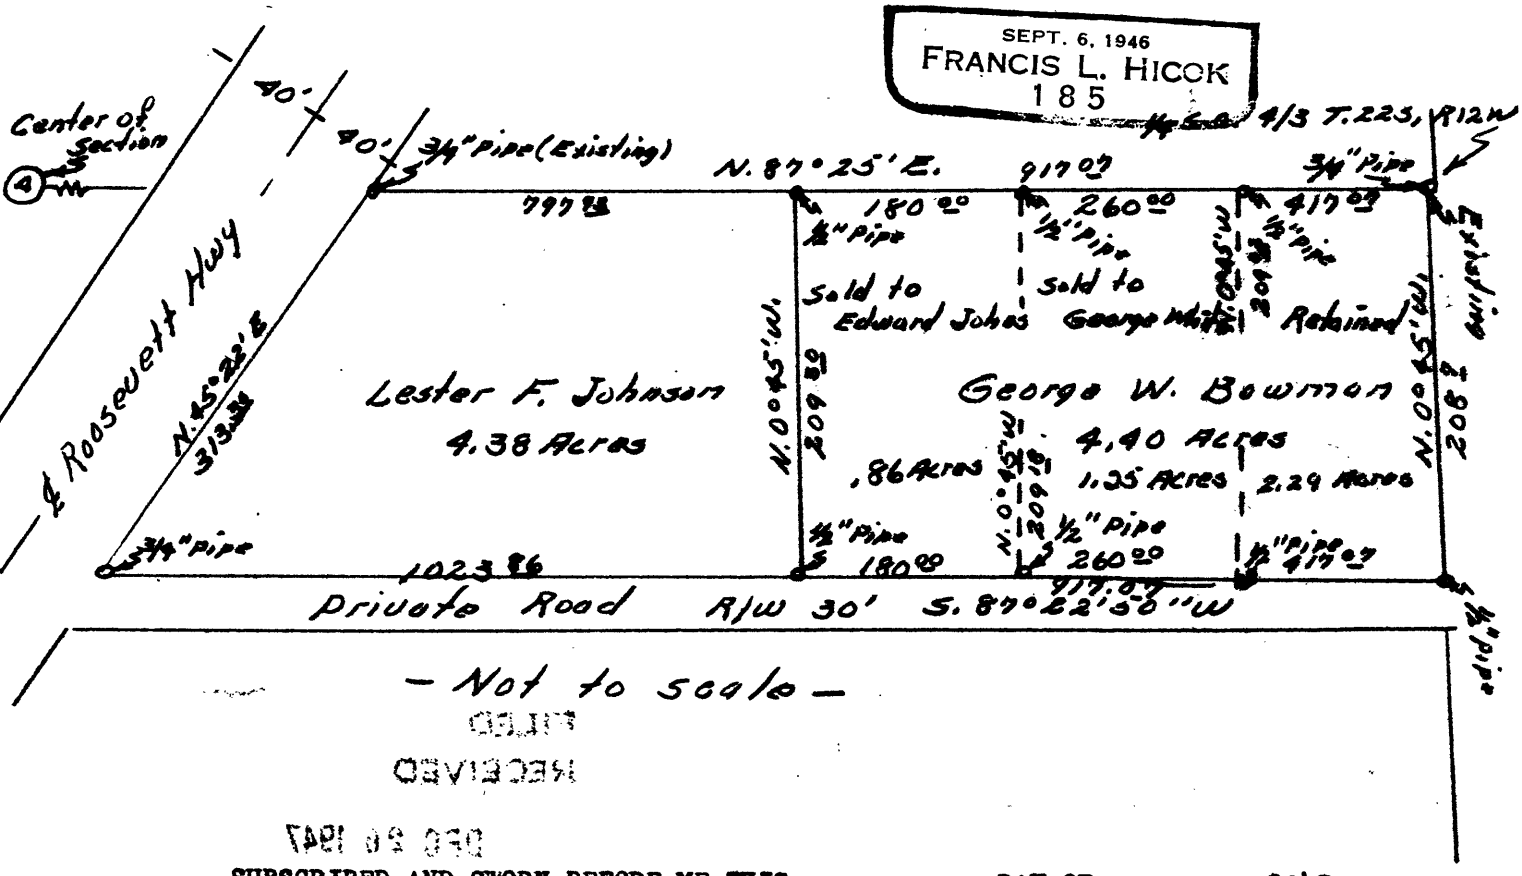

SUBSCRIBED AND SWORN BEFORE ME THIS DAY OF 1947

NOTARY PUBLIC, STATE OF OREGON

MY COMMISSION EXPIRES

C. S. File No. 40|84

CS FILE FOLDER

CONTAINS

MORE

INFORMATION