

PLAT OF
EAST 1/2 OF LOTS 8 & 9
AND LOT 10
BLOCK 1
WEST ROSEBURG
ROSEBURG, DOUGLAS CO., ORE.
OCTOBER SCALE: 1" = 50'

COUNTY SURVEYORS FILE DATA
DO NOT REMOVE FROM OFFICE

T275 R6W 36E 24

LENOIR KRUSE SURVEY

To locate lines. East $\frac{1}{2}$ of Lots 8 and 9 and Lot 10, Block 1 of West Roseburg


I locate street center line between monuments on Harvard Avenue and Corby Street, offset 30.0 ft. to lot lines. I find pipes at the S.E. and S.W. corners of Lot 5. I produce this line West 100.0 ft. and set pipe for the S.W. corner of Lot 10. I locate the N.E. corner of Lot 6 at the intersection of the right of way lines of Harvard Avenue and Corby Street which point is occupied by a fence post, from this point I run West along the South side of Harvard Avenue 100.0 ft. to the N.E. corner of Lot 8, 200.0 ft. to the N.W. corner of Lot 8.

From the S.W. corner of Lot 10 I chain North on line with N.W. corner of Lot 8 50.0 ft. and set the N.W. corner of Lot 10.

From the S.E. corner of Lot 10 I chain North on line with the N.E. corner of Lot 8, 50.0 ft. and set the N.E. corner of Lot 10.

I then lay off 50.0 ft. along the North line of Lot 10 and 50.0 ft. along the North line of Lot 8 and connect these points as the dividing line of the East $\frac{1}{2}$ and West $\frac{1}{2}$ of Lots 8 and 9.

Kelser Burgoyne, Chainman

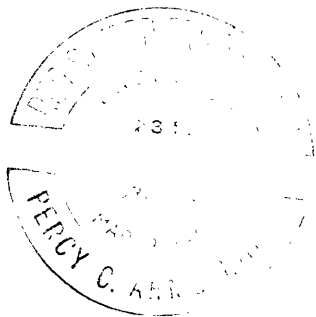

FILED
RECEIVED

FEB 20 1948

COUNTY SURVEYOR
DOUGLAS COUNTY, ORE.

40/90