MAP OF PROPERTY OF CARL J. KITE and ELEANOR B. LINN

SEC. 21, T30S, R5W, W.M.

SCALE ~ 1-inch = 200 feet

FILED
RECEIVED
JUN 9 1961
COUNTY SURVEYOR
DOUGLAS COUNTY, ORE.

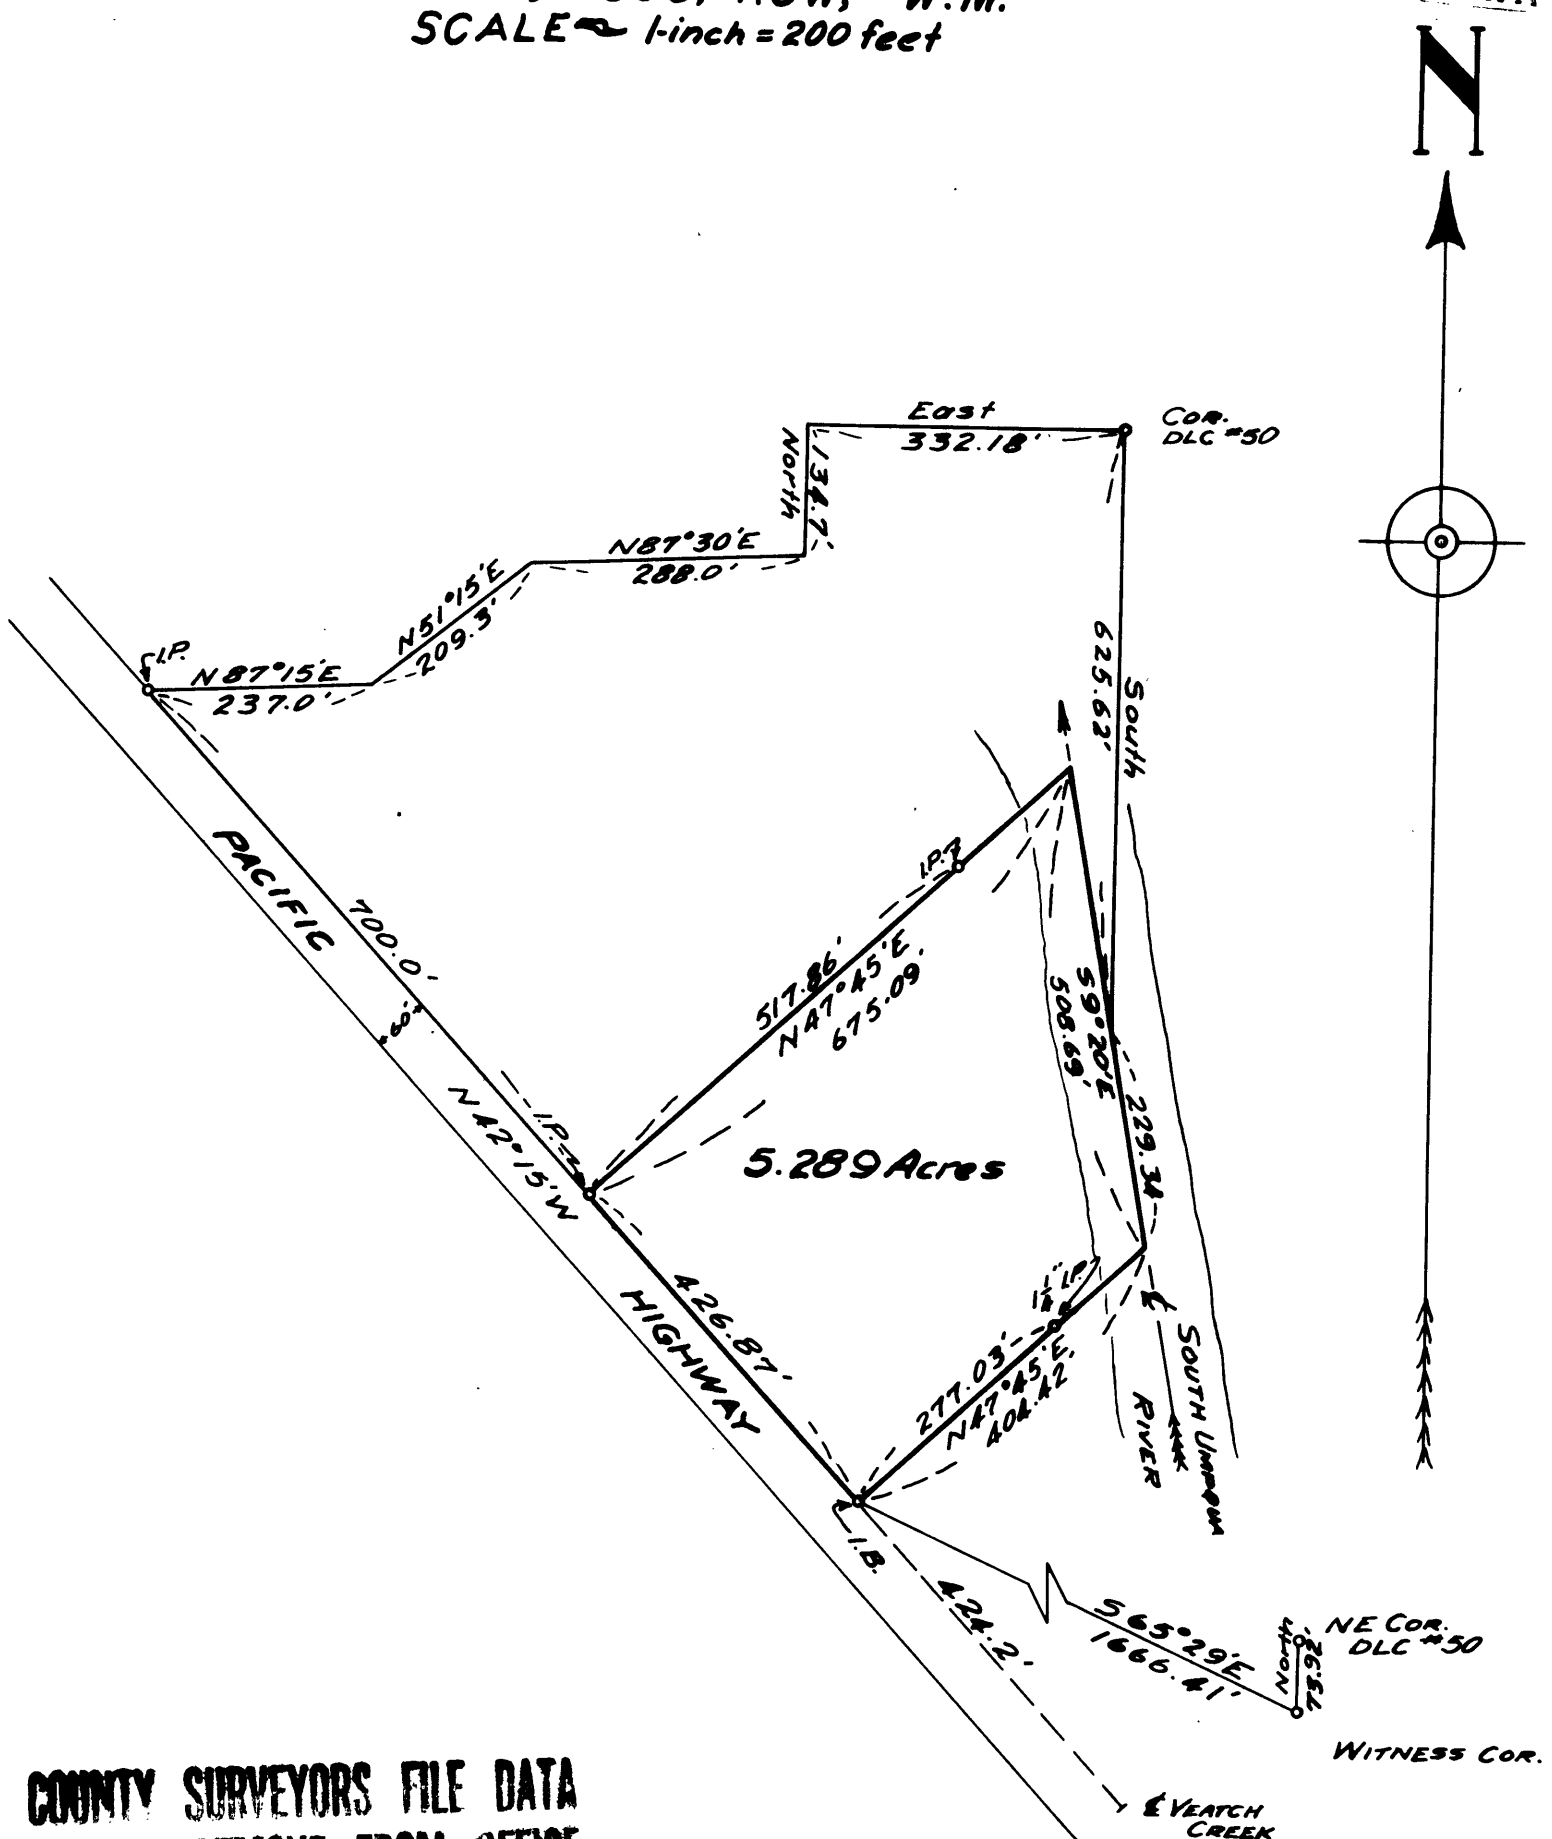

COUNTY SURVEYORS FILE DATA
DO NOT REMOVE FROM OFFICE

C.S. 40/121