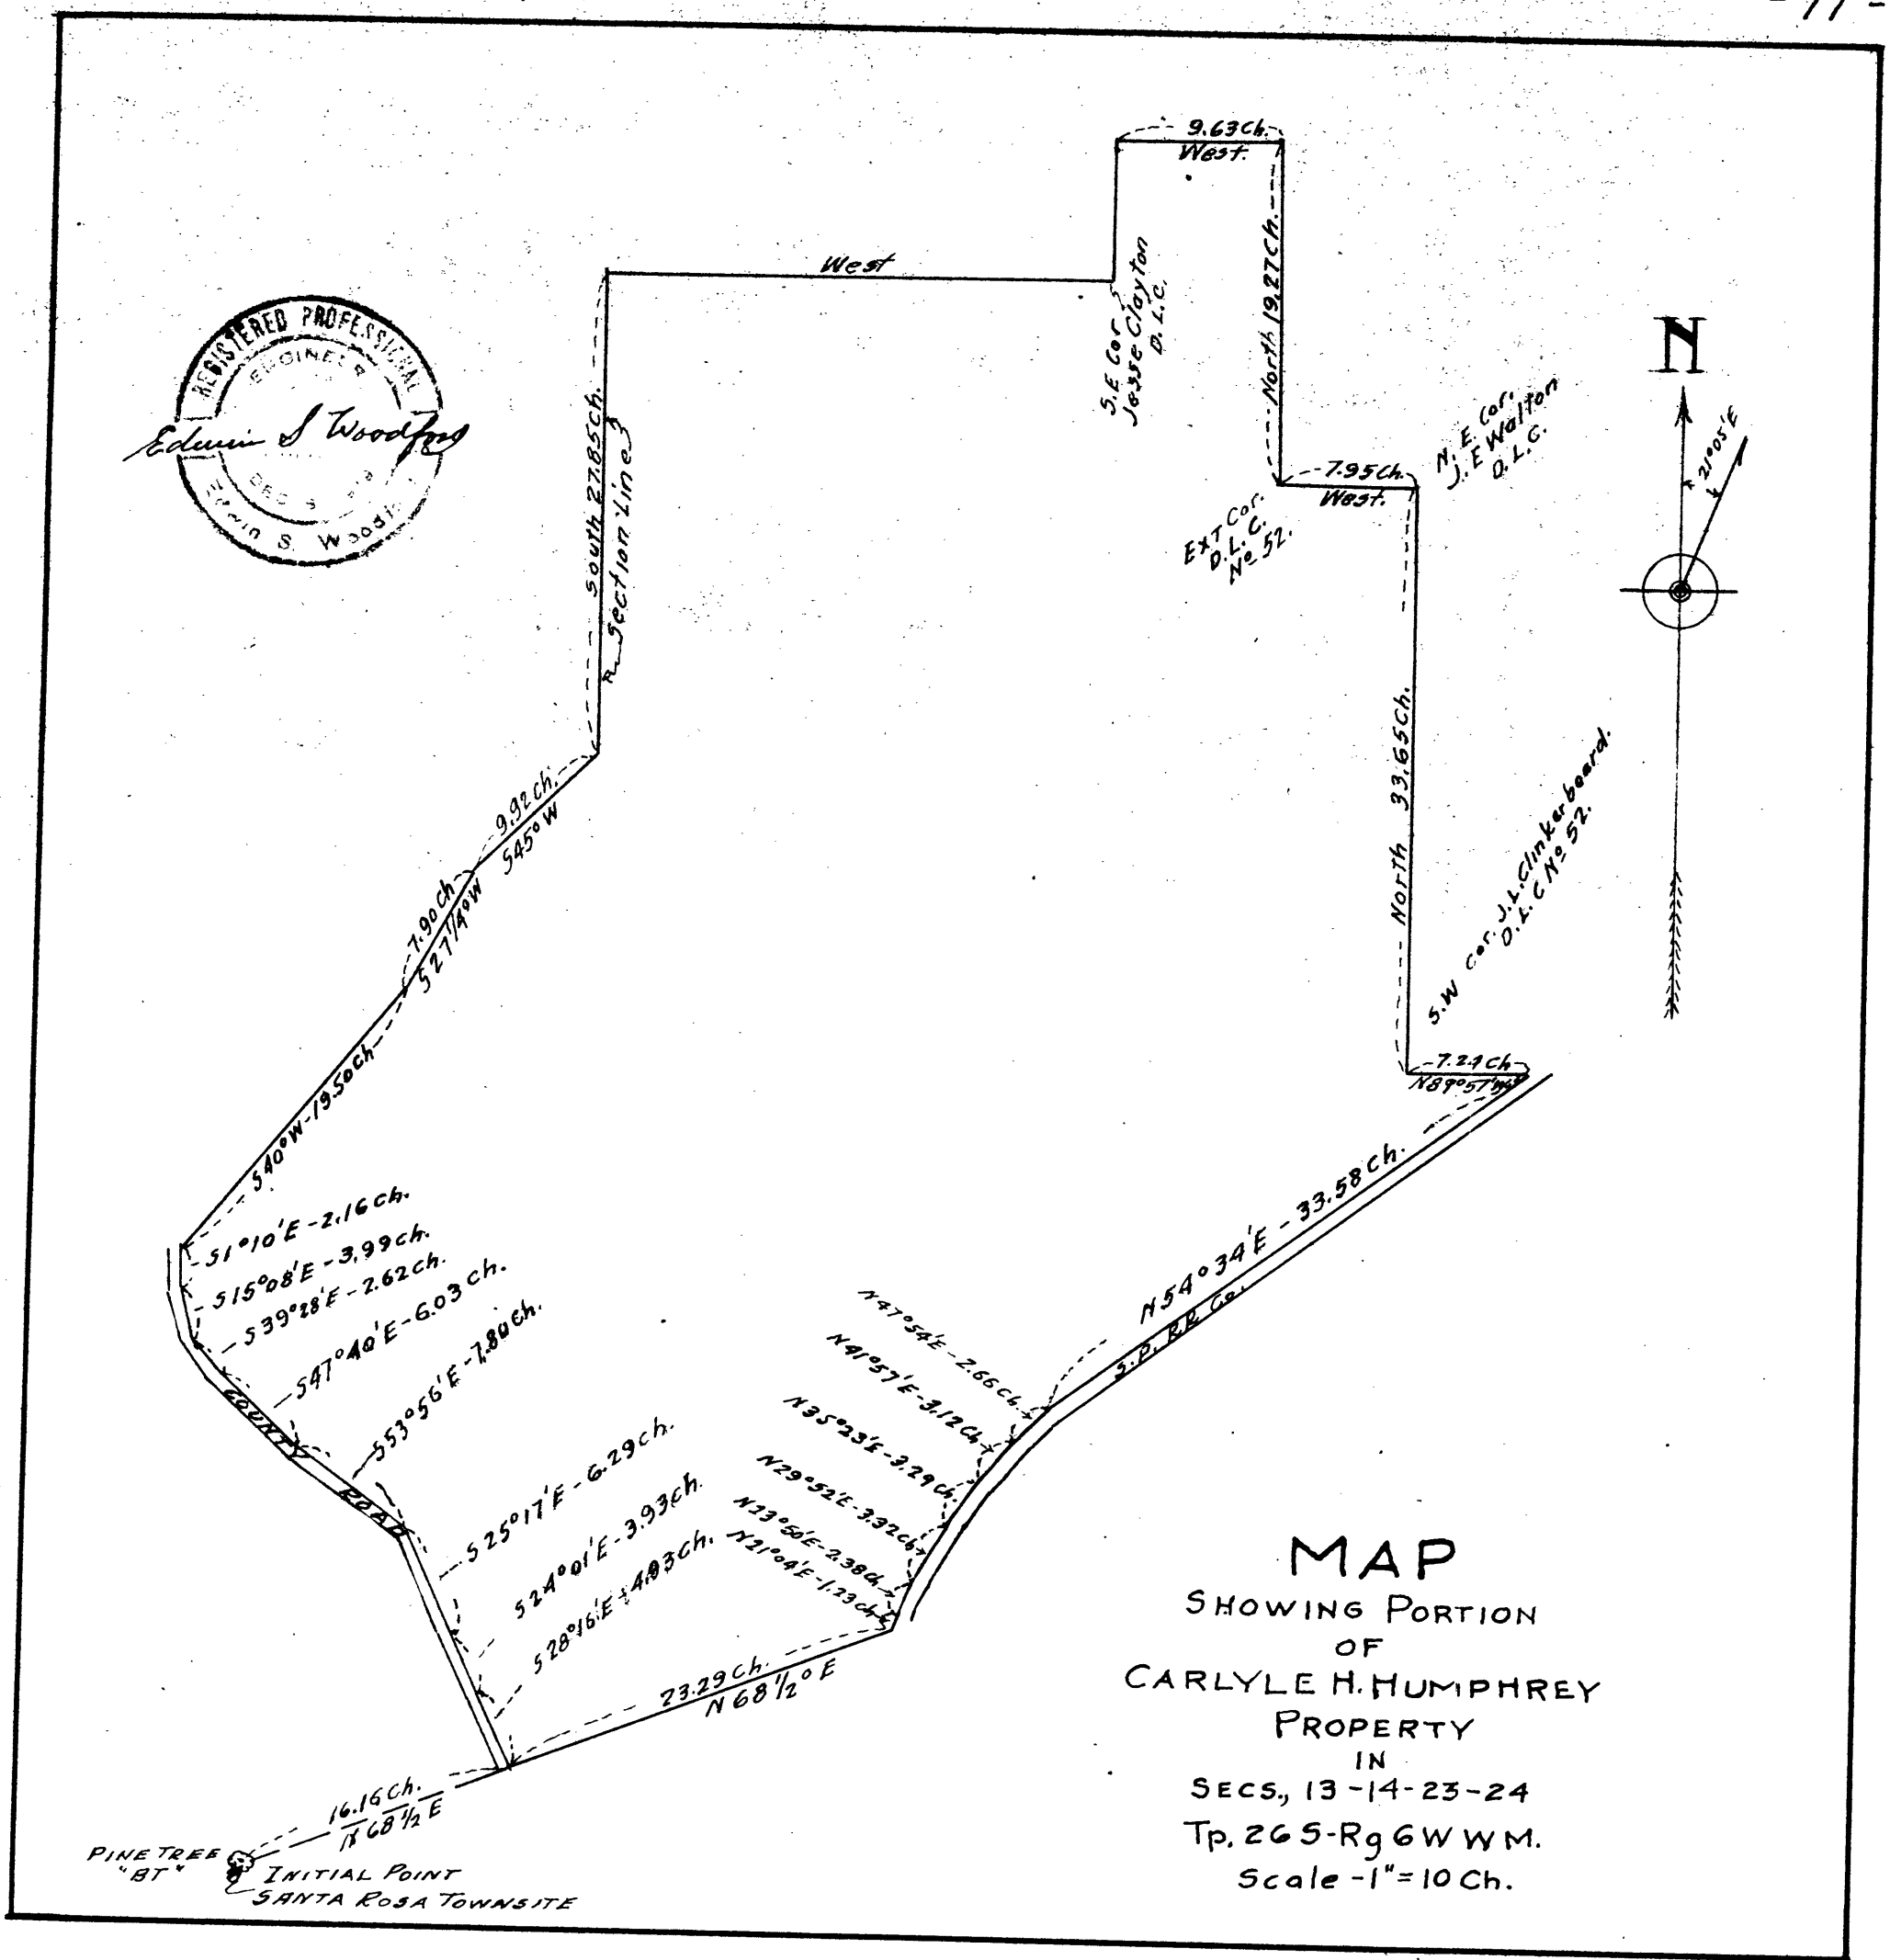

MAP
SHOWING PORTION
OF
CARLYLE H. HUMPHREY
PROPERTY
IN
SECS., 13-14-23-24
Tp. 26 S-Rg 6 W W.M.
Scale - 1" = 10 Ch.

ORIGINAL TRACING IN CS 42/103-2

FILE 123 DRAWER 40
CS 40/123-1