-97

Bess Rasmussen

COUNTY SURVEYORS FILE DATA
DO NOT REMOVE FROM OFFICE

FILED
APPROVED
COUNTY SURVEYOR
DOUGLAS COUNTY, ORE.

MAP OF PARTS OF LOTS - 20 and 21 1st BROOKSIDE ADDITION TO ROSEBURG OREGON

Sec. 20 - Tp. 27S - Rg. 5W WM.

Scale - 1" = 40'

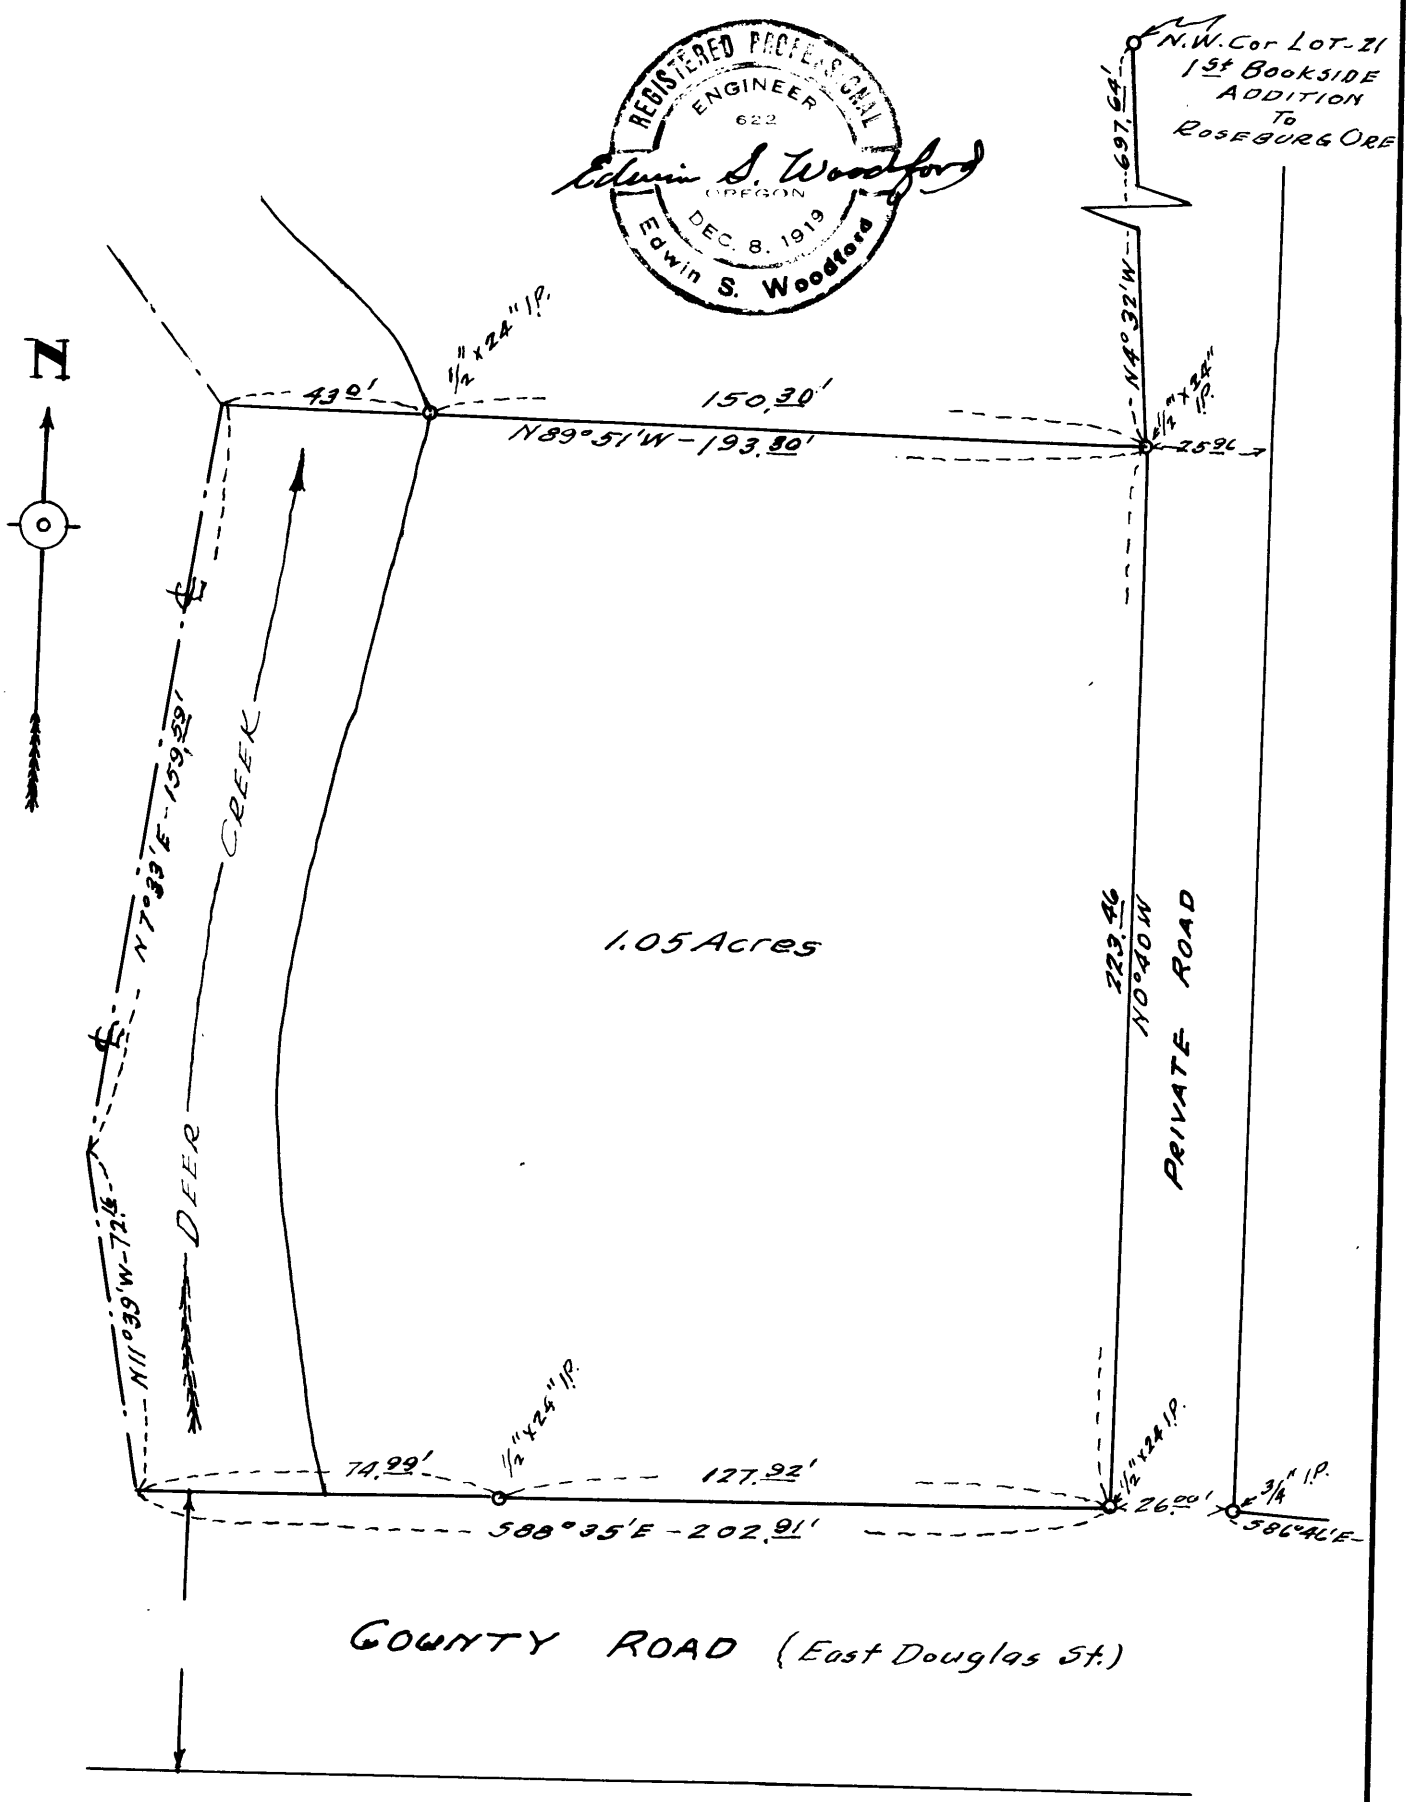

C.S. 40/146-2

CS FILE FOLDER

CONTAINS

MORE

INFORMATION