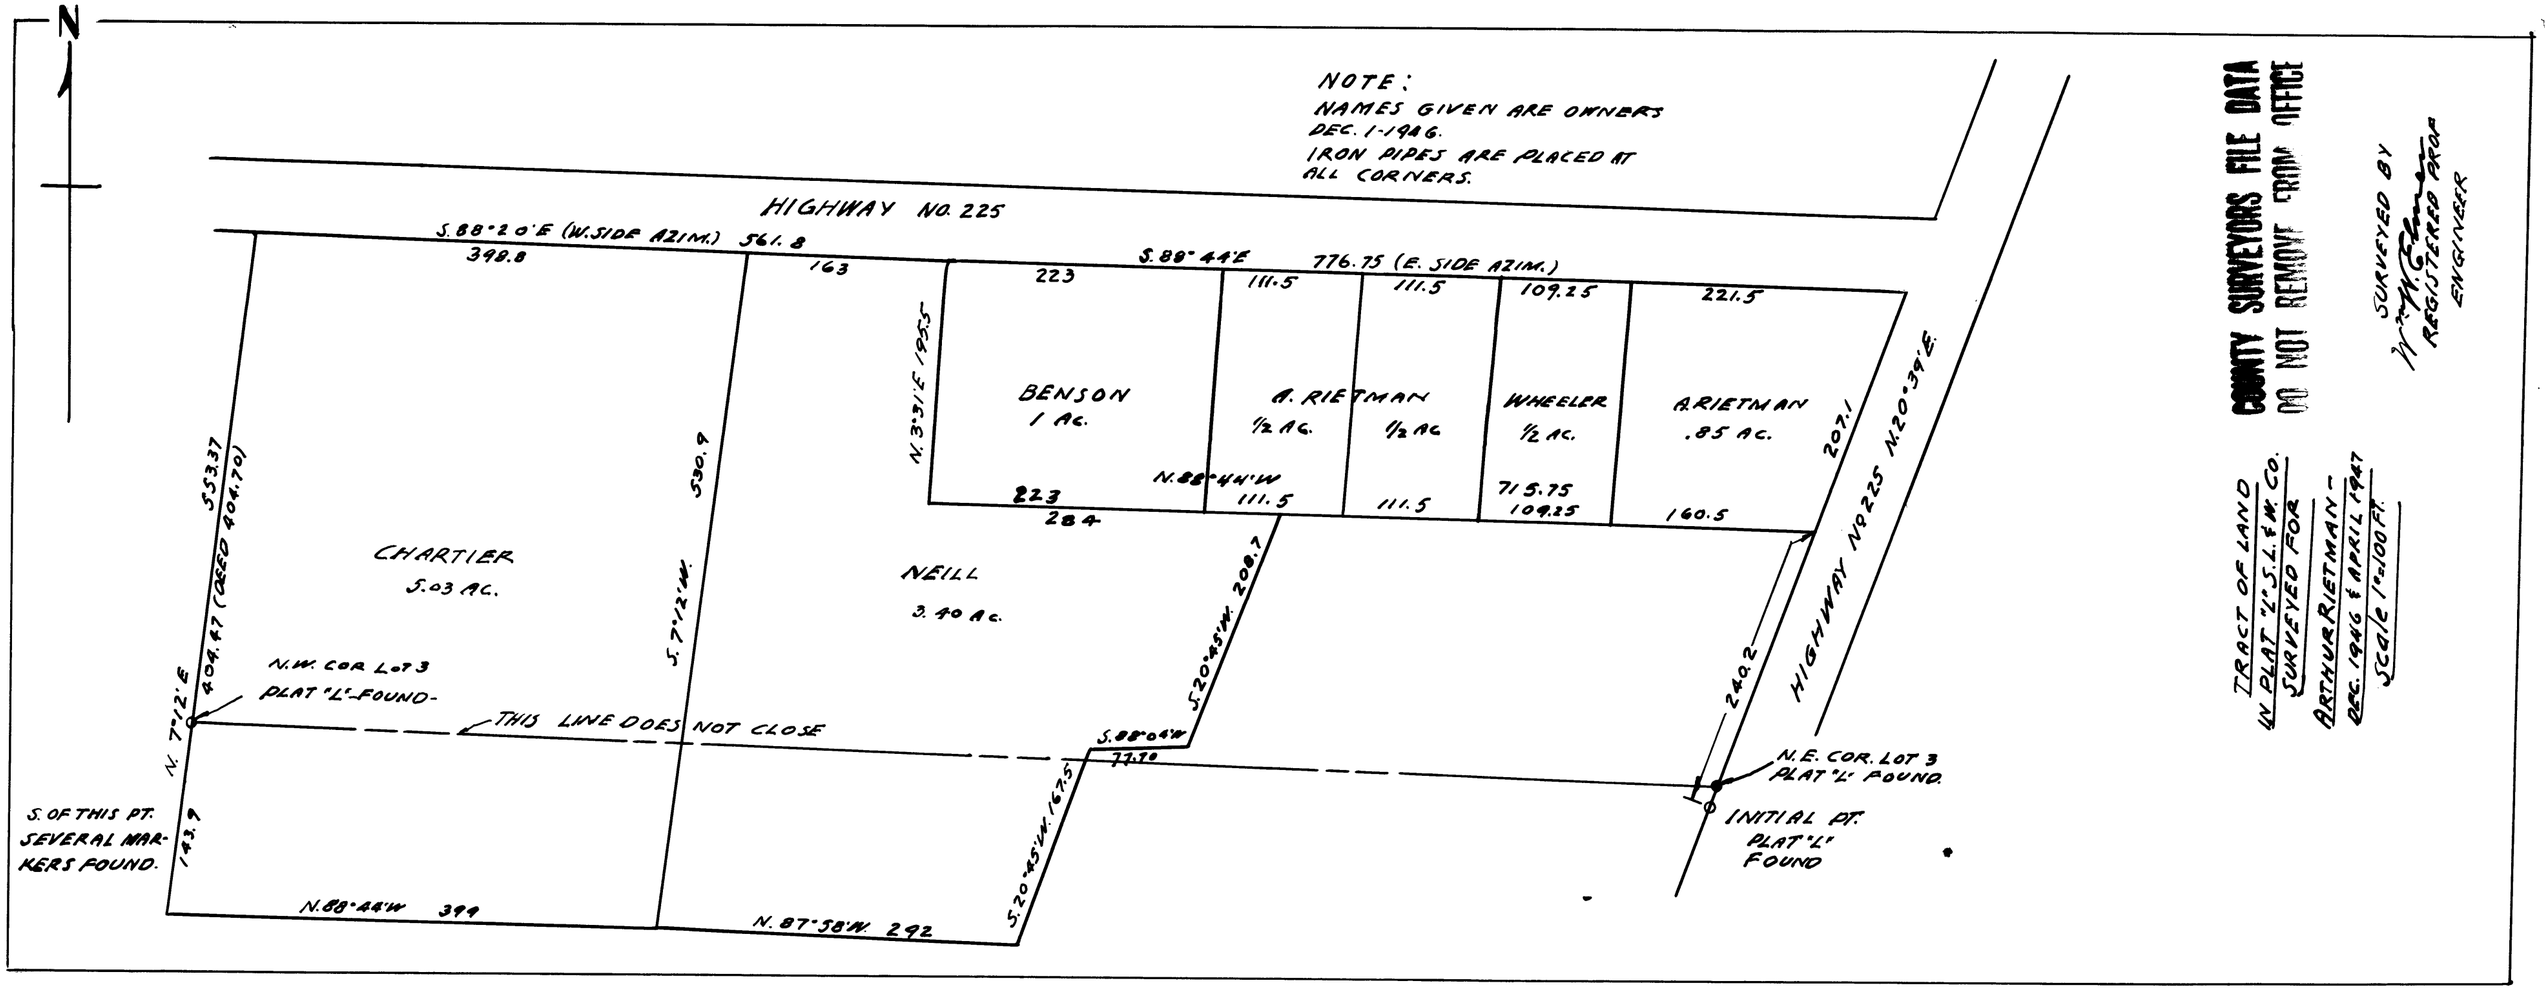

TRACT OF LAND IN PLAT "L" S.L.F.W. CO.
SURVEYED FOR
ARTHUR RIETMAN -
DEC. 1946 & APRIL 1947
SCALE 1"=100 FT.

COUNTY SURVEYORS FILE DATA
DO NOT REMOVE FROM OFFICE

SURVEYED BY
W. G. [illegible]
REGISTERED PROF. ENGINEER