40/164

PREPARED FOR

E.C. KNEBEL & G.D. BONNEY
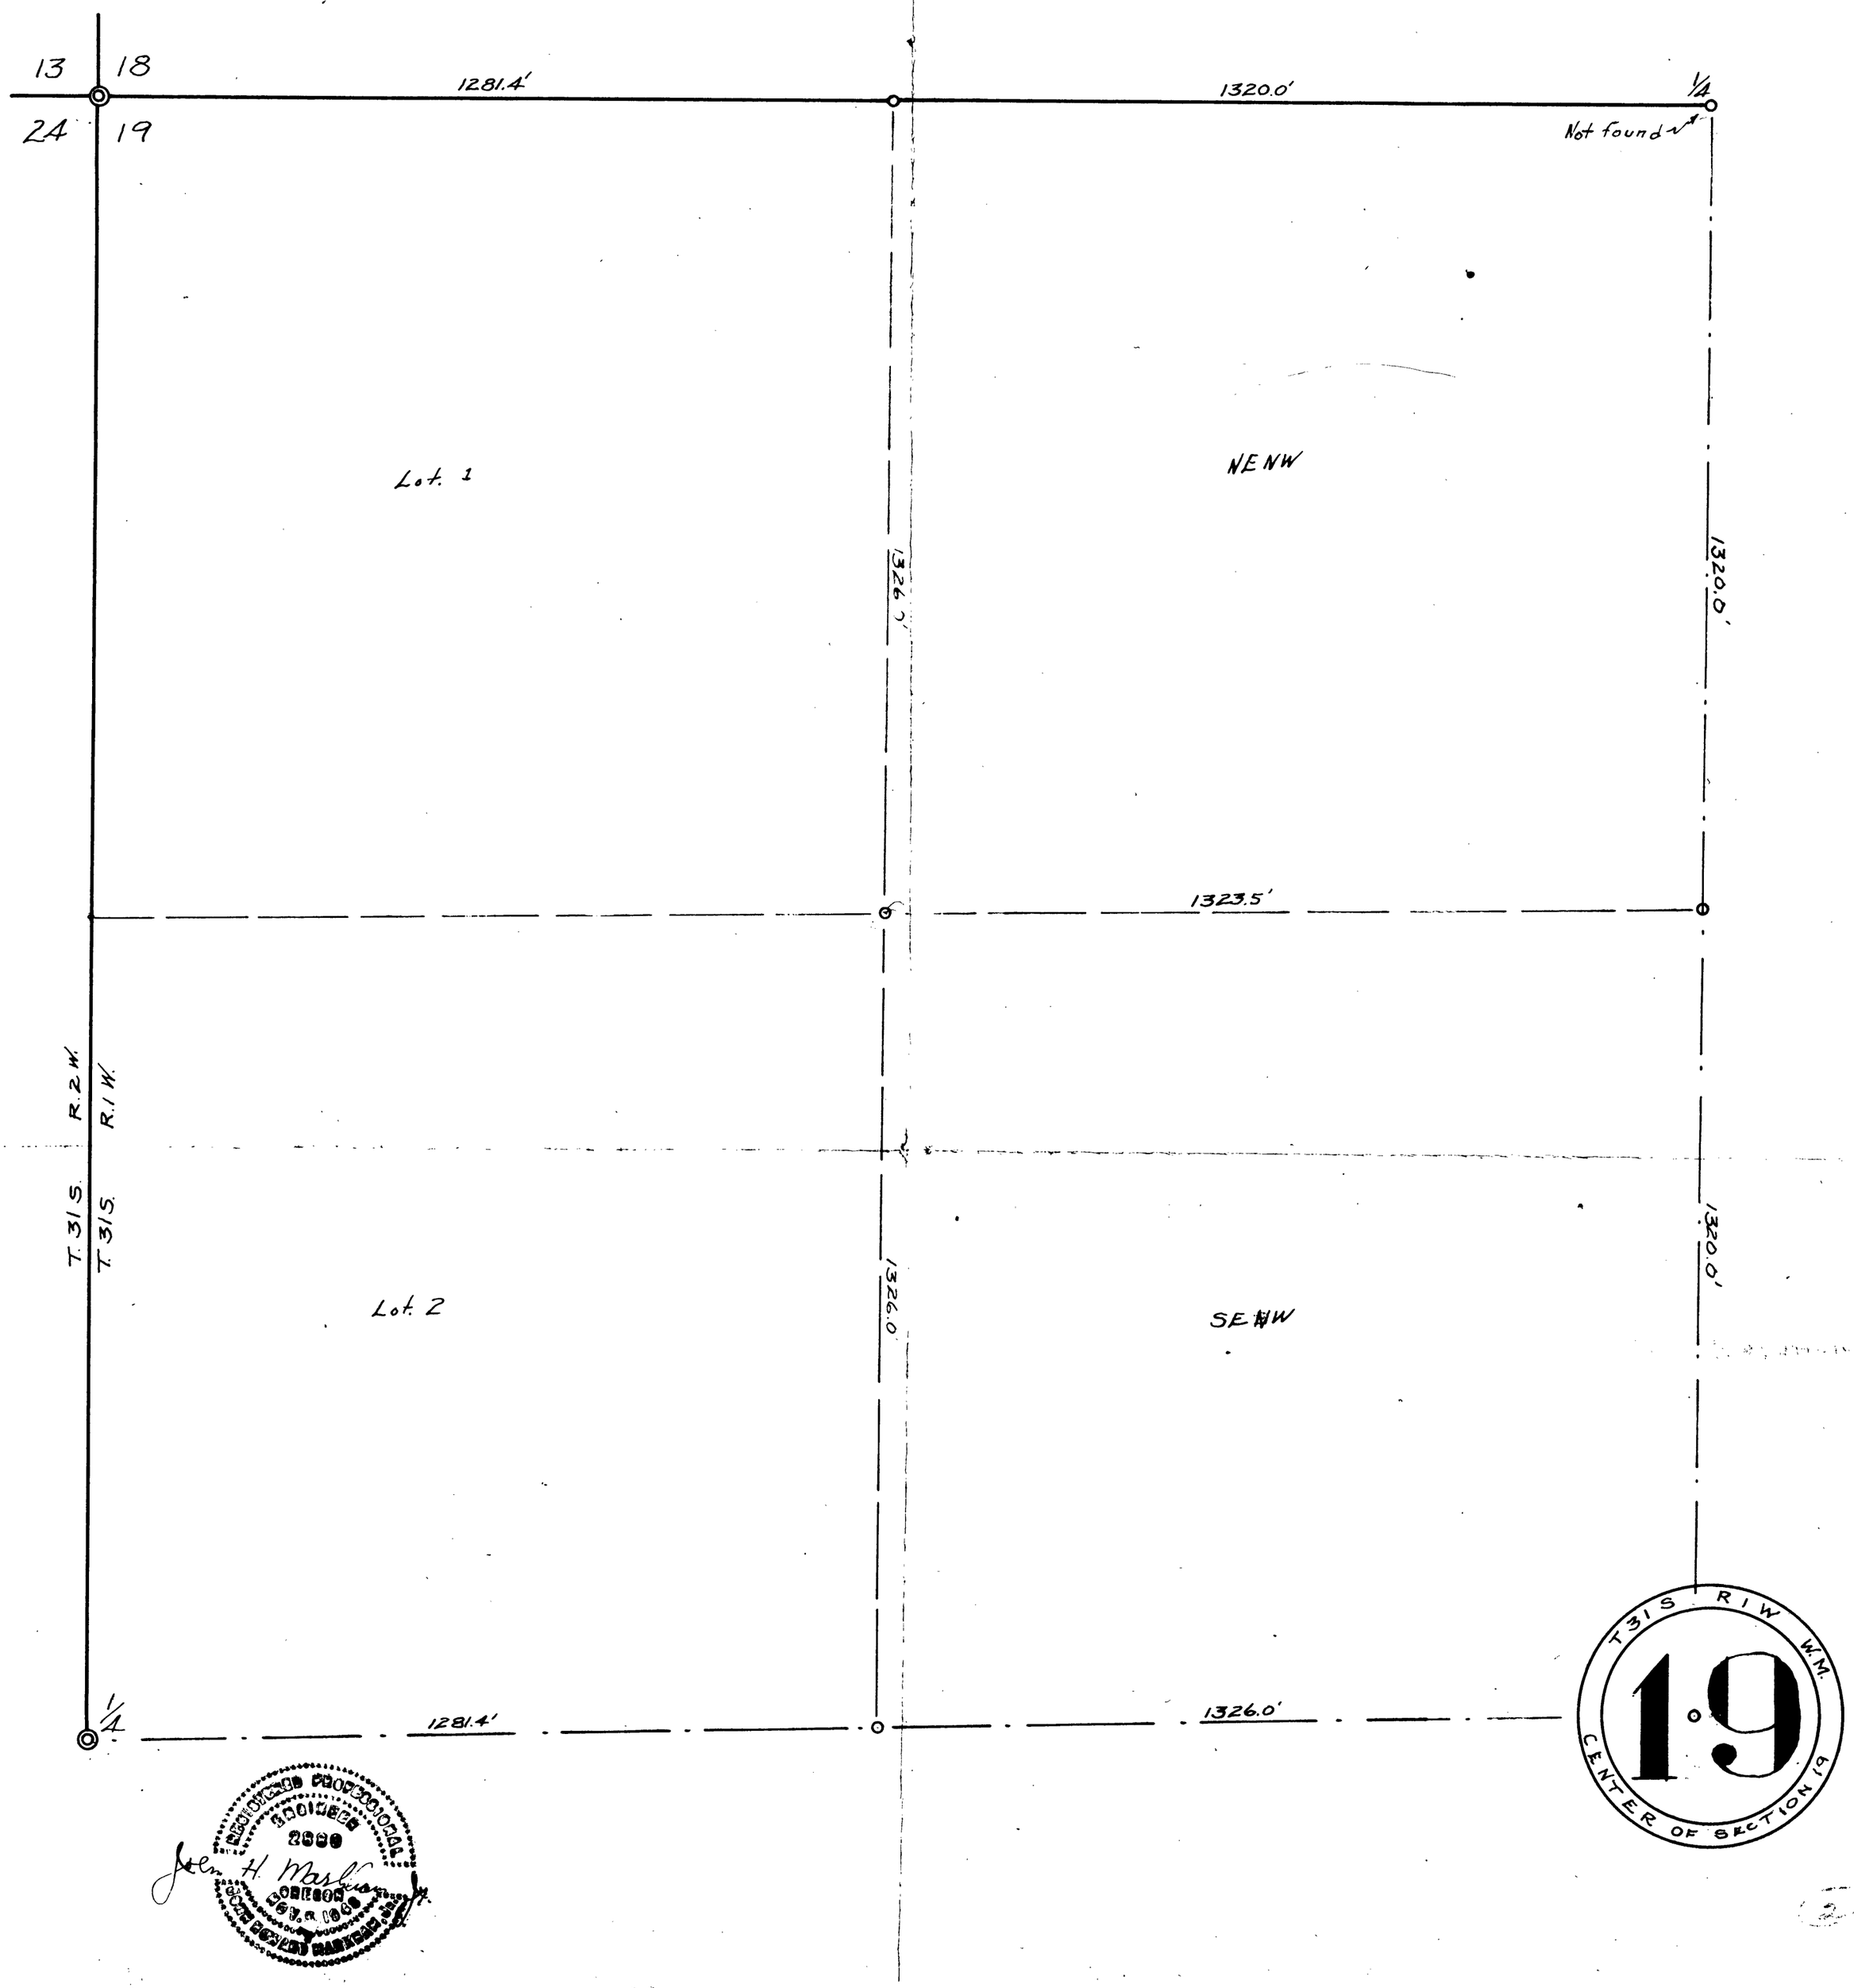
BY JOHN H. MARKHAM, JR. SCALE 1" = 200'