SURVEY FOR M.L. BOWSER
SECTION 14 T.22S.R.6 W
DRAIN, ORE. SURVEY BY
JAN. 1949 FRED L. DOW
SCALE 1"=300'

COUNTY SURVEYORS FILE DATA
DO NOT REMOVE FROM OFFICE

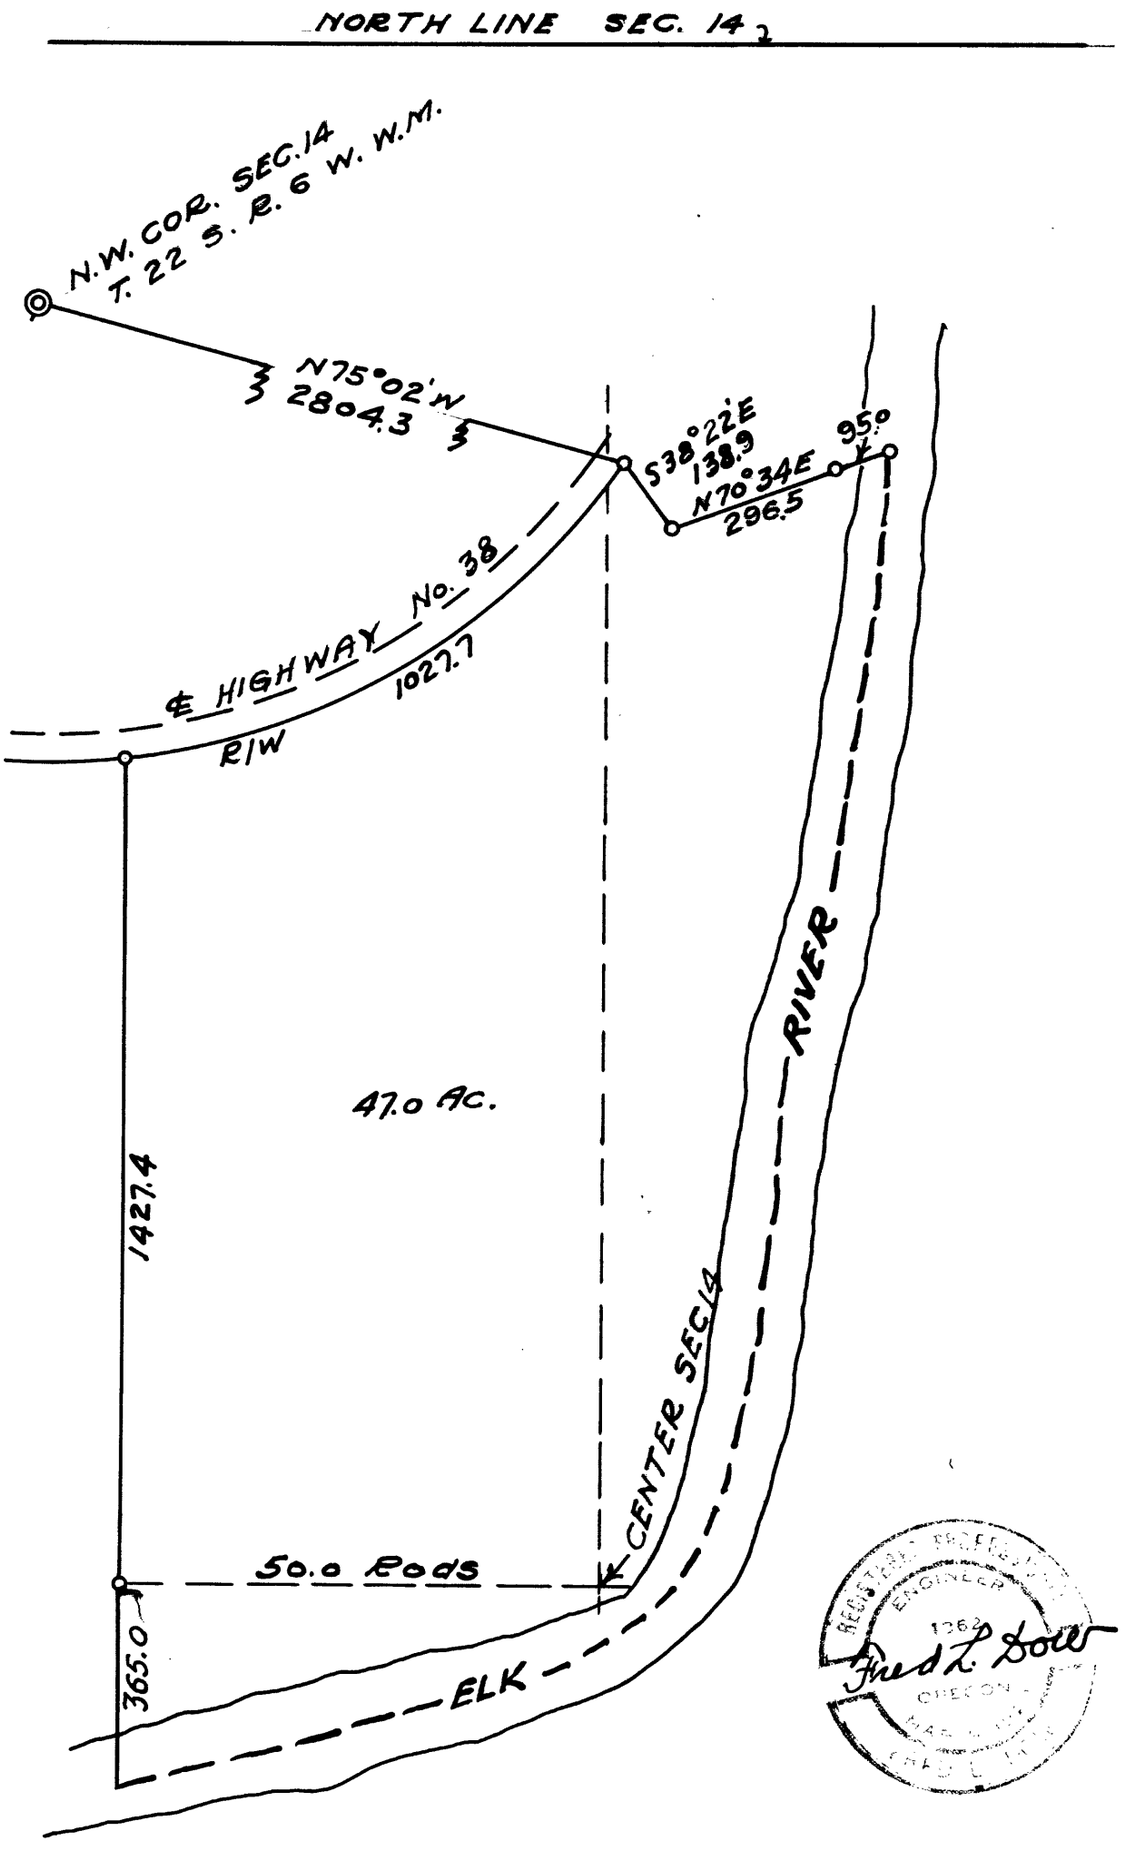

Mrs. Ella May Bowser.
Drain.
1953

Beginning at an iron pipe on the Southeasterly Right of Way line of the Oregon State Highway from which the ¼ corner on the North line of Section 14, Township 22 South, Range 6 West, W.M. in Douglas County, Oregon bears North 66°30' West 516.0 feet and running thence South 10°50' West 73.7 feet to an iron pipe. Thence continuing South 10°50' West 70.0 feet to a point in the center of Elk Creek. Thence downstream along the center of Elk Creek, South 18°58' West 127.18 feet to a point. Thence leaving Elk Creek and running North 76°13' West 100.0 feet to an iron pipe. Thence continuing North 76°13' West 96.0 feet to an iron pipe on the said Southeasterly Right of Way line of the Oregon State Highway. Thence in a Northeasterly direction along the said Southeasterly Right of way line and on a curve to the right, 337.16 feet of which the long chord of said curve bears North 50°19' East 336.17 feet to the place of beginning, containing 0.64 acres.

40/200-1

CS FILE FOLDER

CONTAINS

MORE

INFORMATION