COUNTY SURVEYORS FILE DATA
DO NOT REMOVE FROM OFFICE

PROPERTY SURVEY
SECTION 9, T.25S.R.4W.
SCALE 1"=100'
APR. 1949

FRED L. DOW
SURVEYOR

REGISTERED PROFESSIONAL ENGINEER 1362 Fred L. Dow OREGON MAR. 9 1928 FRED L. DOW

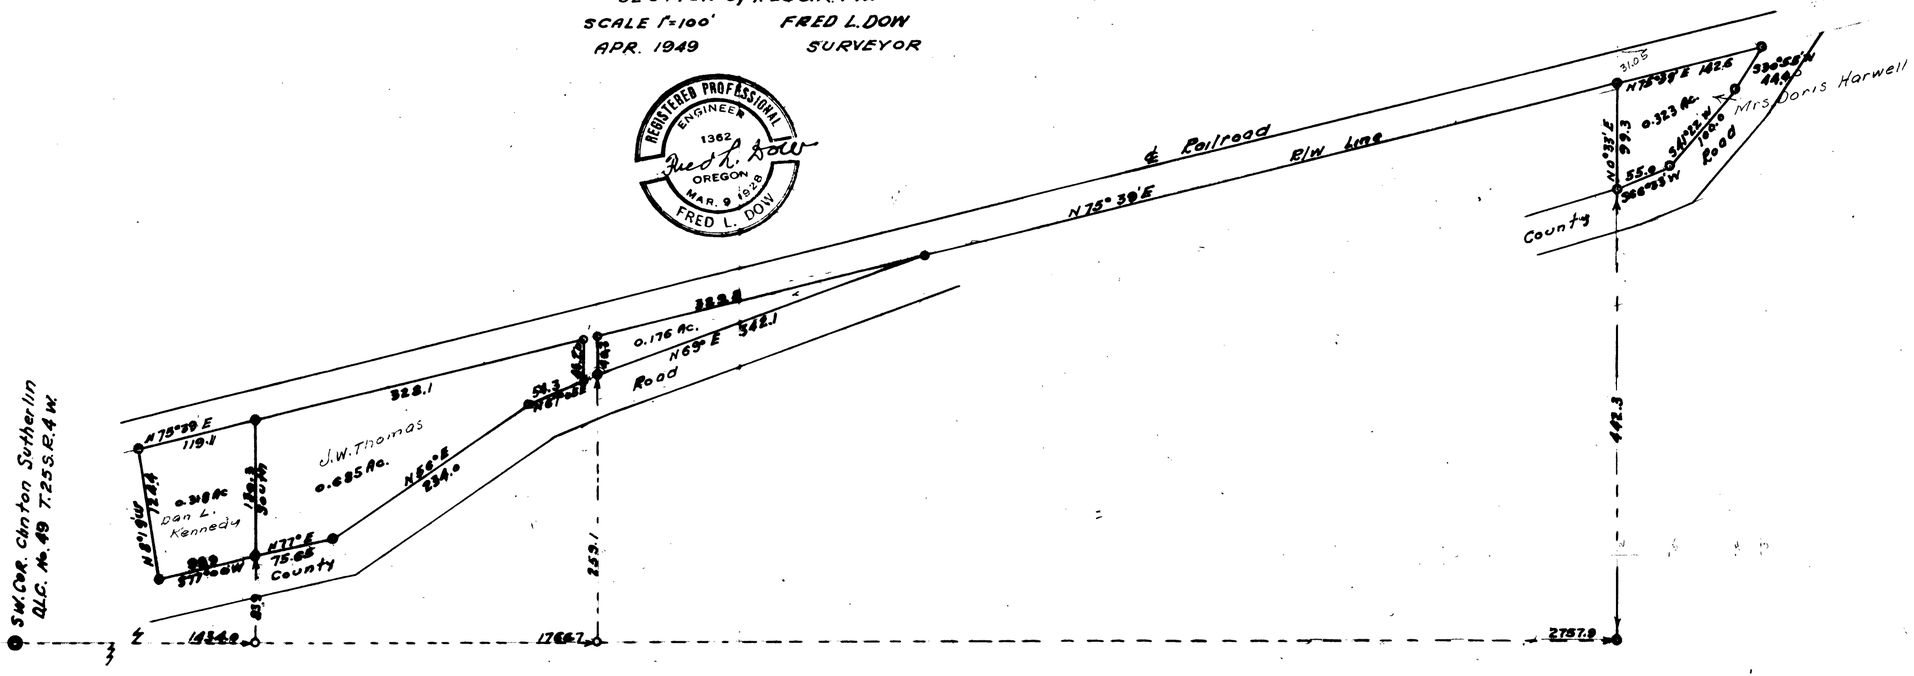

2