FILE 259 DRAWER 40

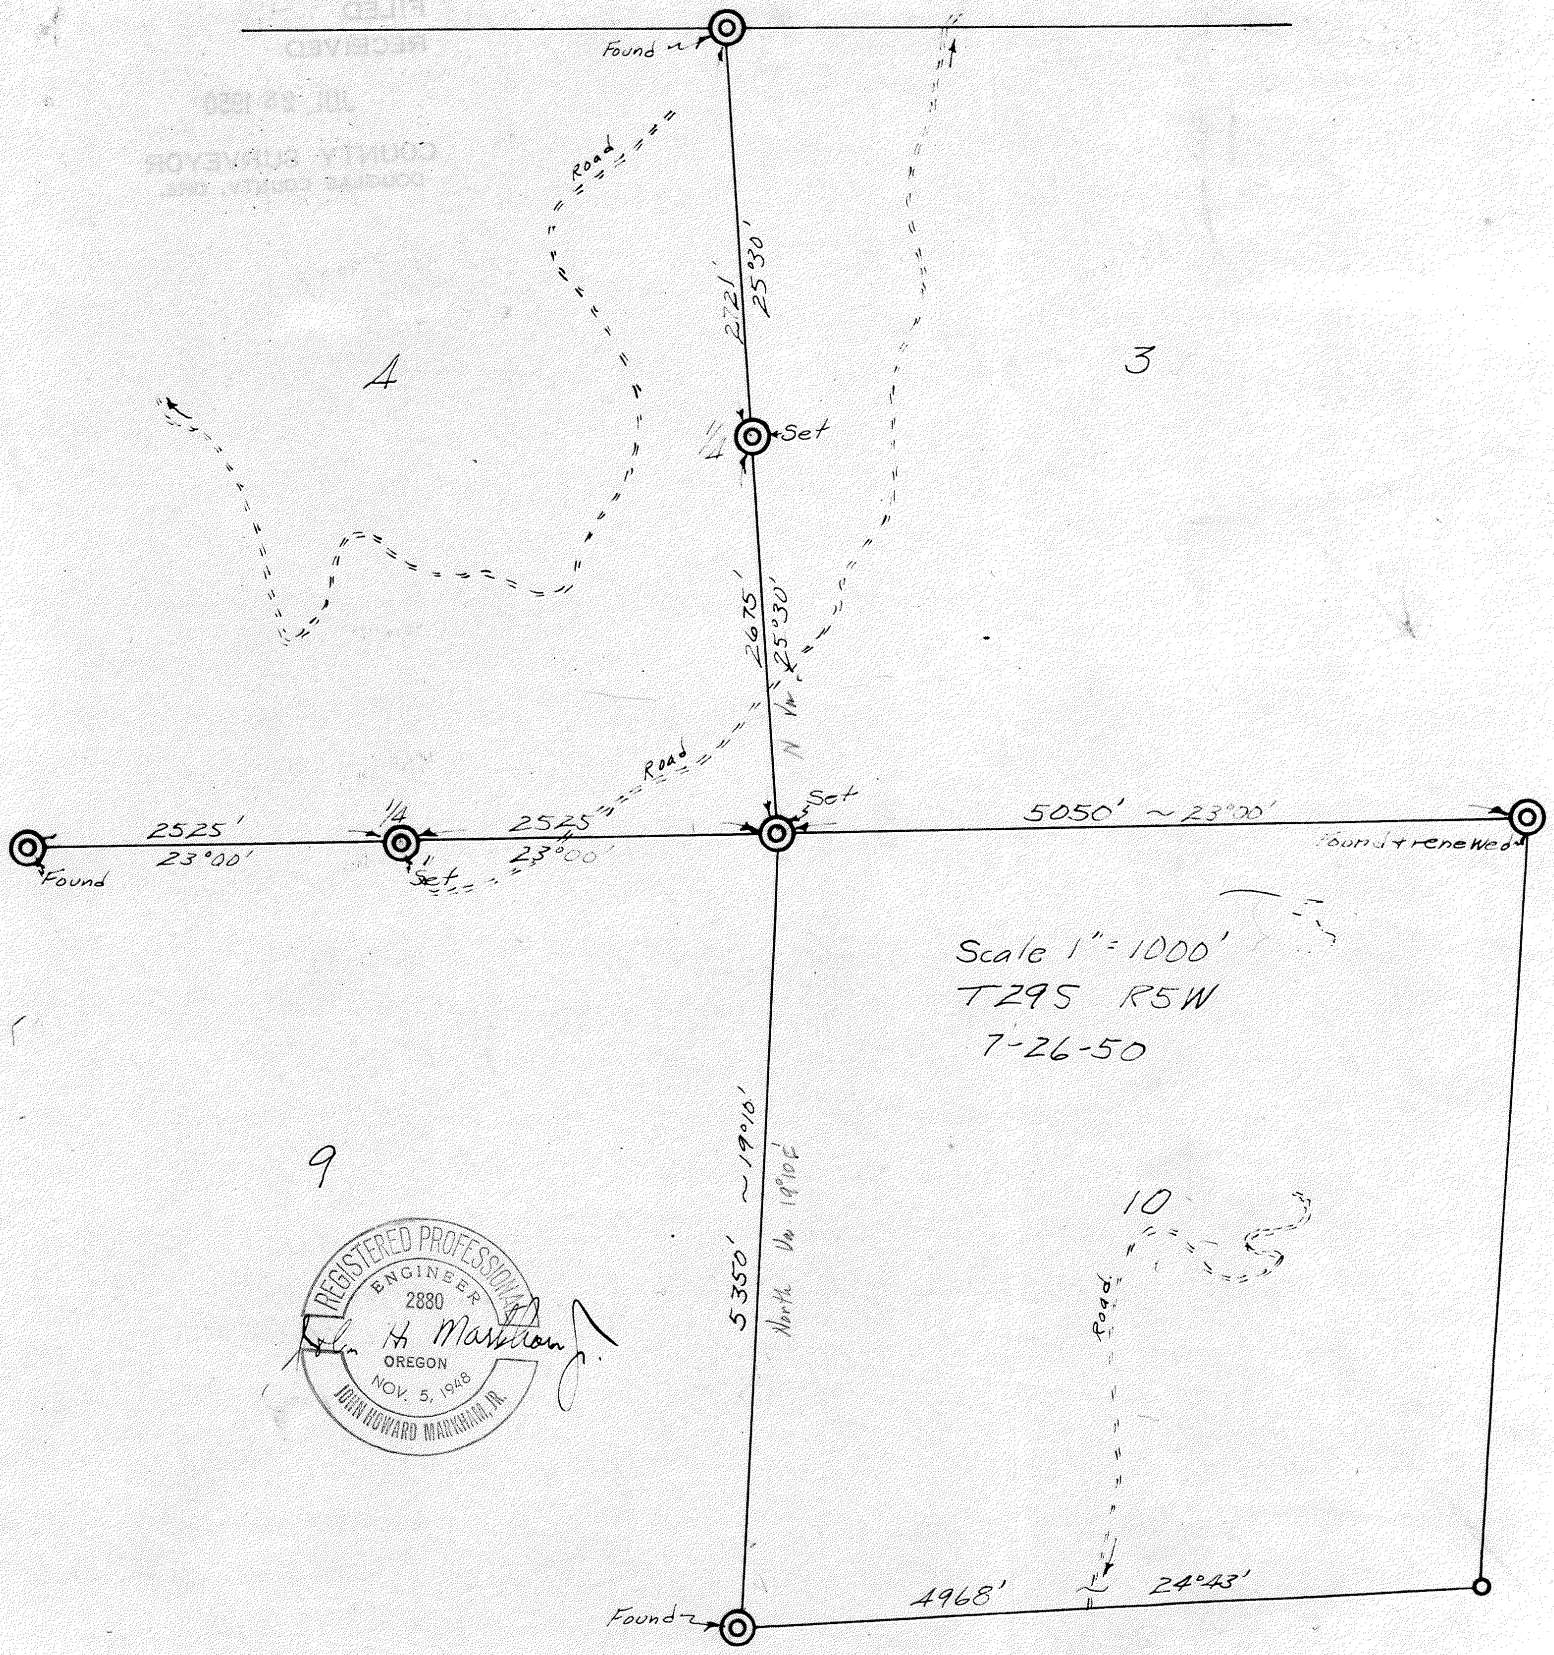

REGISTERED PROFESSIONAL ENGINEER 2880 OREGON NOV. 5, 1948 JOHN HOWARD MARKHAM, JR.

CS 40/259 -4

FOR ORIGINAL SEE CS 51/130