

REVISED

SURVEY

OF A PARCEL OF GROUND( DESIGNATED AS "A") IN SEC.  
30, T.32 S., R.5 W., DOUGLAS COUNTY, OREGON.

FILED 3-1-54  
Rec'd 3-1-54  
County Surveyor  
Douglas County, Ore.

**COUNTY SURVEYORS FILE DATA  
DO NOT REMOVE FROM OFFICE**

CS 40/297-4

REVISED

NARRATIVE OF SURVEY

OF A PARCEL OF GROUND (designated as "A") in SEC.  
30, T.32 S., R.5 W., DOUGLAS COUNTY, OREGON.

This survey was made for Mr. Pirley Winkelman on Nov. 25, 1950, for the purpose of transferring title. Used a transit, long band chain, and range pole, Mr. Winkelman and two others helping with the survey. Bearing of the lines were taken from an observation on Polaris made on Sept. 5, 1950, at E. elongation.

DESCRIPTION

Beginning at a point 1307.2 feet east and 1327.5 feet south of the  $\frac{1}{4}$  section corner between sections 19 and 30 of T.32 S., R.5 W., thence

S. 89°-58' W. for 379.2 feet, thence

N. 34°-35' W. for 117.6 feet, thence

S. 72°-37' W. for 111.2 feet to a point on the NEly bank of Woodford Creek, thence along the Creek bank

S. 29°-36' E. for 117.0 feet, thence

S. 45°-26' E. for 165.4 feet, thence

S. 69°-05' E. for 134.4 feet, thence

S. 52°-32' E. for 75.9 feet, thence leaving the Creek bank

N. 0°-08' E. for 148.6 feet, thence

N. 89°-58' E. for 190.0 feet to a point near Barton Road, thence along side of the road

N. 0°-08' E. for 100.0 feet to the point of beginning.


Area enclosed is 1.776 acres, all in the west half of the northeast quarter of section 30 township 32 south range 5 west of the Willamette Meridian, Douglas County, Oregon.

Corner Stakes

All corner stakes are  $\frac{1}{2}$  inch iron pipes 30 inches long, driven 24 inches into the ground except the point of beginning which is a drill steel designated by D.S. on the sketch.

See accompanying sketch for further information.

October 12, 1953.

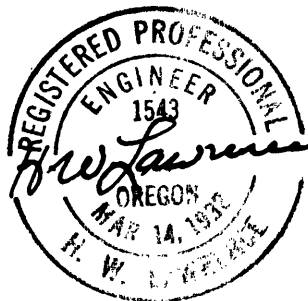

U. S. File No. 40/297

**SKETCH of SURVEY**  
 of 2 PARCELS of GROUND ("A" & "B") in  
 W 1/2 of the NE 1/4, SEC. 30, T. 32 S., R. 5 W. W.M.  
 for  
**MR. PIRLEY WINKELMAN**



Scale: 1 in. = 100 ft.

Date: Dec. 7, 1950

Surveyed and Sketched by *A.W. Lawrence*

Revised: Oct. 12, 1953.

