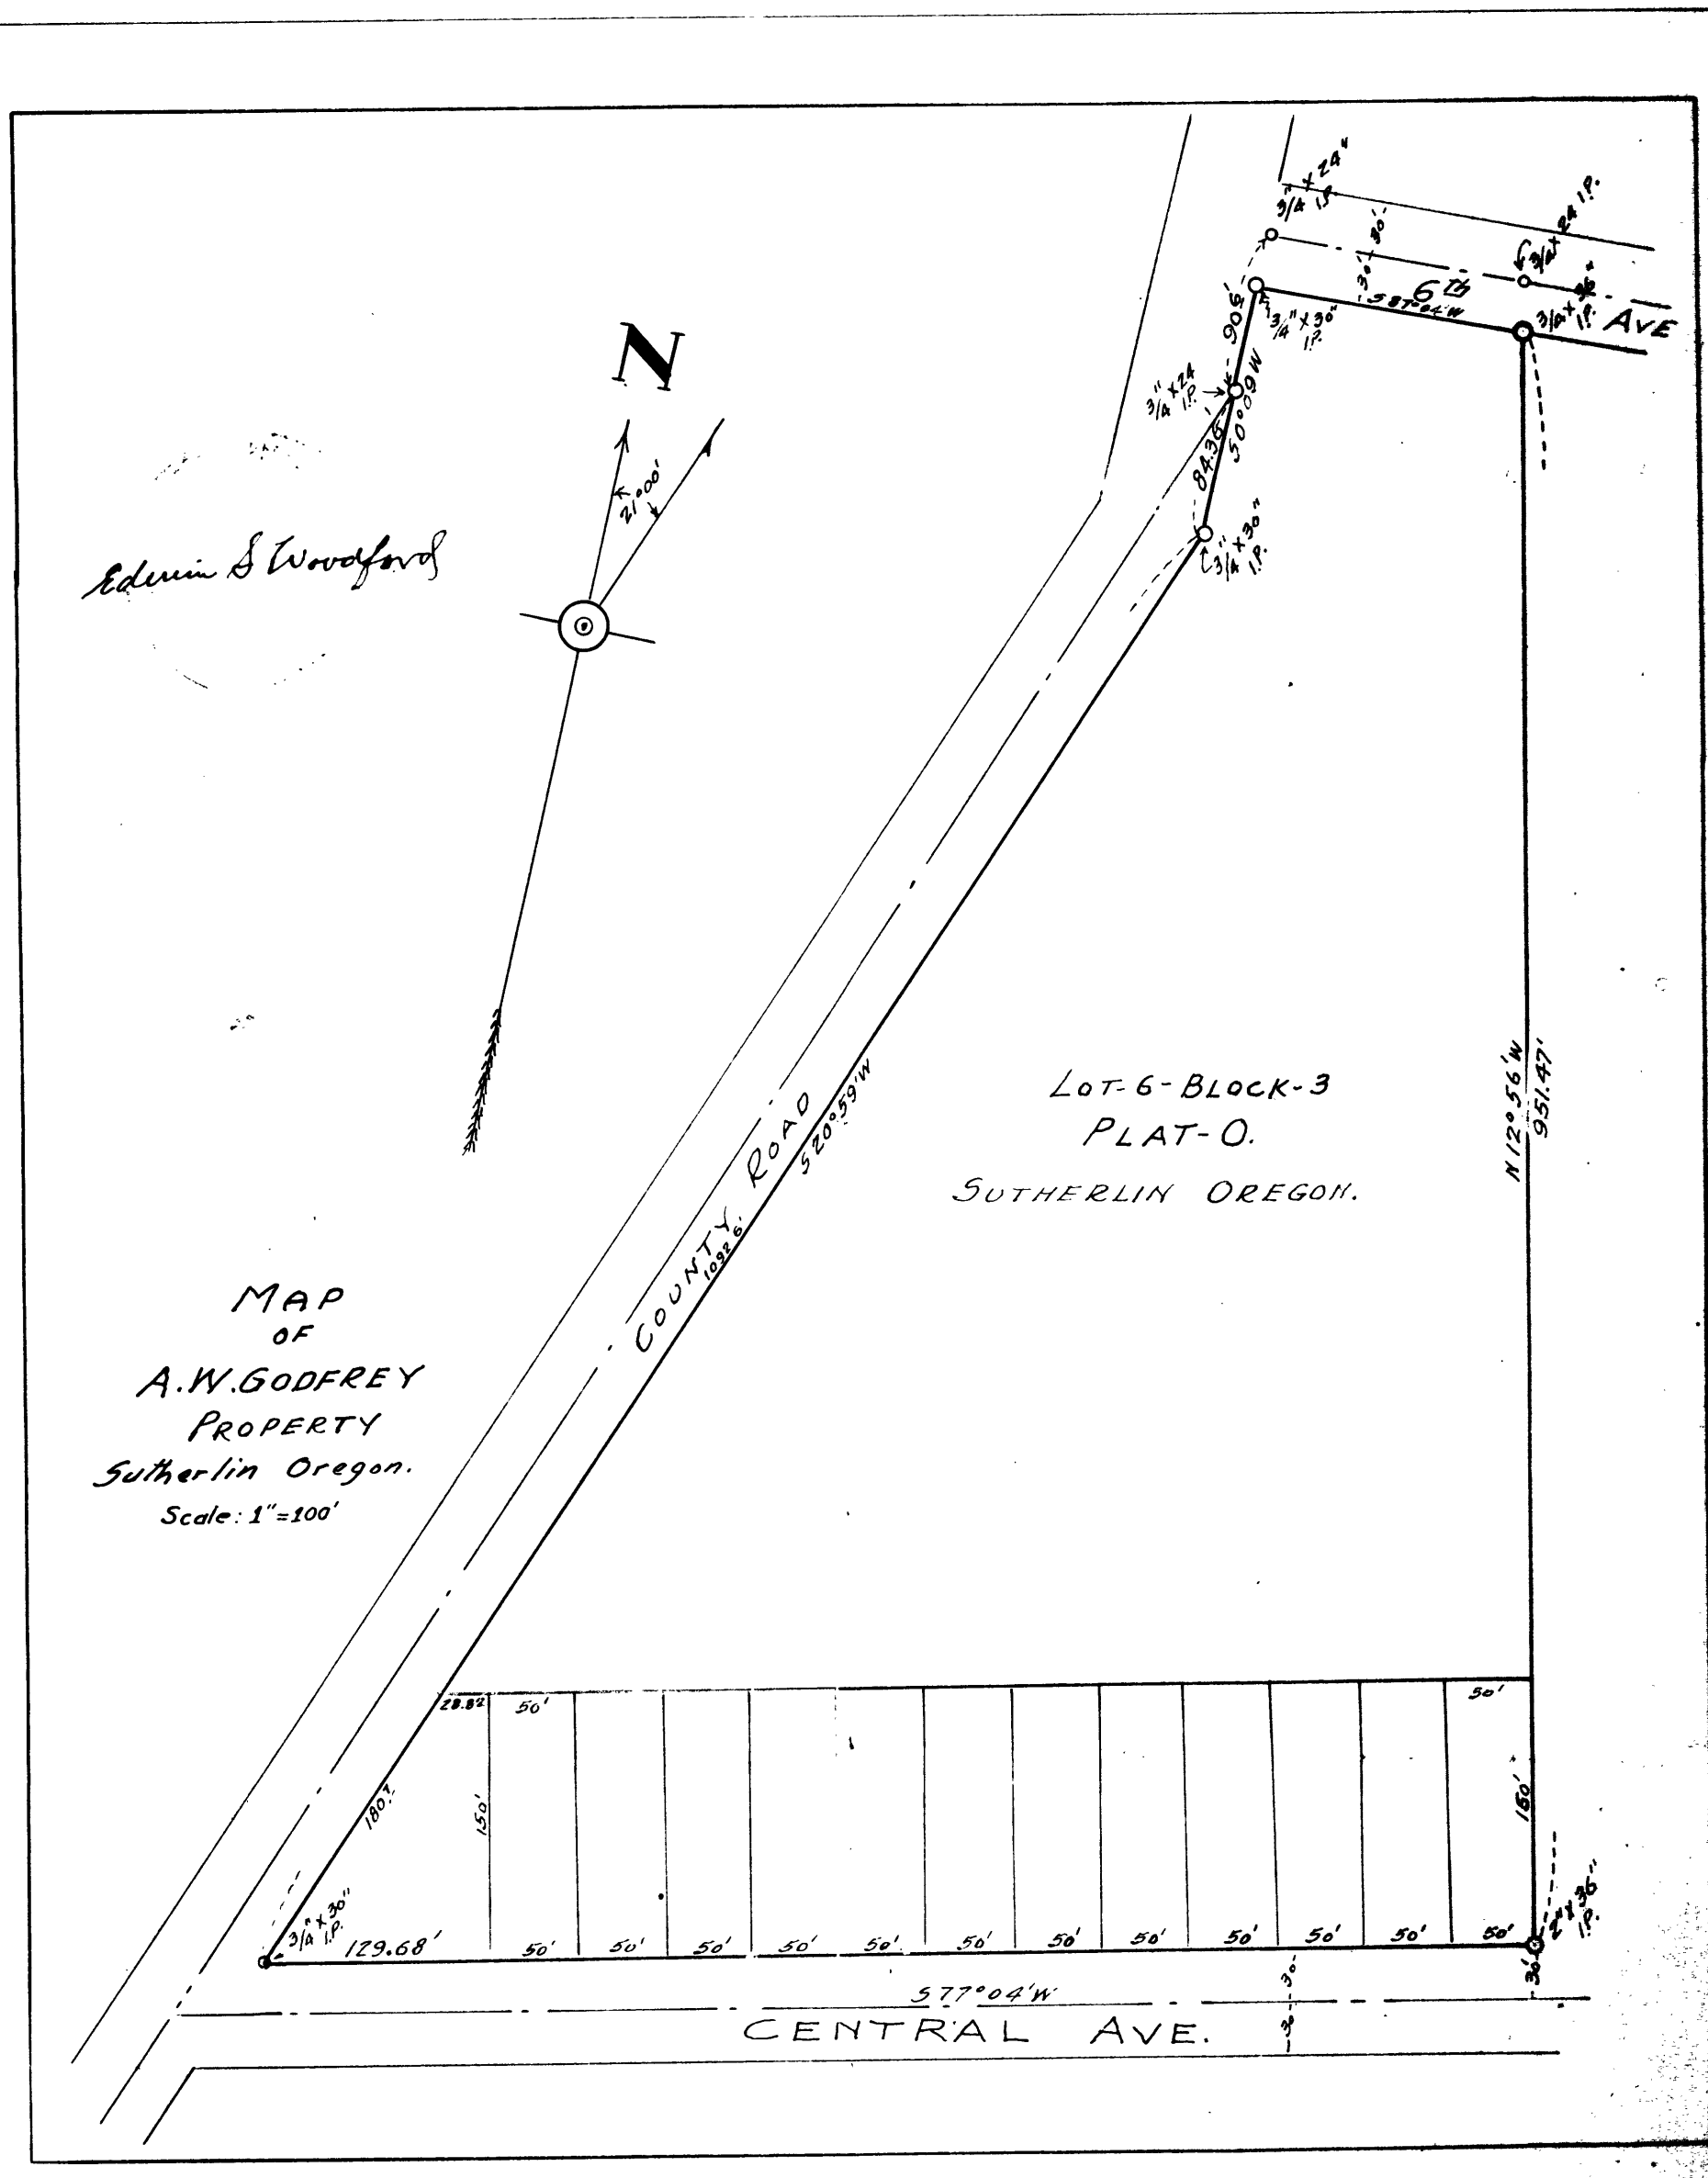
N
21°00'
Edwin S Woodford
MAP
OF
A.W.GODFREY
PROPERTY
Sutherlin Oregon.
Scale: 1"=100'
COUNTY ROAD
S20°59'W
1092.6'
LOT-6-BLOCK-3
PLAT-O.
SUTHERLIN OREGON.
N12°56'W
951.47'
6TH
S87°04'W
AVE
3/4"x24" I.P.
3/4"x30" I.P.
90.6'
S0°09'W
84.36'
28.82
50'
150'
180.7'
129.68'
S77°04'W
CENTRAL AVE.