1/29/96
Print from
microfilm -
original
missing
contents

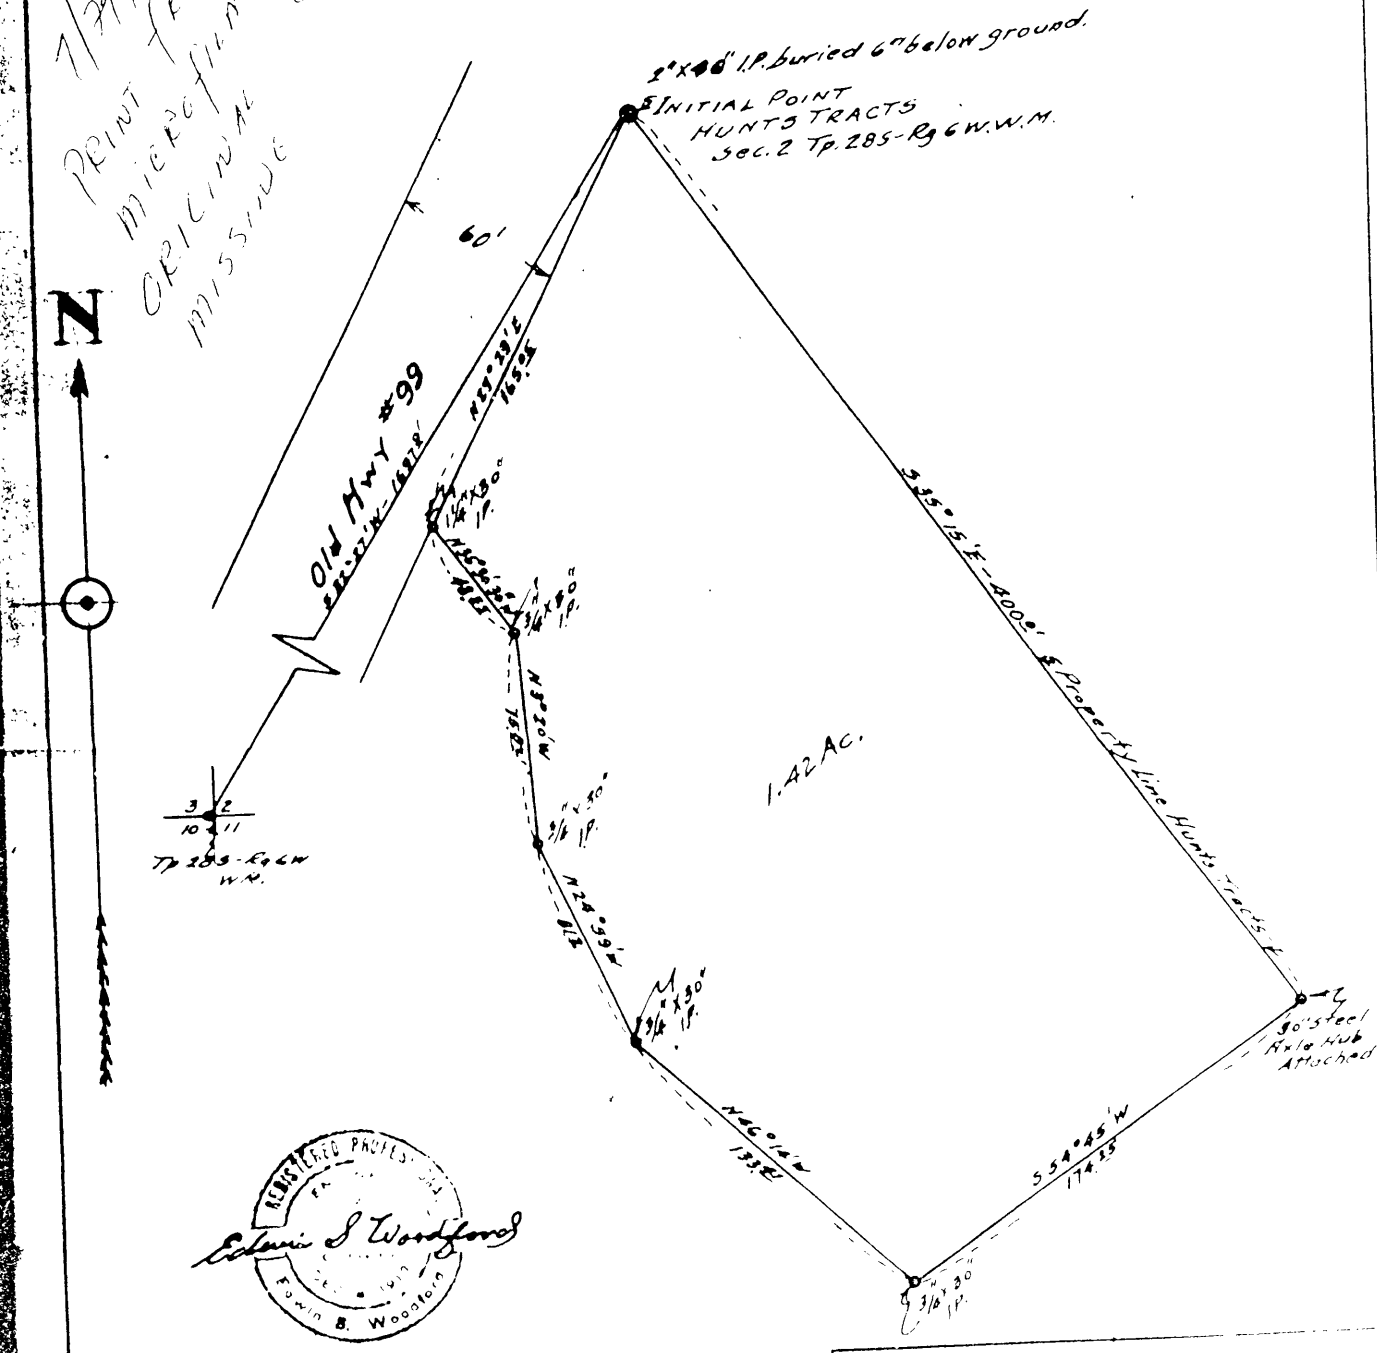

REGISTERED PROFESSIONAL ENGINEER
Edwin B. Woodford

MAP
OF
CHURCH PROPERTY
IN
SEC. 2 Tp. 28S Rg 6W W.M.
Scale 1" = 50'

CS 40/354