

11-2-51

North $\frac{1}{4}$ section Corner Sec. 3,
T 30S, R 4W, W.M.

At the midpoint on
the Twp. Line between the
NW + NE corners of section
3, I drove a $1 \times 30^\circ$ I.P.
from which

A Cedar 9" diam. bears $550^\circ E$,
13.0' dist. mkd. $\frac{1}{4}$ S, S3, B.T.

A Cedar 5" diam. bears $515^\circ E$,
9.0' dist. mkd. $\frac{1}{4}$ S, S3, B.T.


NW cor. sec. 3 bears West $2673'$

NE cor. sec. 3 bears East $2673'$

Sec. Cor. 34-35 bears East, $342.0'$

Witness:

Dennis + Geo. Vaughn.

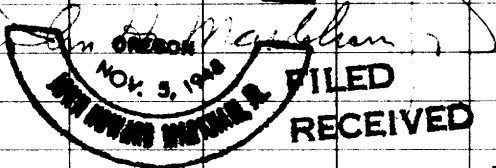

FILED
RECEIVED

NOV 5 1951

Work done for COUNTY SURVEYOR
DOUGLAS COUNTY, OREGON

C. & F. No. 40/386 - 1