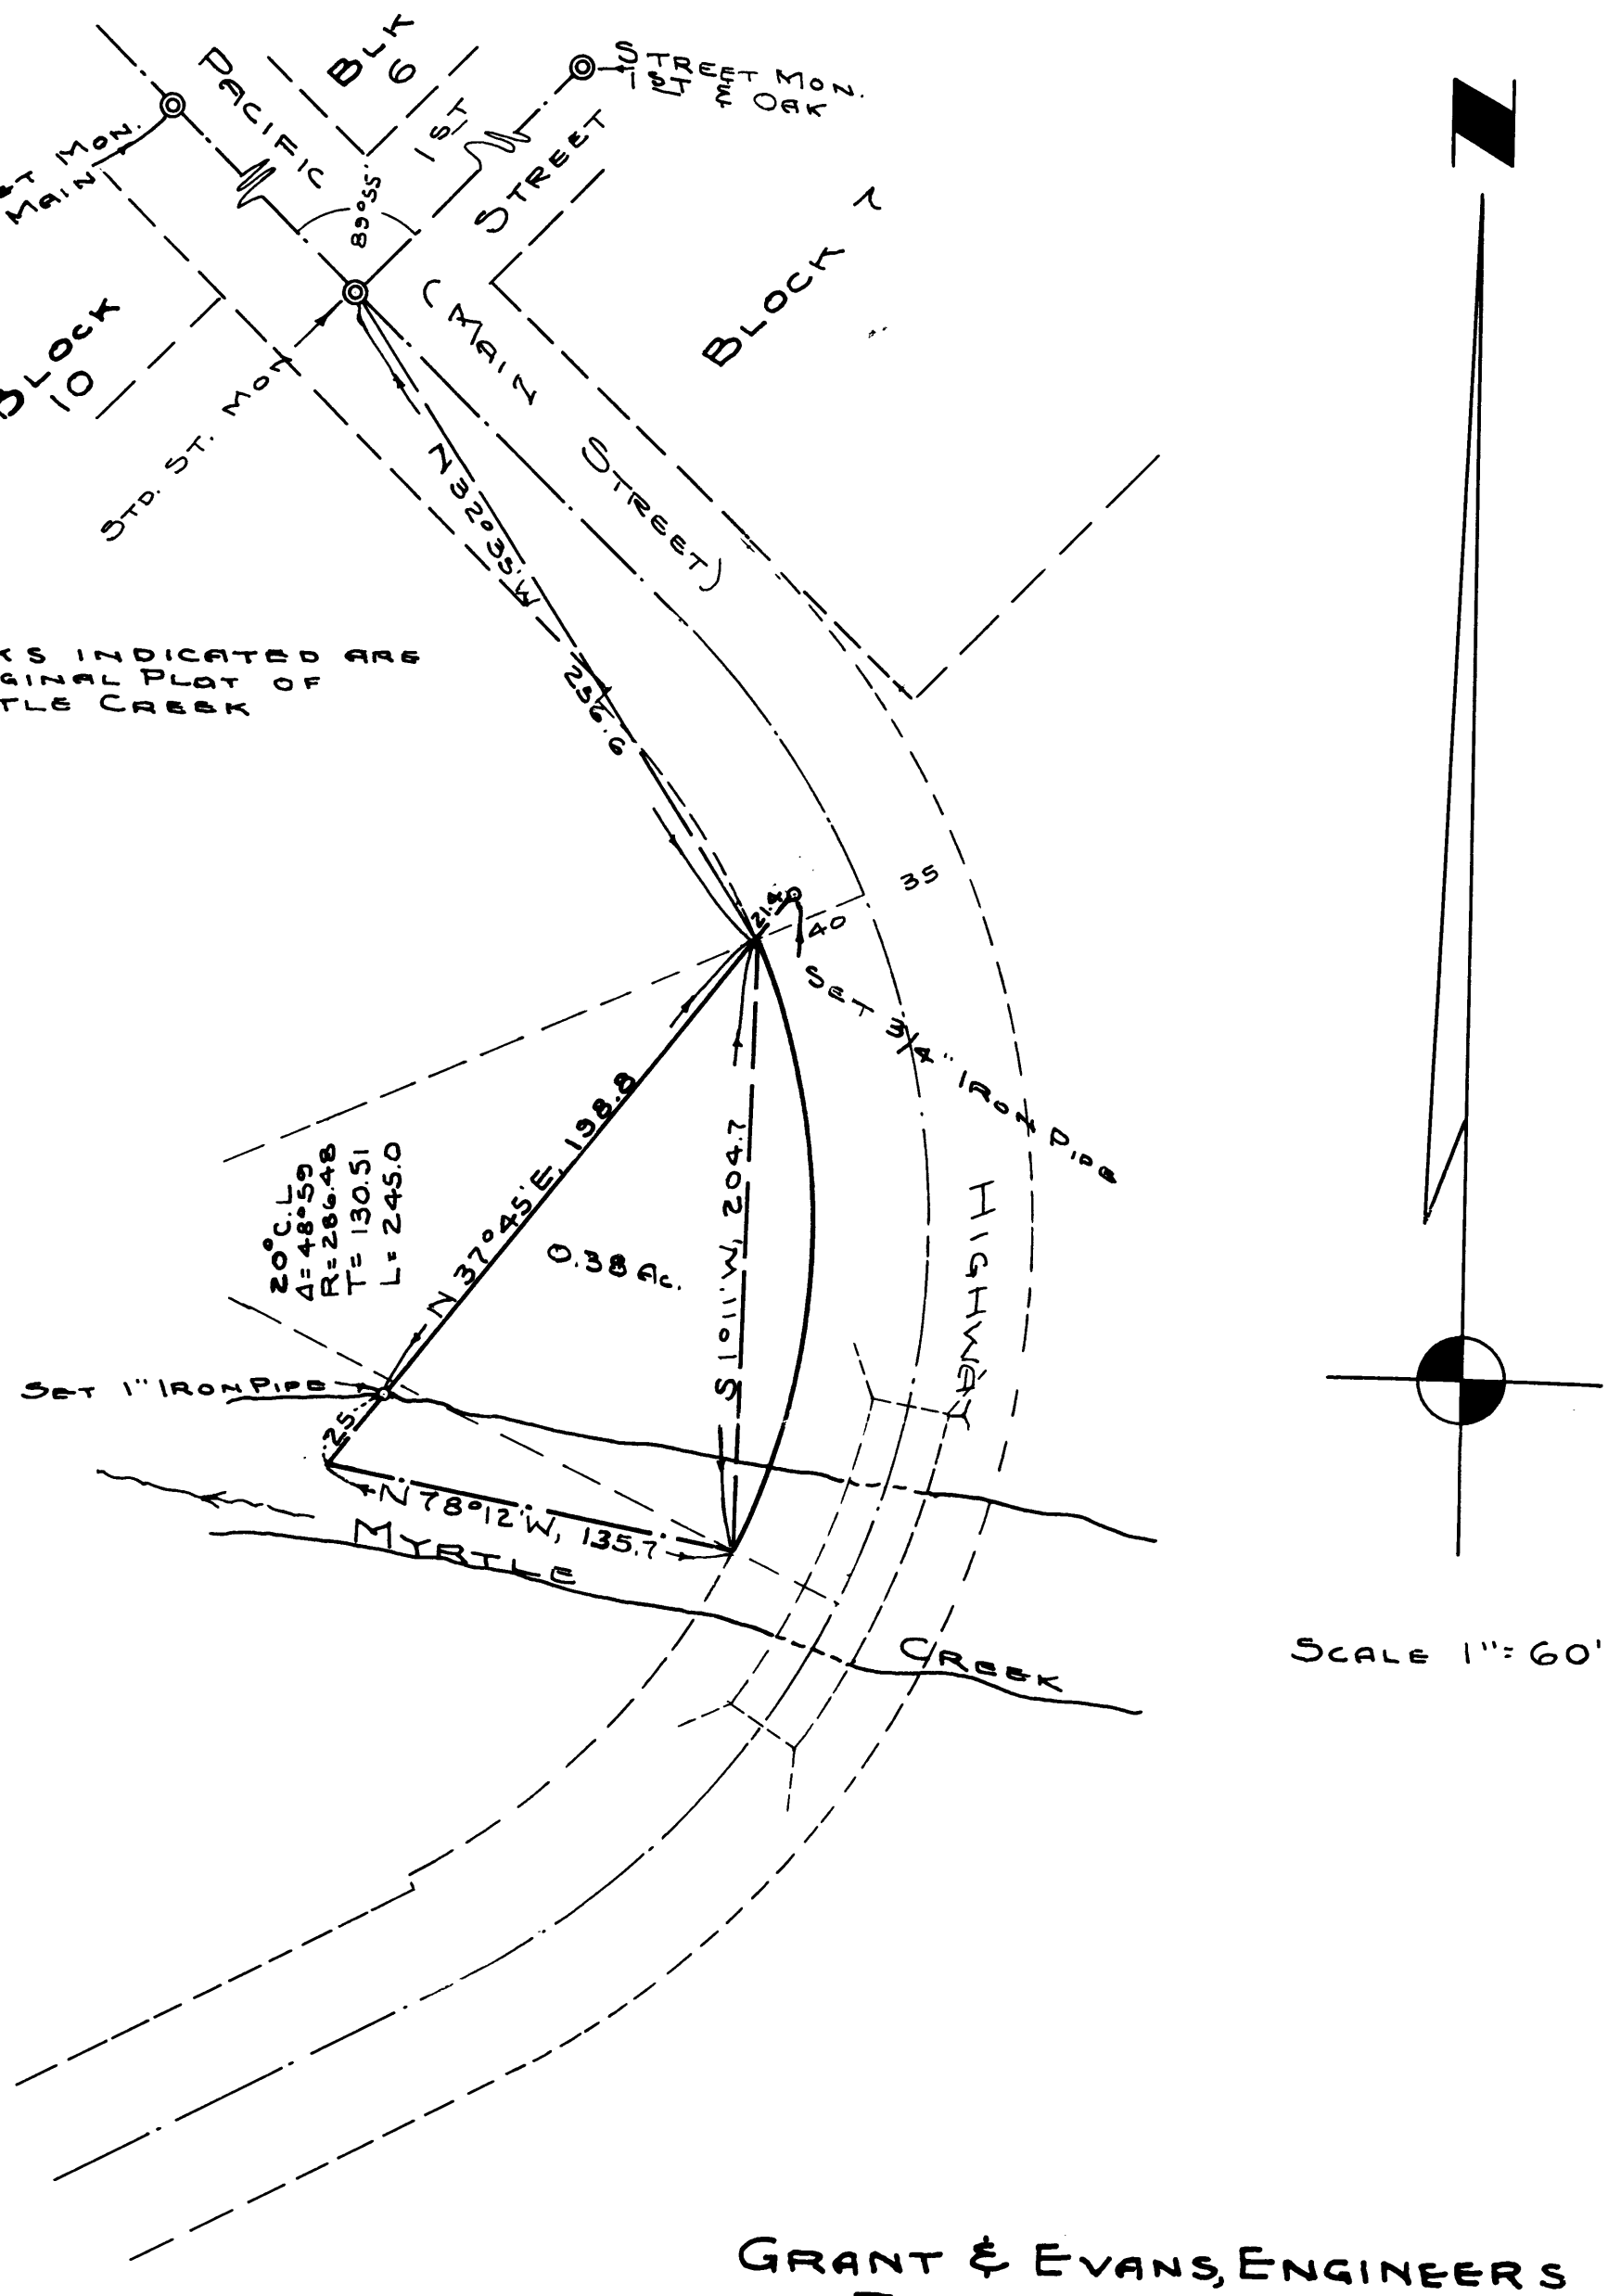

BLOCKS INDICATED ARE IN ORIGINAL PLAT OF MYRTLE CREEK

GRANT & EVANS, ENGINEERS
ROSEBURG, OREGON
SURVEY FOR DEED DESCRIPTION
IN THE CITY OF MYRTLE CREEK, ORE.

REGISTERED PROFESSIONAL ENGINEER 2741 OREGON NOV. 7, 1947 ARTHUR R. EVANS

SURVEYED & PLATTED, SEPT. 1951, BY
A.R. EVANS, REG. PROF. ENGINEER.

COUNTY SURVEYORS FILE DATA
DO NOT REMOVE FROM OFFICE

C.S. 40/391