MAP
OF
PORTION OF HELGESEN RANCH

SEC. 12 Tp 29S-Rg6W WM.
Scale-1" = 100' June 1952.

SEC 7 T29S R5W (DCSO)

[redacted]

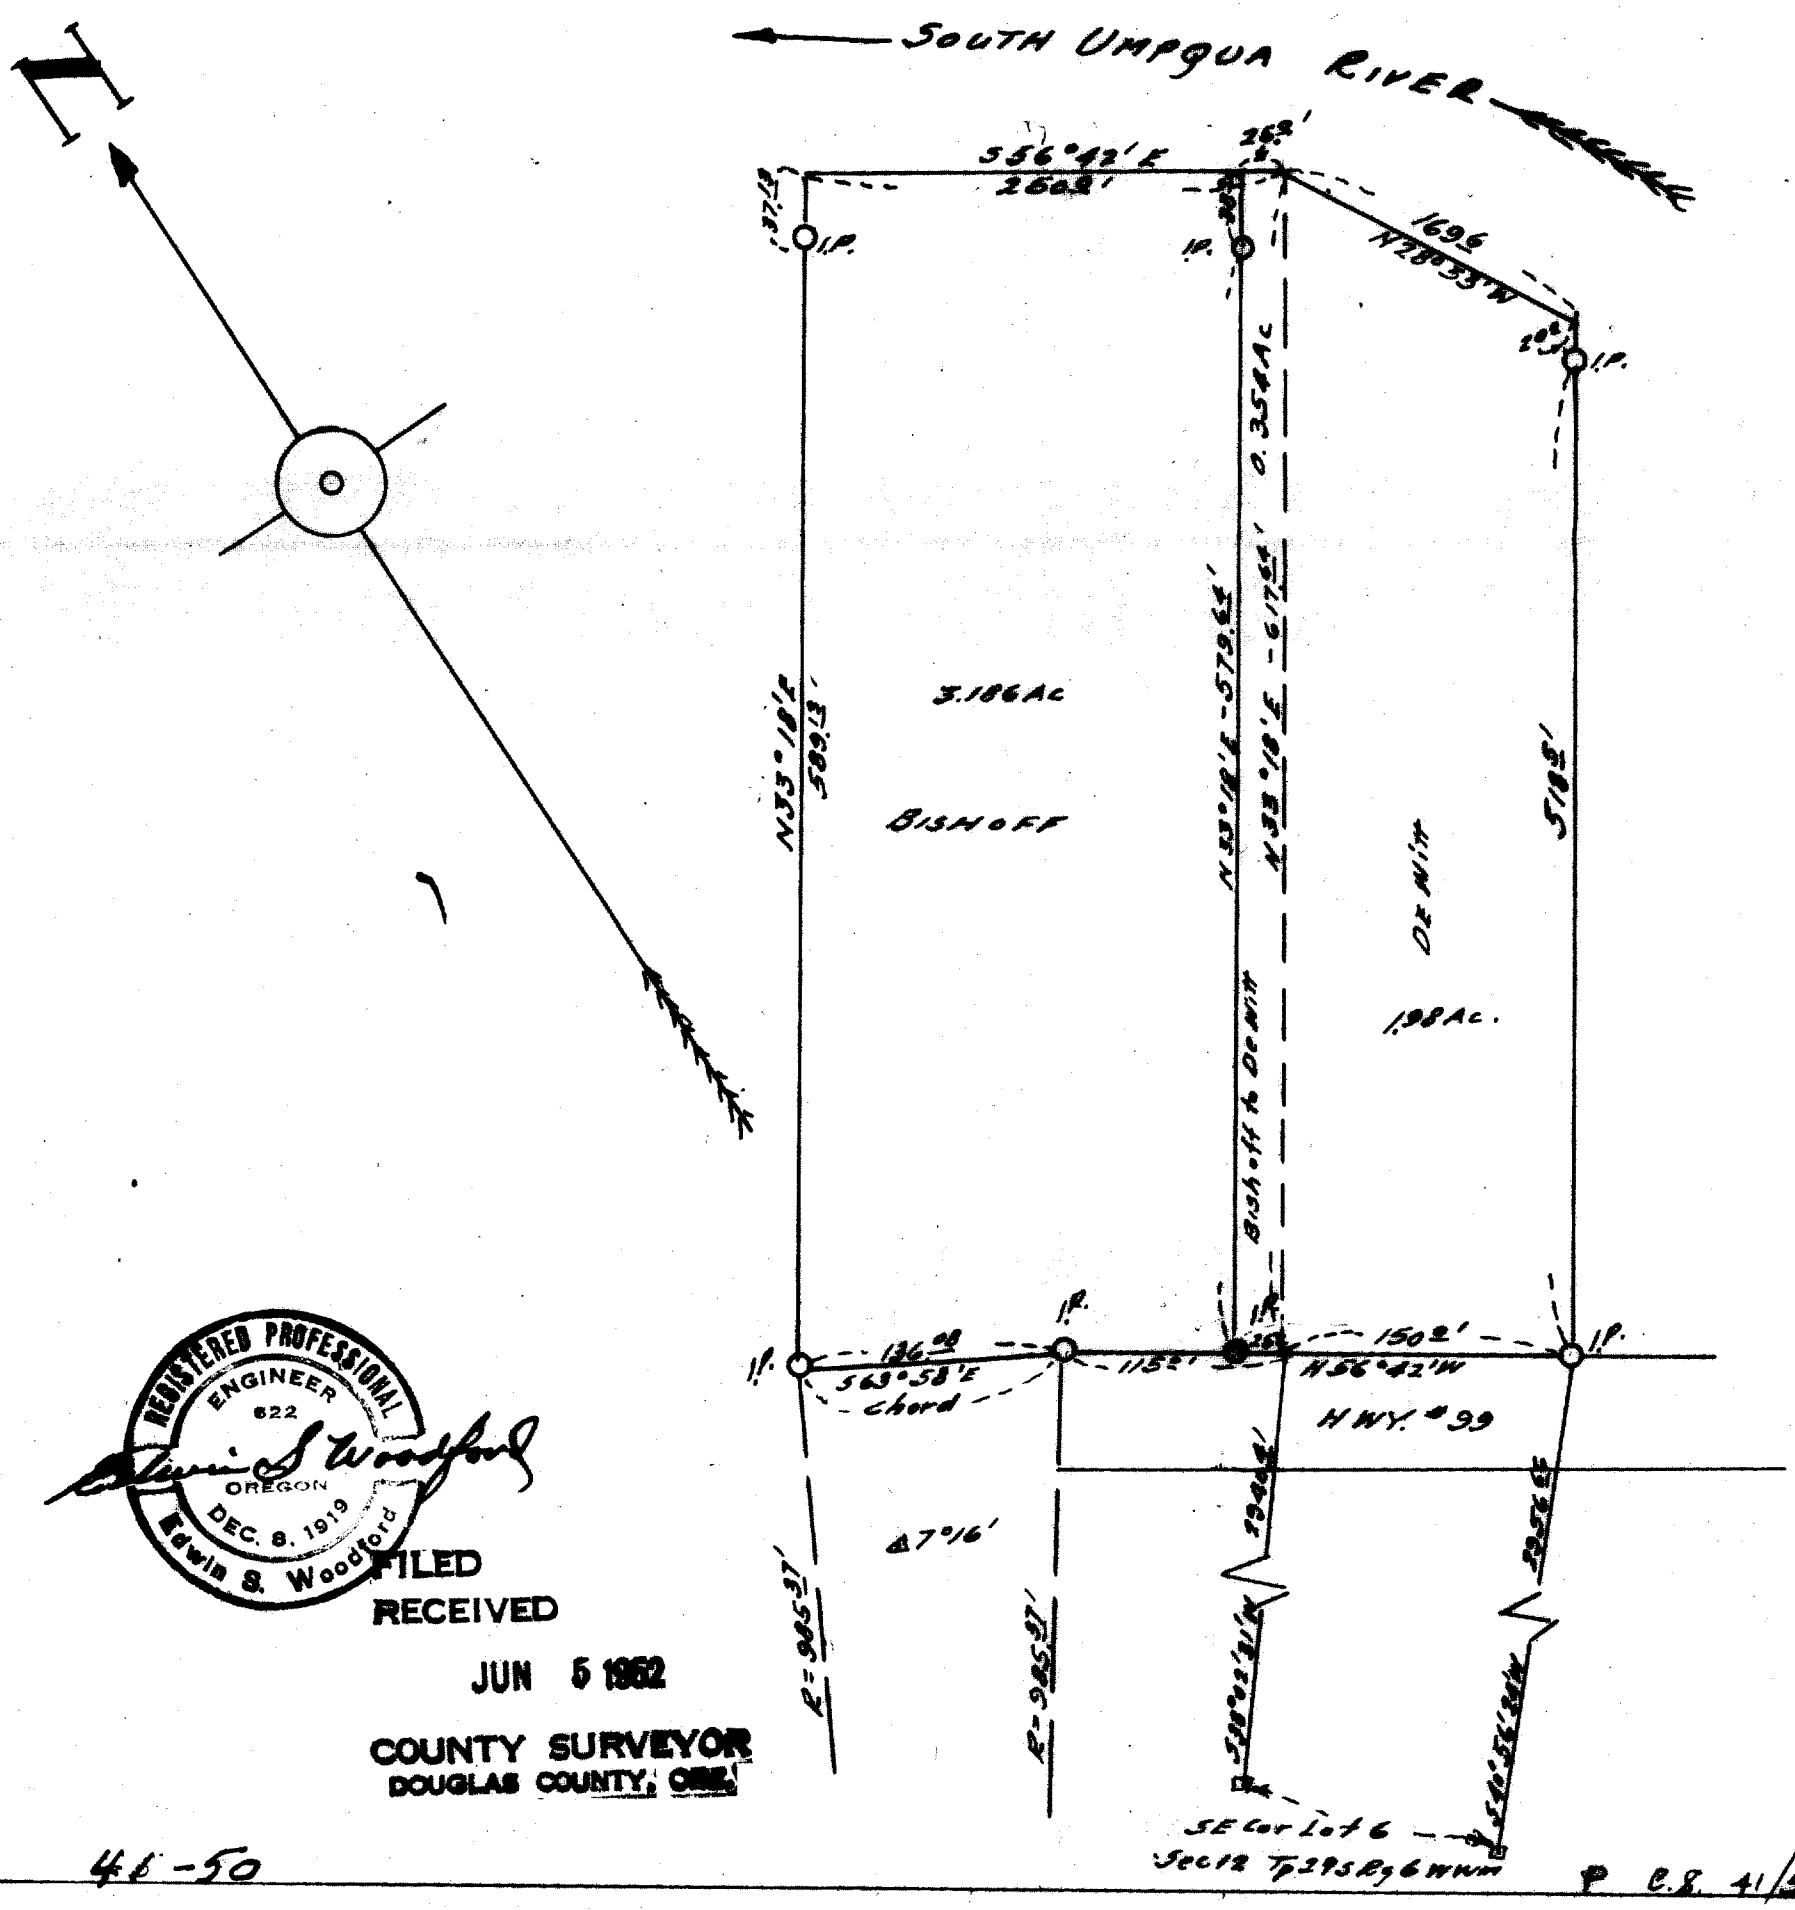

REGISTERED PROFESSIONAL ENGINEER 622 OREGON DEC. 8, 1919 Edwin S. Woodford

FILED
RECEIVED
JUN 5 1952
COUNTY SURVEYOR
DOUGLAS COUNTY, ORE.

46-50

P C.S. 41/50