


S 86° 38' W 2649.5
 N 86° 15' E 3525.0
 SW COR. WEST EXTEN.
 JOHN SCOTT DLC. #41

I, FRED L. DOW OF SUTHERLIN OREGON DO
 HEREBY CERTIFY THAT THIS MAP WAS MADE
 FROM NOTES TAKEN DURING AN ACTUAL
 SURVEY MADE BY ME ON NOV. 29, 1950 AND
 THAT THE MONUMENT SHOWN ON THIS MAP
 CONSISTING OF A 1" X 36" IRON PIPE IS SOUTH
 86° 38' W 2649.4 FEET FROM THE SW CORNER
 OF THE WEST EXTENSION OF THE JOHN
 SCOTT DLC. No. 41 IN SEC. 24, T. 22 S. R. 8 W. W.M.

Fred L. Dow

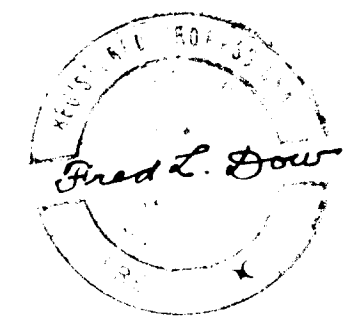

FRANK W. BINDER
ELKTON ORE

SCALE 1"=40'