


At Sec. Cor. I find 60" Fir, O.B.T.
 S56°W, 64 lks, properly marked.
 I renew corner by setting 3/4"
 iron pipe and establishing N.B.T.'s.
 8" Fir, S75°E, 105 ft, Mkd. T25 S,
 RTE, S 31-RE. 2741 B.T.
 8" Chinquapin, N47°E, 261 ft, Mkd.
 S 30, T25S, RTW. B.T.

Bearing shown is true and
 was established by a solar ob-
 servation taken during the course
 of this survey.

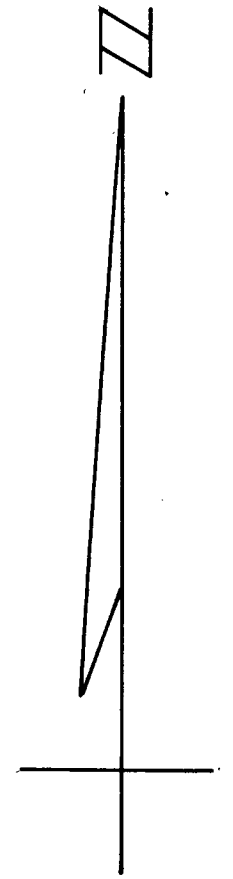

SCALE 1" = 600'

SURVEY TO ESTABLISH N. & S. PROP.
 LINE BETWEEN CLEVELAND AND
 WANDELL; AND BRIGGS AND LEONARD.
 LOCATED IN SEC. 31, T25S, RTW,
 AND SEC 36, T25S, RBW, WIL. MER.

GRANT & EVANS, ENGINEERS
 ROSEBURG, OREGON
 APRIL, 1952

**COUNTY SURVEYORS FILE DATA
 DO NOT REMOVE FROM OFFICE**

STATE OF OREGON)
COUNTY OF DOUGLAS) SS.

We, C. A. Cleveland, and Ollie B Cleveland, husband and wife;
Douglas M Briggs, and Leona A Briggs, husband and wife; Clifford Wandell,
a single man; L. C Leonard, and Thelma Leonard husband and wife, being
first duly sworn, do hereby covenant and agree:

That the boundary line running North and South between our respective
properties, located in Section 31, T. 25 S. R. 7 W., and in Section 36, T. 25 S,
R. 8 W. W.M., shall be that as surveyed and established by actual measurement
and by definition on the ground, by Arthur R. Evans, a registered professional
Engineer, duly qualified and authorized to practice land surveying under the laws
of the State of Oregon; Said Arthur R. Evans having been agreed upon by us as a
proper person to delineate the aforesaid boundary line.

In the event that the line between Section 31, T. 25 S., R. 7 W., and
Section 36, T. 25 S., R. 8 W. W.M., shall be established by the customary legal
method, the aforesaid boundary line, as established by the aforesaid engineer,
shall, in any case, forever remain the North and South boundary line between
our respective properties; and we further covenant and agree to bind our heirs
and assigns to strict observance of this agreement forever.

C. A. Cleveland
C. A. Cleveland

Ollie B Cleveland
Ollie B. Cleveland

Douglas M Briggs Leona A. Briggs
Douglas M. & Leona A. Briggs

Clifford Wandell
Clifford Wandell

L. C. Leonard
L. C. Leonard

Thelma Leonard
Thelma Leonard

STATE OF OREGON)
COUNTY OF DOUGLAS) SS.

Subscribed and Sworn to before me, a Notary Public, this 15th day of
July 1952.

My commission expires: June 25, 1956
Earl M. Callinson
Notary Public

C. S. File No. 41576