COUNTY SURVEYORS FILE DATA
DO NOT REMOVE FROM OFFICE

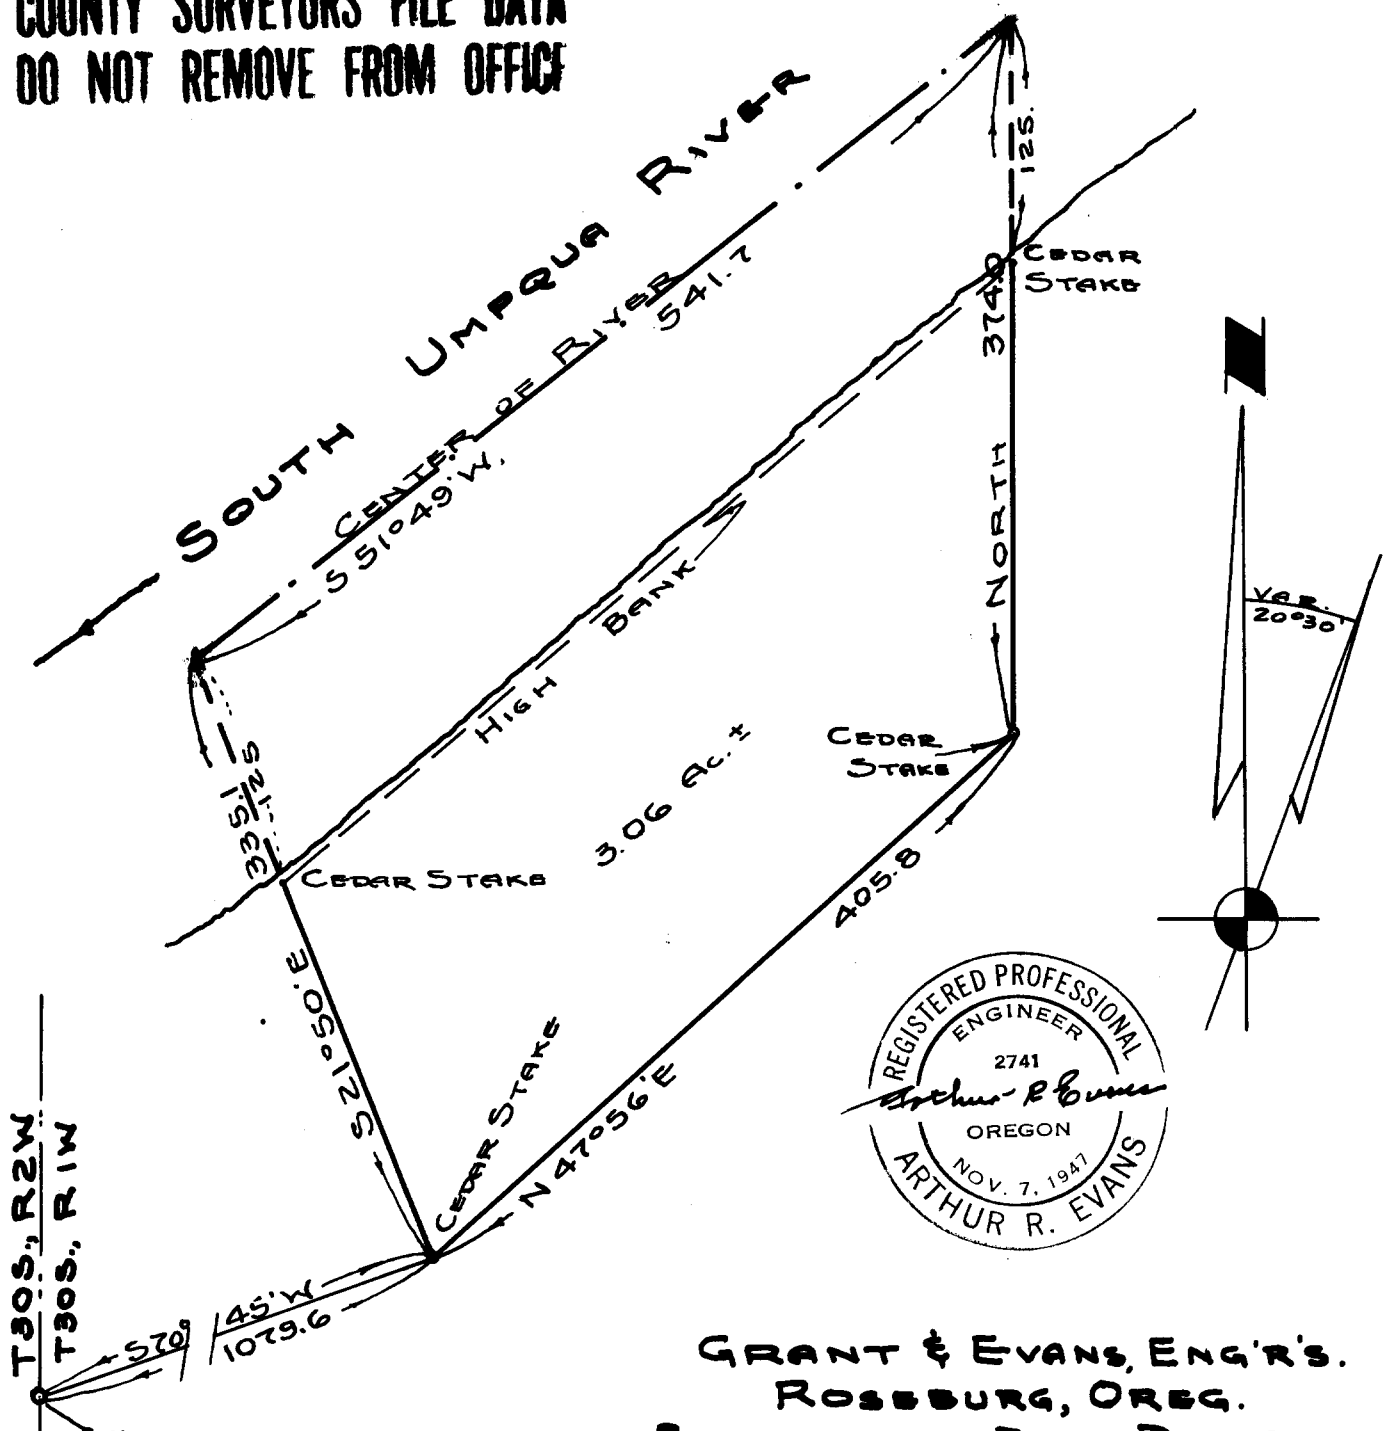

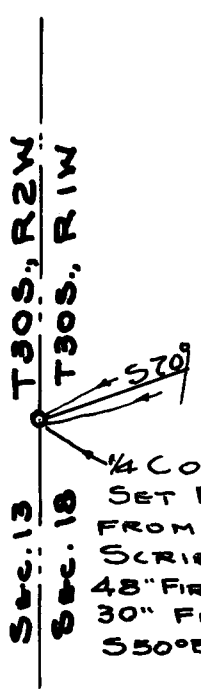

GRANT & EVANS, ENG'R'S.
ROSEBURG, OREG.
SURVEY FOR DEED DESCRIPTION
SECTION 18, T30S., R1W, WM.
DOUGLAS COUNTY, ORE.

SURVEYED, NOVEMBER, 1951, BY
A.R EVANS, REG. PROF. ENGINEER
SCALE 1" = 100'

FILED
RECEIVED
DEC 13 1951
COUNTY SURVEYOR
DOUGLAS COUNTY, ORE.

C. S. File No. 41/66

P 394