COUNTY SURVEYORS FILE DATA
DO NOT REMOVE FROM OFFICE

SURVEY TO ESTABLISH THE E² OF THE NORTH LINE OF SECTION 12, T23S., R10W, WM. DOUGLAS COUNTY, OREGON

GRANT & EVANS, ENGINEERS
ROSEBURG, OREGON
SURVEYED, FEB. 4-5-6, 1952, BY
A.R. EVANS, REG. PROF. ENG'R.
SCALE 1" = 400'

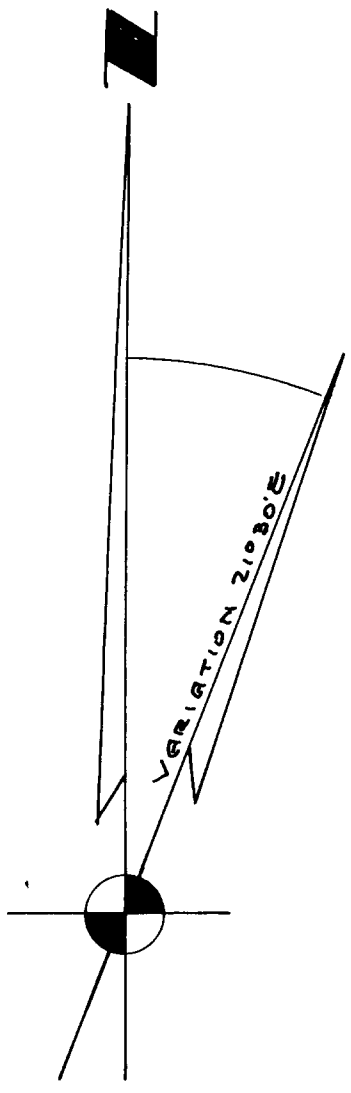

SECTION 1

SEC. 6

CLOSING COR. SECS. 6 & 7, T23S, R9W
FD. FIR B.T. N 38½°E, 16 LKS.
SET 4" x 4" x 36" FIR STAKE.
BLAZE & SCRIBE N.B.T.
8" FIR, S 42°E, 28 FT.
MKD C.C. S 7, T 23, R 9, R.E. 27.41, B.T.

T23S., R10W.

S0°20'W, 2459.0

T23S., R9W

SECTION 7

¼ COR, SECS. 1 & 12, T23S, R10W
FD O.B.T. 4 LAUREL, N 10°W, 25 LKS.
MARKED CROSS ON ROCK IN PLACE
FOR CORNER. BL. & SCR. N.B.T.'S.
14" FIR, S 25°W, 22½ FT. MKD. ¼ S, 12, BT.
24" FIR N 60°E, 27½ FT. " ¼ S-1 BT.

SEC. COR, 1 & 12, T23S, R10W, FD. O.B.T.
LAUREL, N 20°W, 45 LKS. SET 4"X4"X36"
FIR STAKE FOR COR. BL. & SCR. N.B.T.'s.
24" FIR, S 72°W, 21½ FT. MKD, S 12, T23S. R10, BT.
12" FIR, N 10°W, 31½ FT. " S-1, T23, R10, BT.

S87°58'W, 2565.3

SECTION 12

41 1