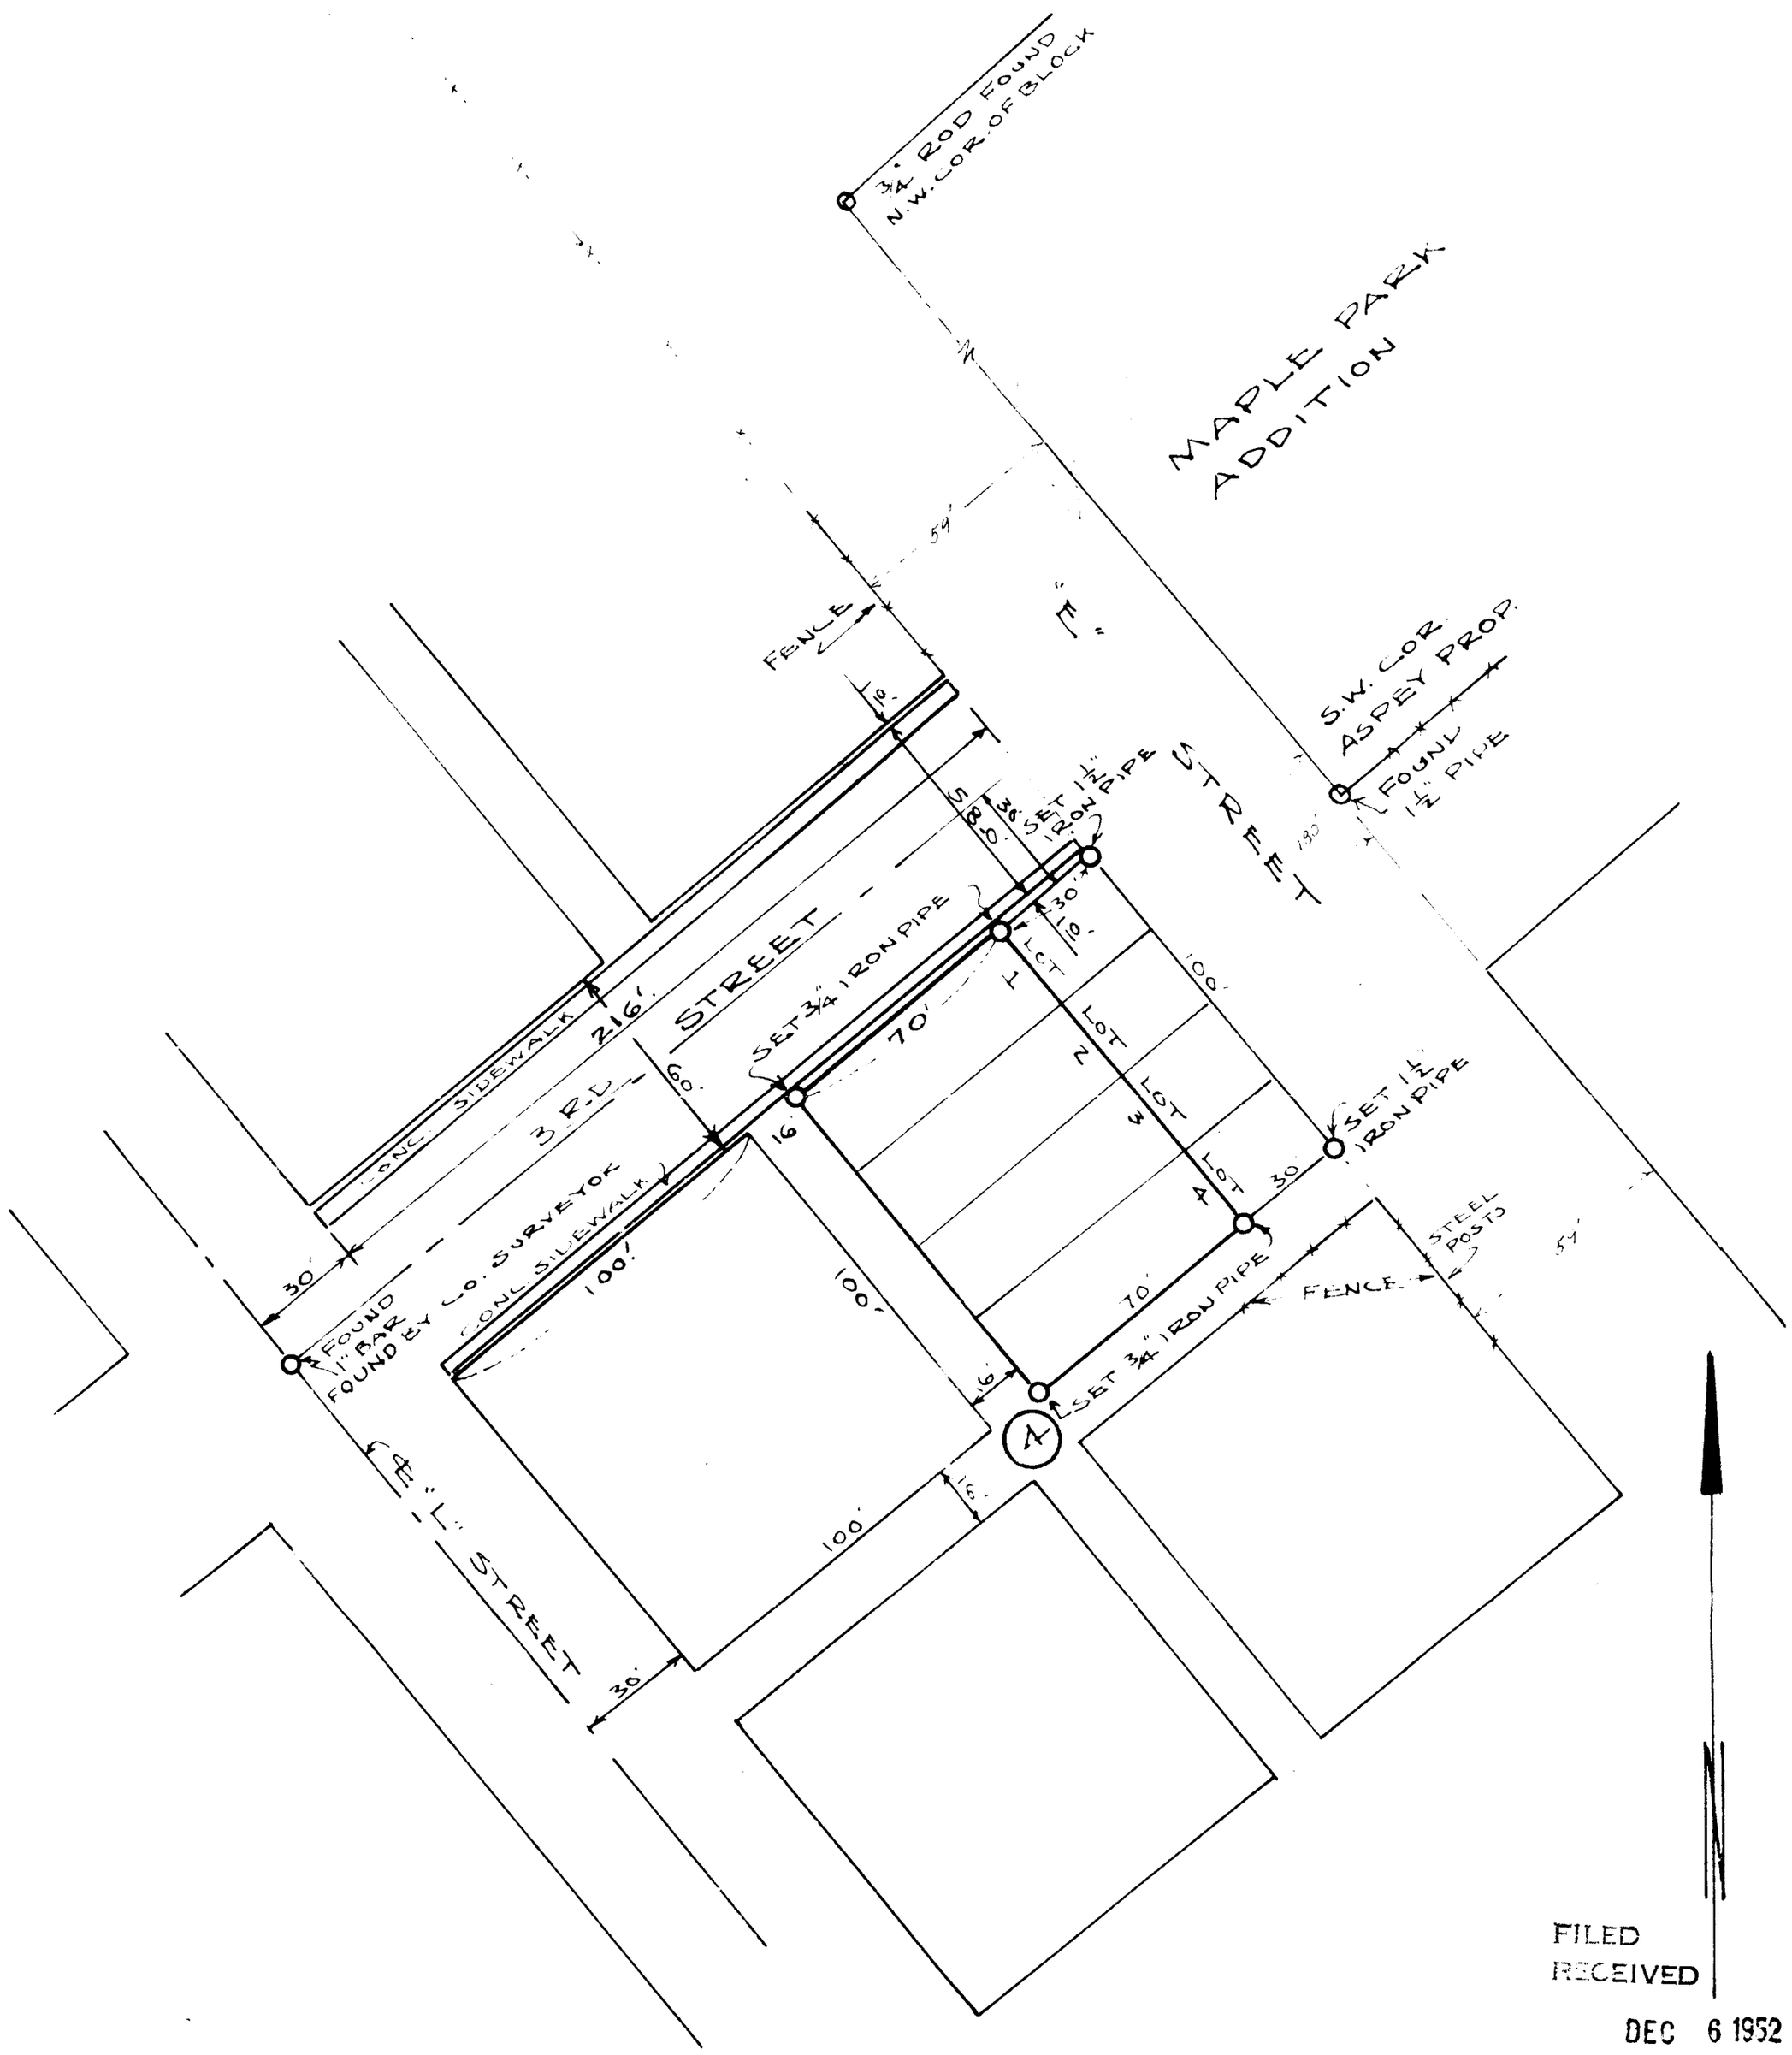

FILED
RECEIVED
DEC 6 1952
COUNTY SURVEYOR
DOUGLAS COUNTY, ORE.

J. L. AIKINS PROPERTY
THE SOUTHWESTERLY 70 FT.
OF LOTS 1, 2, 3, 4 OF BLOCK 4
OF ORIGINAL PLAT-RIDDLE
DOUGLAS COUNTY, ORE.
DEC. 1952 SCALE 1" = 40'

COUNTY SURVEYORS FILE DATA
DO NOT REMOVE FROM OFFICE