COUNTY SURVEYORS FILE DATA
DO NOT REMOVE FROM OFFICE

FILED
RECEIVED
DEC 17 1952
COUNTY SURVEYOR
DOUGLAS COUNTY, OREG.

MAP OF D.R. FRANKLIN PROPERTY IN

SECTION 28 TP. 28 S-R6 7W WM.

Scale-1"=40'. Dec. 11 1952.
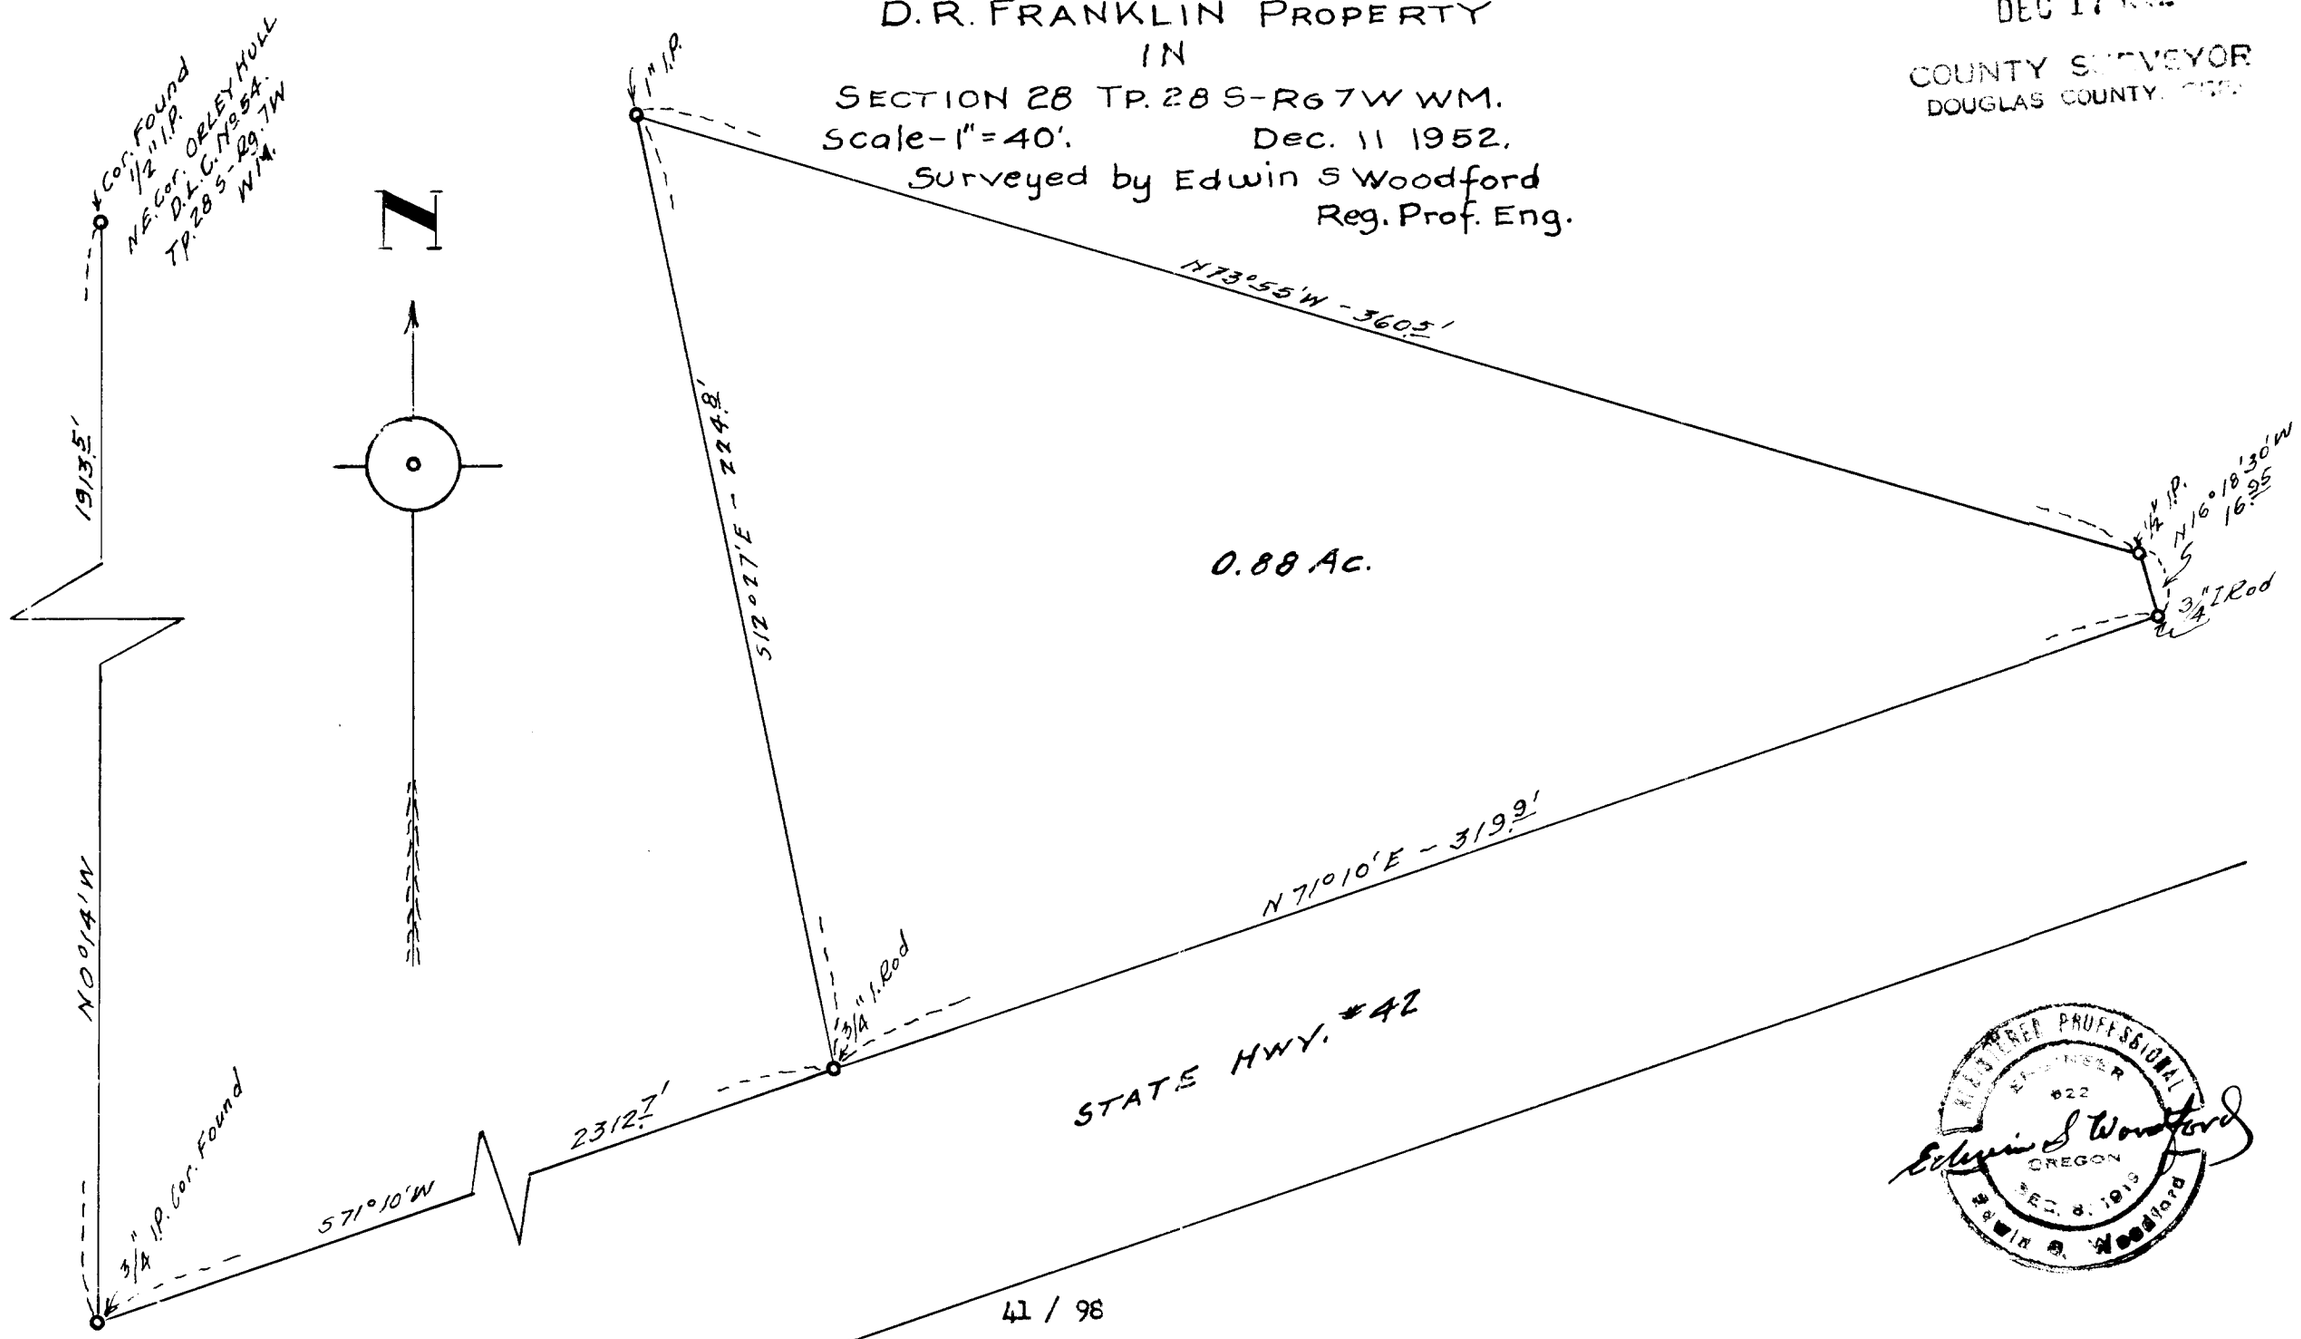
Surveyed by Edwin S Woodford
Reg. Prof. Eng.