COUNTY SURVEYORS FILE DATA
DO NOT REMOVE FROM FILE

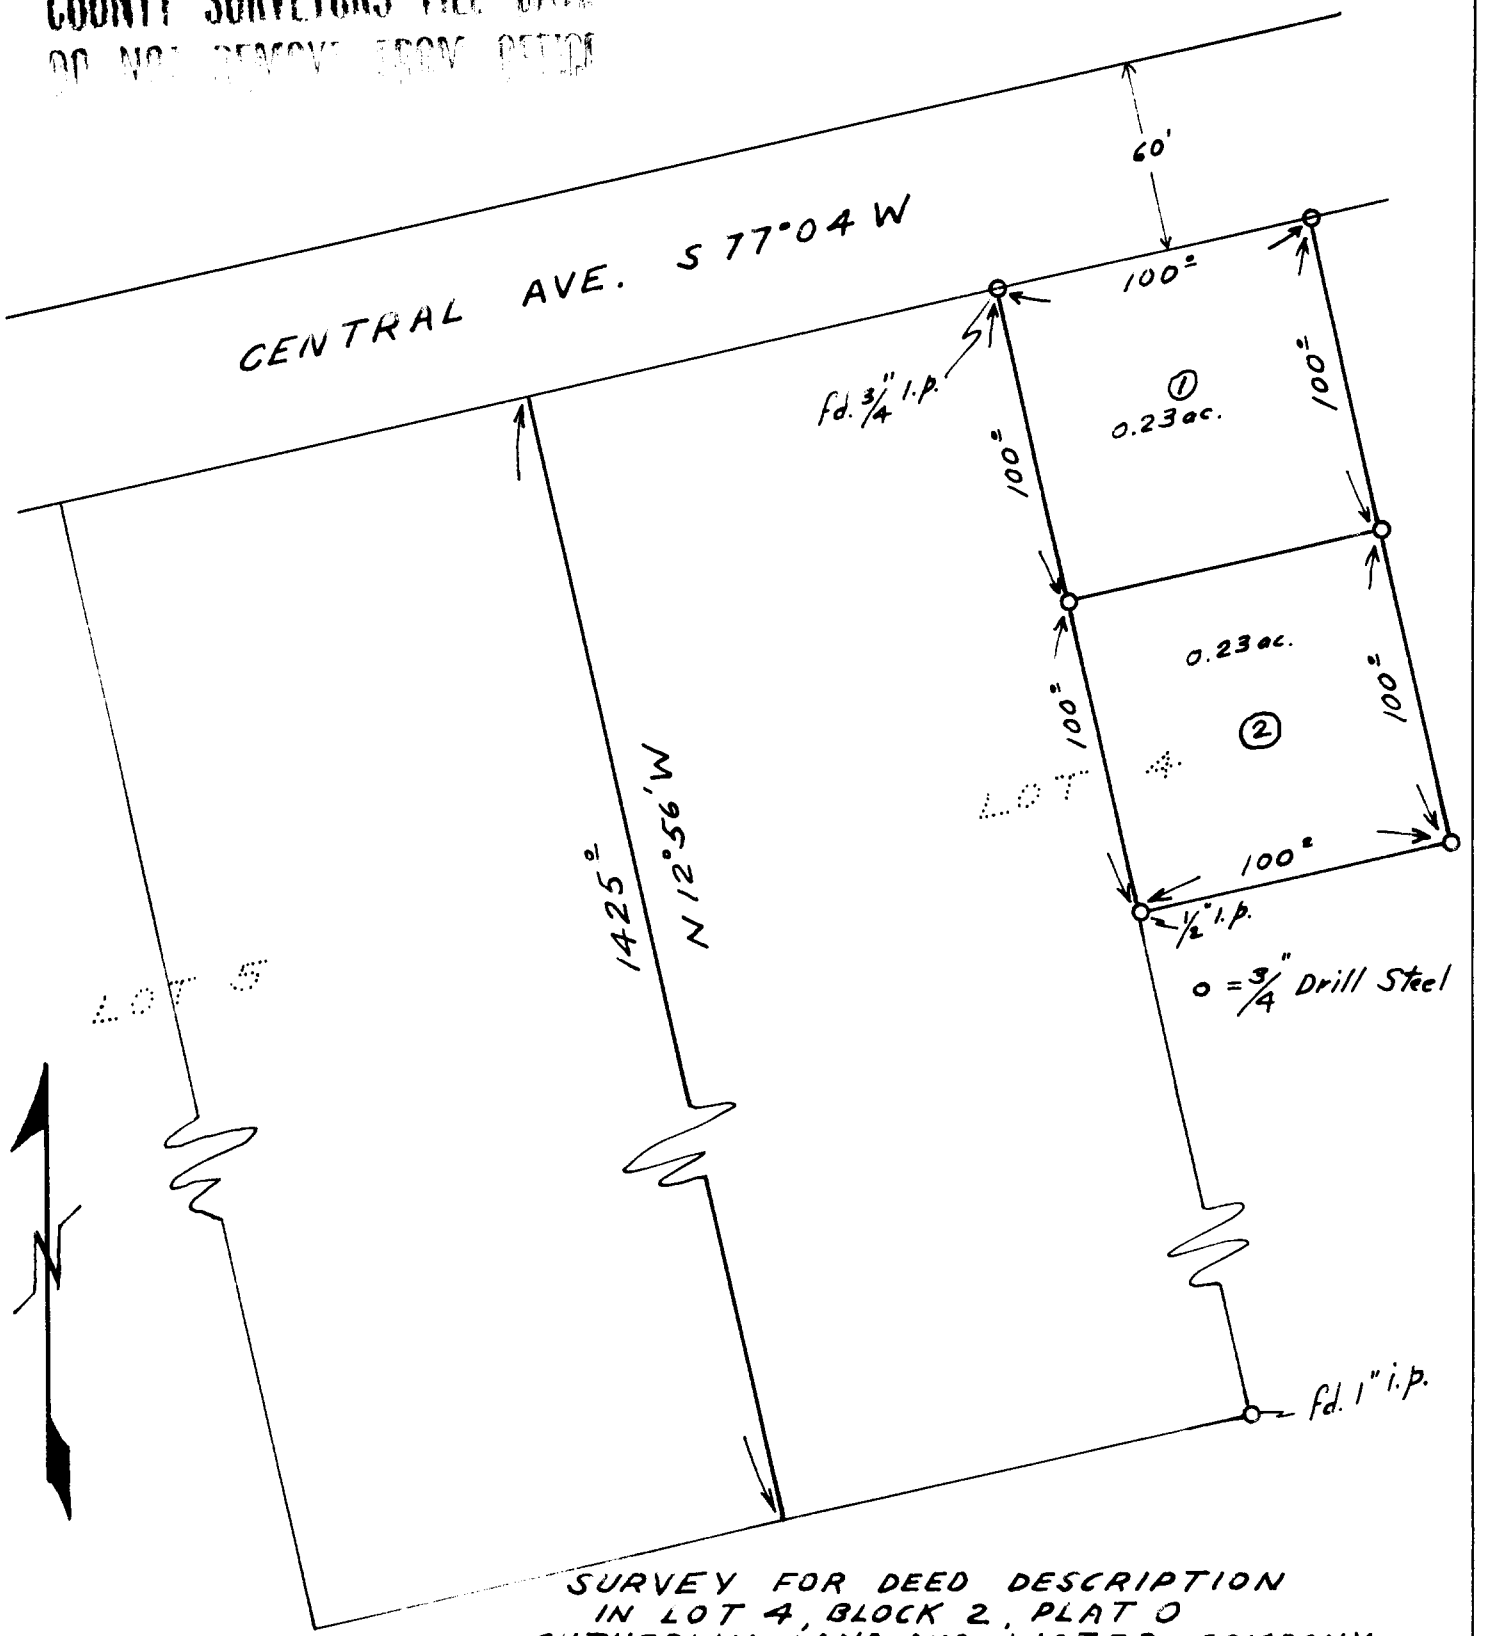

SURVEY FOR DEED DESCRIPTION
IN LOT 4, BLOCK 2, PLAT O
SUTHERLIN LAND AND WATER COMPANY
Sec. 17 & 20, T 25 S, R 5 W, W.M.

Richard C. Grant

GRANT & EVANS, ENGR.
ROSEBURG, OREG. JAN. 8, 1953
Scale: 1" = 60'

C. S. File No. 41/108