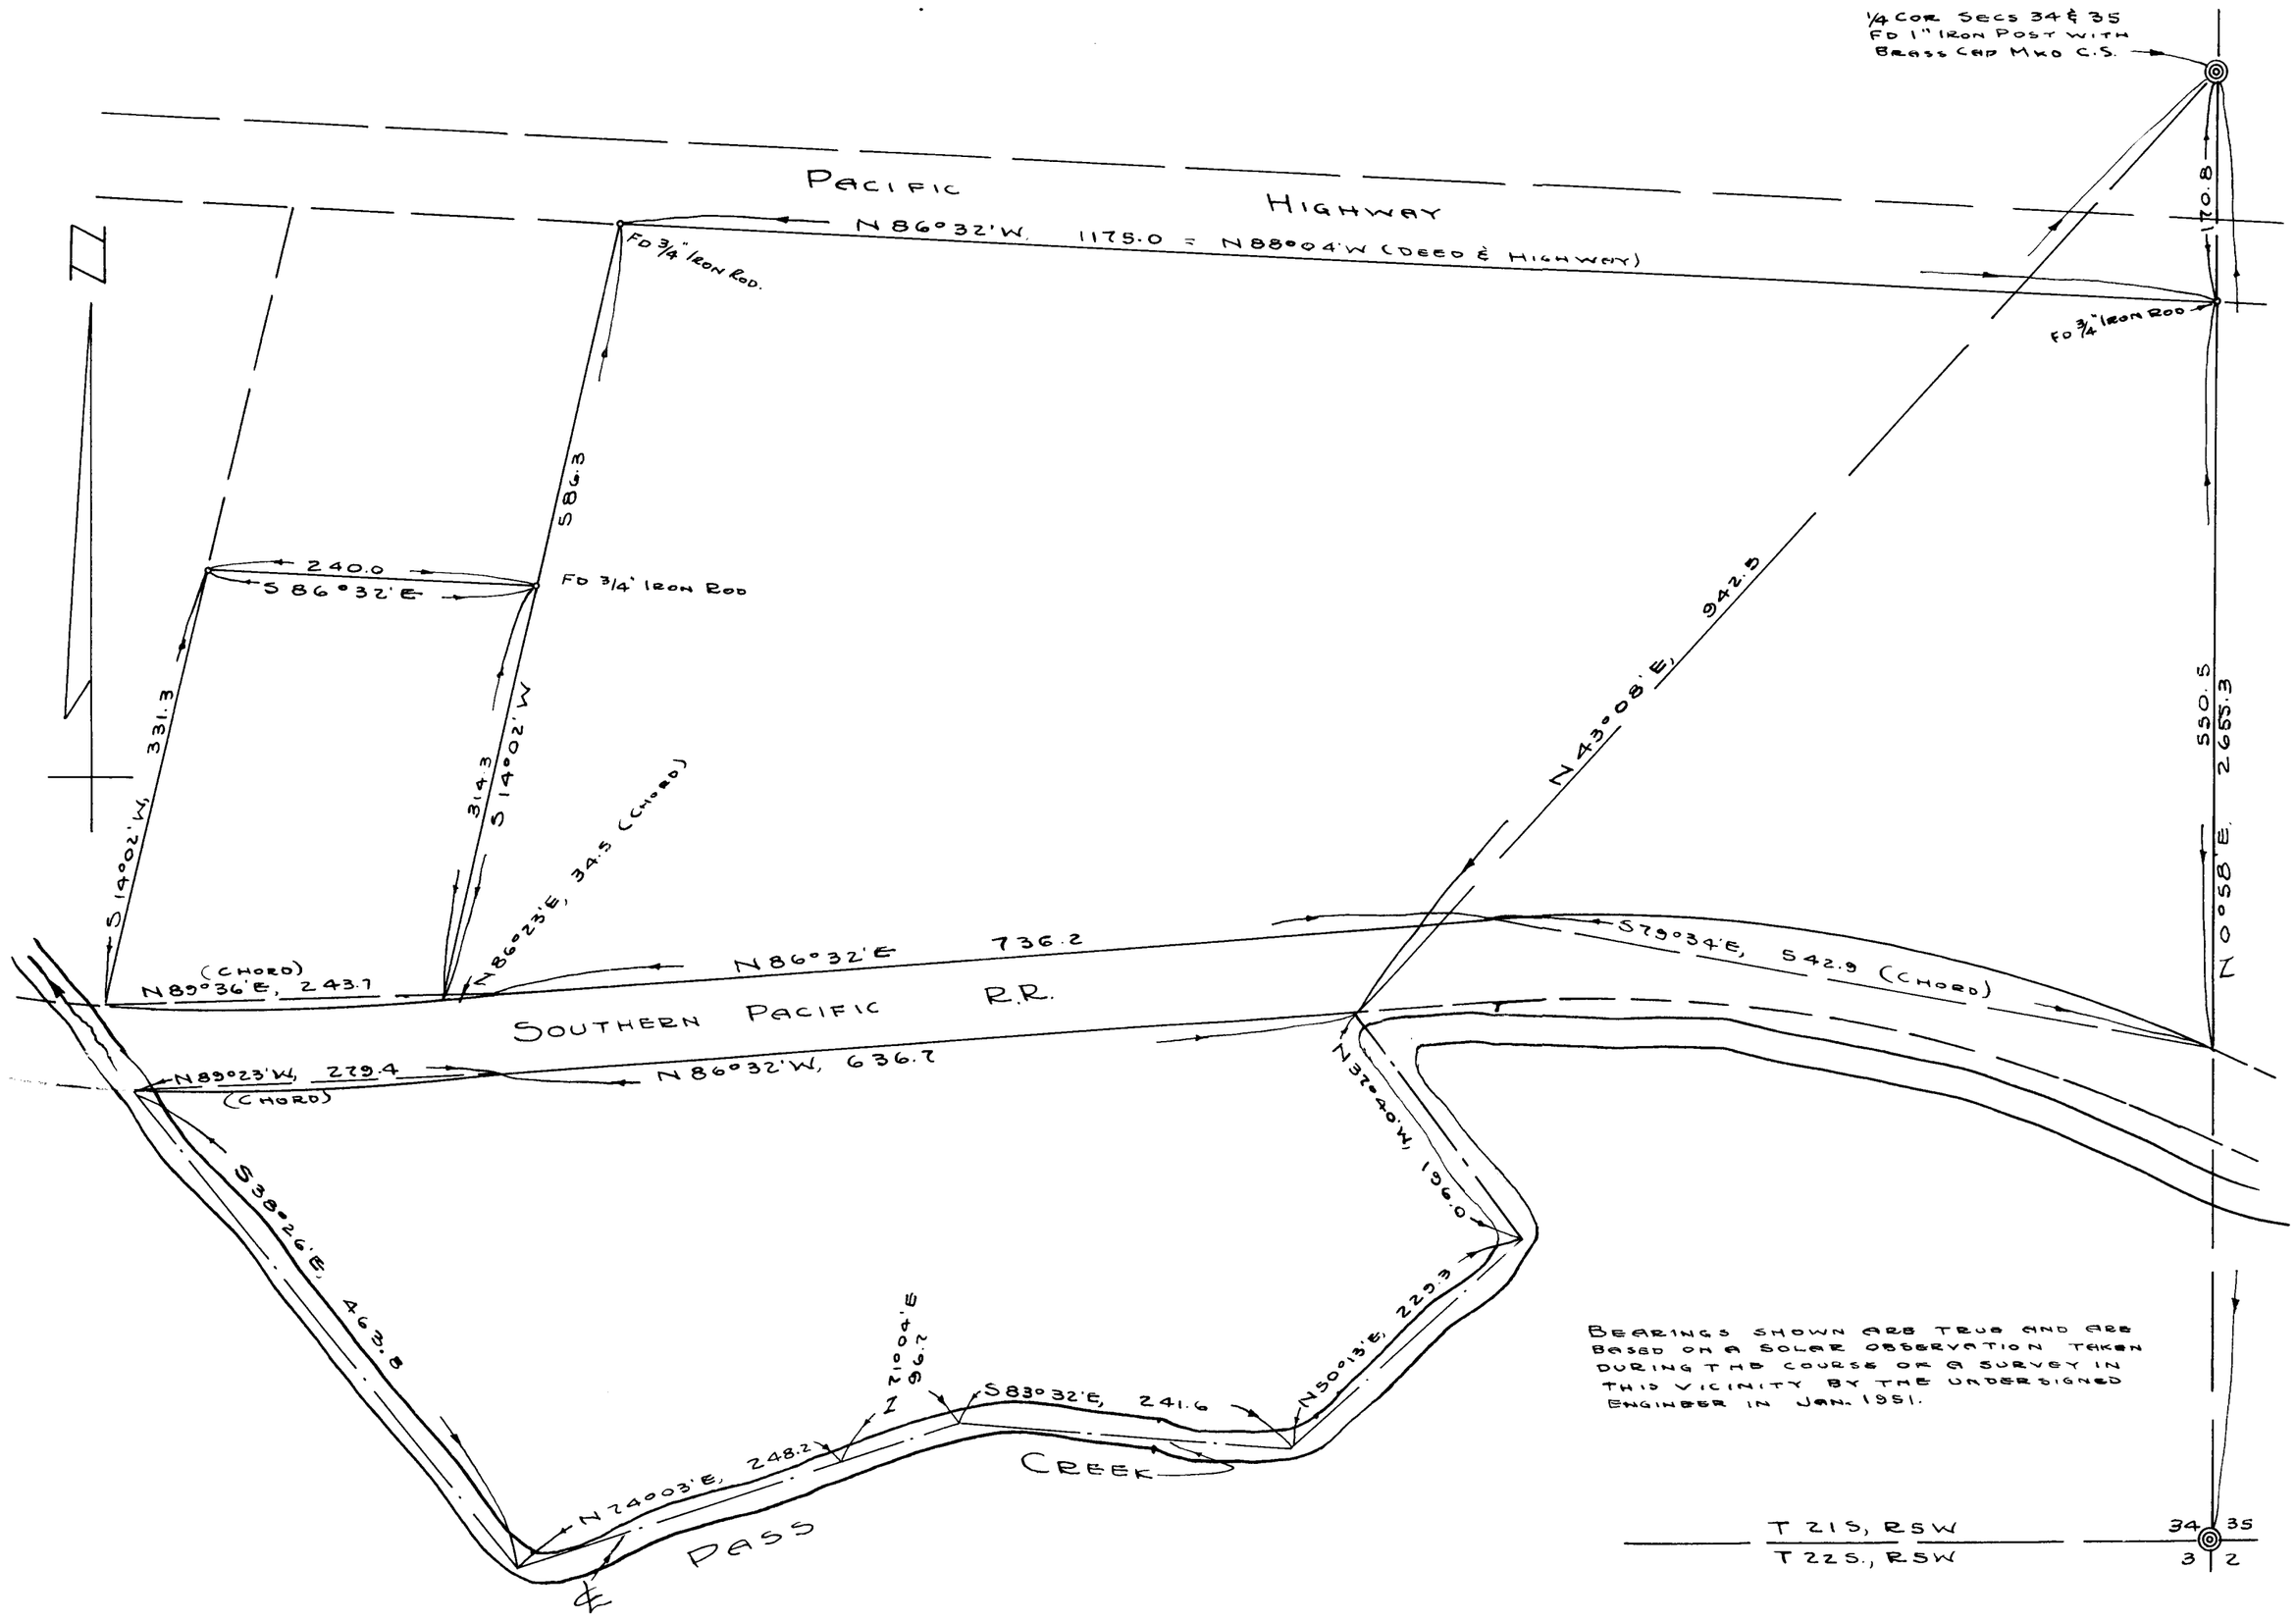

SURVEY FOR DEED DESCRIPTIONS
IN THE S.E.4 SEC. 34, T21S, R5W, W.M.
DOUGLAS COUNTY OREGON

Arthur R. Evans

GRANT AND EVANS ENGINEERS
ROSEBURG, OREGON
SURVEYED JAN. 1953 SCALE 1" = 100'

FILED
RECEIVED
FEB 2 1 1953
COUNTY SURVEYOR
DOUGLAS COUNTY, ORE.

COUNTY SURVEYORS FILE DATA
DO NOT REMOVE FROM OFFICE

41-122

C.S. 41/122